

MECHANICAL SYMBOLS AND ABBREVIATIONS					
SYMBOL	DESCRIPTION	SYMBOL	DESCRIPTION	SYMBOL	DESCRIPTION
			MANUAL DAMPER	AFF	ABOVE FINISHED FLOOR
			SUPPLY DUCT SECTION	AHU	AIR HANDLING UNIT
—CHS—	CHILLED WATER SUPPLY		EXHAUST RETURN OR OUTSIDE AIR DUCT SECTION	AFMS	AIR FLOW MEASURING STATION
—CHR—	CHILLED WATER RETURN		ROUND DUCT SIZE, MILLIMETERS	CHP	CHILLED WATER PUMP
			RECTANGULAR DUCT SIZE (FIRST DIM. IS SIDE VIEWED)	°C	DEGREES CELSIUS
—G—	NATURAL GAS		ELBOW UP, (SUPPLY)	DB/WB	DRY BULB/WET BULB
—HWS—	HEATING HOT WATER SUPPLY		ELBOW DOWN, (SUPPLY)	DDC	DIRECT DIGITAL CONTROL
—HWR—	HEATING HOT WATER RETURN		ELBOW W/TURNING VANES	DHW	DOMESTIC HOT WATER
			FLEXIBLE CONNECTION	DHX	DOMESTIC HOT WATER HEAT EXCHANGER
—>	ELBOW TURNING DOWN		THERMOMETER	EA	EXHAUST AIR
—o	ELBOW TURNING UP		PRESSURE GAUGE	EAT	ENTERING AIR TEMPERATURE
	GATE VALVE		DIRECTION OF FLOW	EF	EXHAUST FAN
	CHECK VALVE		Y STRAINER WITH BLOW-OFF VALVE	ESP	EXTERNAL STATIC PRESSURE
	GLOBE VALVE		PRESSURE RELIEF VALVE	ER	EXHAUST REGISTER
	BALANCING VALVE		PRESSURE REGULATING/REDUCING VALVE	ET	EXPANSION TANK
	FLEXIBLE CONNECTION		THERMOSTAT	EWT	ENTERING WATER TEMPERATURE
	3-WAY CONTROL VALVE		FIRESTAT	FD	FIRE DAMPER
	2-WAY CONTROL VALVE		MANUAL AIR VENT	HWP	HOT WATER PUMP
	UNION CONNECTION		SUPPLY DIFFUSER, TYPE D1, 200 L/s (REFER TO DIFFUSER SCHEDULE)	KPa	KILOPASCALS (PRESSURE)
	FLANGE CONNECTION		RETURN OR EXHAUST REGISTER, TYPE R1, 200 L/s (REFER TO DIFFUSER SCHEDULE)	KW	KILOWATTS (HEAT FLOW RATE)
----FD	FIRE DAMPER			LAT	LEAVING AIR TEMPERATURE
---MOD	MOTORIZED DAMPER			LWT	LEAVING WATER TEMPERATURE
				L/s	LITERS PER SECOND
				MOD	MOTOR OPERATED DAMPER
				MVD	MANUAL AIR VOLUME DAMPER
				MER	MECHANICAL EQUIPMENT ROOM
				MAX	MAXIMUM
				MIN	MINIMUM
				OA	OUTSIDE AIR
				OBD	MANUAL VOLUME DAMPER
				Pd	PASCALS (PRESSURE)
				PD	PRESSURE DROP
				PLTD	PLEATED
				PRV	PRESSURE REDUCING VALVE
				RA	RETURN AIR
				RAR	RETURN AIR REGISTER
				RD	RELIEF AIR DAMPER
				RF	RELIEF FAN
				RH	RELIEF HOOD
				SA	SUPPLY AIR
				TA	THROW AWAY
				TEMP	TEMPERATURE
				T'STAT	THERMOSTAT
				UH	UNIT HEATER
				VAV	VARIABLE AIR VOLUME
				WC	WATER COLUMN
				w.g.	WATER GAUGE

HVAC PUMP SCHEDULE 							
SYMBOL	L/s	TOTAL HEAD kPa	FLUID TEMP °C	MAXIMUM WATTS	SERVICE (MIN) EFFICIENCY	TYPE	REMARKS
CWP-1	15.5	195	7° TO 93°	5500	40%	END SECTION	
HWP-1	5.7	85	7° TO 93°	1100	40%	END SECTION	

HVAC BOILER SCHEDULE							
SYMBOL	CAPACITY KW	L/s	ENT/LVG TEMP °C	STACK SIZE	SERVICE (MIN) EFFICIENCY	TYPE	REMARKS
BLR-1	175	5.7	71.1° /80.0°	350 mm	80%	FORCED-DRAFT, NAT GAS	

AIR HANDLING UNIT SCHEDULE				
FAN	SYMBOL	AHU-1	AHU-2	MZ-1
	SERVICE			
	LOCATION	KITCHEN	SERVERY	DINING
	SYSTEM TYPE	SINGLE ZONE	SINGLE ZONE	MULTI-ZONE
	TOTAL AIR VOLUME L/s	3350	2925	4065 *
	D.A. L/s	1660	900	2600
	TOTAL E.S.P.	750 Pa	780 Pa	920 Pa
	REMARKS			
COOLING COIL	TOTAL LOAD kW	66.8	91.0	157.5
	SENSIBLE LOAD kW	51.2	60.7	97.3
	EAT (DB/WB)	32.0/22.9	29.1/21.0	30.9/22.2
	LAT (DB/WB)	18.1/17.4	12.5/12.4	11.3/11.2
	EWL-LWT	7.0/12.6	7.0/12.6	7.0/12.6
	WATER FLOW L/s	3.3	4.5	7.7
	MAX. FACE VEL. m/s	2.7	2.7	2.7
HEATING COIL	TOTAL LOAD kW	80.8	69.8	89.0
	EAT	13.9	16.4	12.8
	LAT	32.9	35.8	30.6
	EWL-LWT	82.2/71.1	82.2/71.1	82.2/71.1
	WATER FLOW L/s	1.6	1.5	1.9
	MAX. FACE VEL.	3.7	3.3	3.1
PREHEAT COIL	TOTAL LOAD kW	NOT USED	NOT USED	31.0
	EAT	NOT USED	NOT USED	6.6
	LAT	NOT USED	NOT USED	12.8
	EWL-LWT	NOT USED	NOT USED	82.2/71.1
	WATER FLOW L/s	NOT USED	NOT USED	0.6
	MAX. FACE VEL.	NOT USED	NOT USED	2.8
FILTER	PRE-FILTER TYPE	50 mm TA	50 mm TA	50 mm TA
	MAX. FACE VEL. m/s	1.5	1.5	1.5
	PERCENT EFFICIENCY	25 TO 30%	25 TO 30%	25 TO 30%
	FINAL FILTER TYPE	H.P. **	H.P. **	H.P. **
	MAX. FACE VEL.	---	---	---
	MAX. P. D. CLEAN	100 Pa	100 Pa	100 Pa
	REMARKS			

SYMBOL		MAU-1 & MAU-2	MAU-3 & MAU-4	MAU-5
FAN	TOTAL AIR L/s	3220	1330	660
	OUTSIDE AIR L/s	3220	1330	660
	EXTERNAL S.P. Pa	365	365	175
INDIRECT GAS FIRED HEATING SECTION	AIR FLOW, L/s	3220	1330	660
	ENTERING AIR D.B. °C	-7	-7	-7
	HEAT OUTPUT, kW	163.0	113.7	39.85
	GAS CONSUMPTION, kW	102.1	152.0	53.0
FILTER TYPE		35% EFF. DISPOSABLE	35% EFF. DISPOSABLE	35% EFF. DISPOSABLE
MIN FAN kW		3.7	1.1	0.5
ELECTRICAL		208V/3 PHASE	208V/3 PHASE	208V/3 PHASE
REMARKS		SEE NOTES	SEE NOTES	SEE NOTES

NOMINAL PIPE SIZE (INCHES)	METRIC IDENTIFICATION MILLIMETER (mm)	NOMINAL PIPE SIZE (INCHES)	METRIC IDENTIFICATION MILLIMETER (mm)
1/8	6	8	200
3/16	7	10	250
1/4	8	12	300
3/8	10	14	350
1/2	15	16	400
5/8	18	18	450
3/4	20	20	500
1	25	24	600
1-1/4	32	28	700
1-1/2	40	30	750
2	50	32	800
2-1/2	65	36	900
3	80	40	1000
3-1/2	90	44	1100
4	100	48	1200
4-1/2	115	52	1300
5	125	56	1400
6	150	60	1500

 US ARMY CORPS OF ENGINEERS SAVANNAH DISTRICT		DESIGNED BY:	
DATE: 14 JUL 97	REV.		
CATEGORY CODE		SUBMITTED BY:	
721-11-11			
SOLICITATION NO: DAC21-97-B-0055		CHIEF:	
U.S. ARMY ENGINEER DISTRICT FORT BENNING, GEORGIA		RECOMMENDED:	
SAVANNAH, GEORGIA		PLOT DATE: \$DATE\$	
		PLOT SCALE: 1" = 100'	

AS BUILT	30SEP04	DGC
GENERAL REVISIONS	30 JUL 97	SWM
		

RANGER BARRACKS COMPLEX FORT BENNING, GEORGIA	DINING FACILITY MECHANICAL LEGEND
--	--------------------------------------

PLATE REFERENCE NUMBER:	M-1
-------------------------------	-----

SHEET 323

1. USE HUB TYPE PIPE WITH HANGERS PLACED WITHIN 150mm OF EACH JOINT FOR SANITARY SEWER AND GREASE LAIDEN SANITARY SEWER PIPING.
2. ALL FLOOR MOUNTED EQUIPMENT IN MECHANICAL ROOMS SHALL BE MOUNTED ON 150mm HIGH HOUSEKEEPING PADS. THESE PADS SHALL EXTEND 150 mm BEYOND THE EQUIPMENT IN ALL DIRECTIONS.
3. NO PIPING SHALL PENETRATE STRUCTURAL MEMBERS.
4. NO CHANGES IN DIRECTION GREATER THAN 45° SHALL BE USED ON THE WASTE PULPING SYSTEM.
5. WALL CLEANOUT COVER COLOR SHALL MATCH ADJACENT SURFACES.
6. ALL ROOF MOUNTED EQUIPMENT SHALL BE INSTALLED ON CURBS PROVIDED BY THE EQUIPMENT MANURFACTURER.
7. HIGH EFFICIENCY MOTORS ARE REQUIRED IN THIS PROJECT. SEE SPECIFICATION 16415 FOR SPECIFIC REQUIREMENTS.
8. ALL EXPOSED PIPING SHALL BE CHROMIUM-PLATED IN ACCORDANCE WITH THE PARAGRAPH "FIXTURES" IN SPECIFICATION SECTIION 15400. FIXTURES SHALL INCLUDE ALL DEVICES WITH SUPPLY OR WASTE CONNECTIONS SPECIFIED WITHIN SPECIFICATION SECTIONS 11400 AND 15400. EXPOSED PIPING SHALL BE DEFINED AS PIPING BETWEEN THE CRAWL SPACE OR FLOOR PENETRATION AND THE FIXTURE. PIPING WITHIN THE MANUFACTURER'S STANDARD CABINET DOES NOT REQUIRE CHROMIUM-PLATING. PIPING UNDER TABLES SHALL BE CONSIDERED TO BE EXPOSED. IN LIEU OF CHROMIUM PLATING, STAINLESS STEEL PIPING IS ACCEPTABLE FOR KITCHEN EQUIPMENT IN ACCORDANCE WITH SPECIFICATION SECTION 11400.
9. ALL PIPING FOR KITCHEN EQUIPMENT SHALL BE IN ACCORDANCE WITH SPECIFICATION SECTIONS 15400 AND 15488.
10. ALL EXTERIOR EQUIPMENT AND METALS SHALL BE FACTORY FINISHED TO EQUAL ARCHITECTURAL METALS IN SPECIFICATION SECTION 09900.
11. INSTALL FLEXIBLE CONNECTIONS ON ALL DUCT CONNECTIONS TO AIR HANDLING UNITS AND MAKE-UP AIR UNITS. SEE DETAIL 10, SHEET M-9.
12. NO PLASTIC PIPING SHALL BE USED IN THE DINING FACILITY.

DIFFUSER, REGISTER, AND GRILLE SCHEDULE 						
SYMBOL	DESCRIPTION	SIZE mm (NECK)	VOL L/s	THROW m	MAX NC	REMARKS
D-1	SUPPLY DIFFUSER	200	125	2.0	40	2, 3, 4
D-2	SUPPLY DIFFUSER	200	150	3.25	40	2, 3, 5
D-3	SUPPLY DIFFUSER	250	250	2.5	40	2, 3, 4
D-4	SUPPLY TROFFER	150	80	2.0	35	2
D-5	SUPPLY DIFFUSER	200	115	3.0	40	2, 4, 6, 7
D-6	SUPPLY DIFFUSER	200	65	2.0	40	2, 3, 4
D-7	SUPPLY DIFFUSER	200	100	2.0	40	2, 3, 4
D-8	SUPPLY DIFFUSER	150	50	2.0	40	2, 3, 4
R-1	LINEAR SLOT RETURN	-	135	-	20	1, 2
R-2	RETURN GRILLE	200X200	130	-	20	1, 2
R-3	LINEAR SLOT RETURN	-	50	-	20	1, 2
R-4	RETURN GRILLE	300X300	210	-	40	1, 2
R-5	LINEAR SLOT RETURN	-	135	-	20	1, 2
R-6	RETURN GRILLE	200X200	150	-	20	1, 2
R-7	RETURN GRILLE	150X150	VARIES	-	20	1, 2
E-1	EXHAUST GRILLE	300X300	200	-	40	2
G-1	TRANSFER GRILLE	300X300	200	-	40	2


1. NO PERFORATED PANEL DIFFUSERS, REGISTERS OR GRILLES WILL BE ACCEPTED.

1. OPEN TO PLENUM ABOVE.
2. COLOR TO MATCH CEILING GRID.
3. DIFFUSER SHALL NOT EXTEND BELOW CEILING.
4. 4-WAY AIR DISTRIBUTION.
5. 2-WAY AIR DISTRIBUTION.
6. SEE DETAIL 9, SHEET M-9.
7. 3 EACH, 20mm WIDE SLOTS.

FAN SCHEDULE								
SYMBOL	SERVICE	LOCATION	DESCRIPTION	AIR FLOW L/sec	ESP Pa	DRIVE TYPE	MAXIMUM RPM	REMARKS
EF-1	COOKING ISL.	KITCHEN	IN-LINE CENTRIFUGAL	4025	425	BELT	1750	1, 3, 4, 6
EF-2	COOKING ISL.	KITCHEN	IN-LINE CENTRIFUGAL	4025	425	BELT	1750	1, 3, 4, 6
EF-3	POT/PAN WASH	KITCHEN	CENTRIFUGAL	500	100	BELT	1750	1, 5
EF-4	GRILLE	SERVERY	CENTRIFUGAL	580	80	BELT	1750	1, 3, 4, 6
EF-5	GRILLE	SERVERY	CENTRIFUGAL	580	80	BELT	1750	1, 3, 4, 6
EF-6	GRILLE	SERVERY	CENTRIFUGAL	580	80	BELT	1750	1, 3, 4, 6
EF-7	GRILLE	SERVERY	CENTRIFUGAL	580	80	BELT	1750	1, 3, 4, 6
EF-8	FRY VAT	SERVERY	CENTRIFUGAL	580	60	BELT	1750	1, 3, 4, 6
EF-9	FRY VAT	SERVERY	CENTRIFUGAL	580	60	BELT	1750	1, 3, 4, 6
EF-10	CARRY-OUT	CARRY-OUT	CENTRIFUGAL	825	90	BELT	1750	1, 3, 4, 6
EF-11	DISHWASHER	DISHWASHING	CENTRIFUGAL	1240	150	BELT	1750	1, 5
EF-12	TOILET	KITCHEN	IN-LINE CENTRIFUGAL	150	30	BELT	1750	2
EF-13	TOILET	DINING AREA	CENTRIFUGAL	225	65	BELT	1750	2
EF-14	TOILET	DINING AREA	CENTRIFUGAL	150	35	BELT	1750	2
EF-15	CAN WASH	CAN WASH	CENTRIFUGAL	200	65	BELT	1750	1
EF-16	WASTE PULPING	WASTE PULP.	CENTRIFUGAL	200	55	DIRECT	1750	1
SF-1	VENT AIR	MECH ROOM	ROOF MTD CENT.	2550	50	BELT	1750	
SF-2	VENT AIR	MECH ROOM	WALL PROP.	750	70	BELT	1750	

1. UPBLAST FAN.
2. DOWNWARD DISCHARGE FAN.
3. INTERLOCK EXHAUST FAN WITH FIRE SUPPRESSION SYSTEM IN ACCORDANCE WITH NFPA 96-1994, PARAGRAPHS 5.2 AND 7.3.
4. PROVIDE HINGED CONNECTION IN ACCORDANCE WITH NFPA 96-1994 PARAGRAPH 4-8.2.1
5. ALL DUCTWORK ON THIS SYSTEM SHALL BE STAINLESS STEEL.
6. FAN SHALL COMPLY WITH NFPA 96-1994, CHAPTER 5.


EXHAUST HOOD SCHEDULE						(SEE NOTE 4)
KITCHEN ITEM NO. (NOTE 1)	EXHAUST AIR FLOW (L/s)	EXHAUST PRESSURE DROP (Pa)	SUPPLY AIR FLOW (L/s) (NOTE 6)	SUPPLY PRESSURE DROP (Pa)	DIMENSIONS (L x W x H) (NOTES 3, 5)	HOOD TYPE
39	4025	400	3220	25	6700x3250x900	GREASE COLLECTION HOOD
55	500	75	NOT USED	NOT USED	3000x1220x900	CONDENSATE HOOD
71	580	65	464	25	1500x1050x900	GREASE COLLECTION HOOD
89	580	65	464	25	1500x1050x900	GREASE COLLECTION HOOD
120	720	100	NOT USED	NOT USED	3850x1350x900	CONDENSATE HOOD
C10	825	70	660	25	2350x1000x900	GREASE COLLECTION HOOD

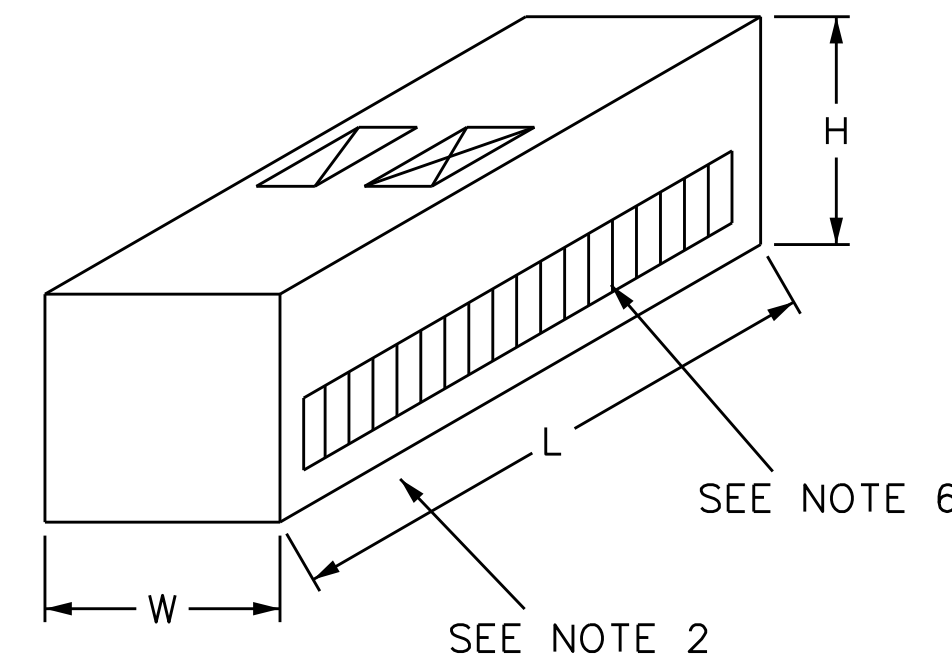


1. KITCHEN ITEM NO. CORRESPONDS TO THE KITCHEN EQUIPMENT ITEM NO. ON SHEETS K-2 & K-3.
2. BOTTOM OF HOOD SHALL BE AT 2100mm A.F.F. HOOD SHALL EXTEND TO THE CEILING. ADDITIONAL PANELS MAY BE INSTALLED IF NECESSARY TO REACH CEILING.
3. DIMENSIONS INCLUDE A 300mm OVERHANG IN THE FRONT AND A 150mm OVERHANG ON EACH SIDE AND THE BACK WHERE THE HOOD IS NOT AGAINST A WALL.
4. ALL WELDS SHALL BE GROUND FLAT AND POLISHED TO MATCH FACTORY WELDS.
5. DIMENSIONS ARE IN mm.
6. ALL SUPPLY AIR SHALL BE INTRODUCED TO THE OCCUPIED SPACE THROUGH GRILLES ON THE FRONT OF THE HOOD ONLY. BLADES IN THE GRILLES SHALL BE FIXED IN POSITION.

EXPANSION TANK SCHEDULE					
SYMBOL	SIZE (LITERS)	SERVICE	MIN. OPERATING CONDITIONS	MAX. OPERATING CONDITIONS	TYPE
ET-1	670	CW	4.5° C/205 kPa	93° C/620 kPa	BLADDER
ET-2	370	HW	4.5° C/205 kPa	93° C/620 kPa	BLADDER

[illegible]

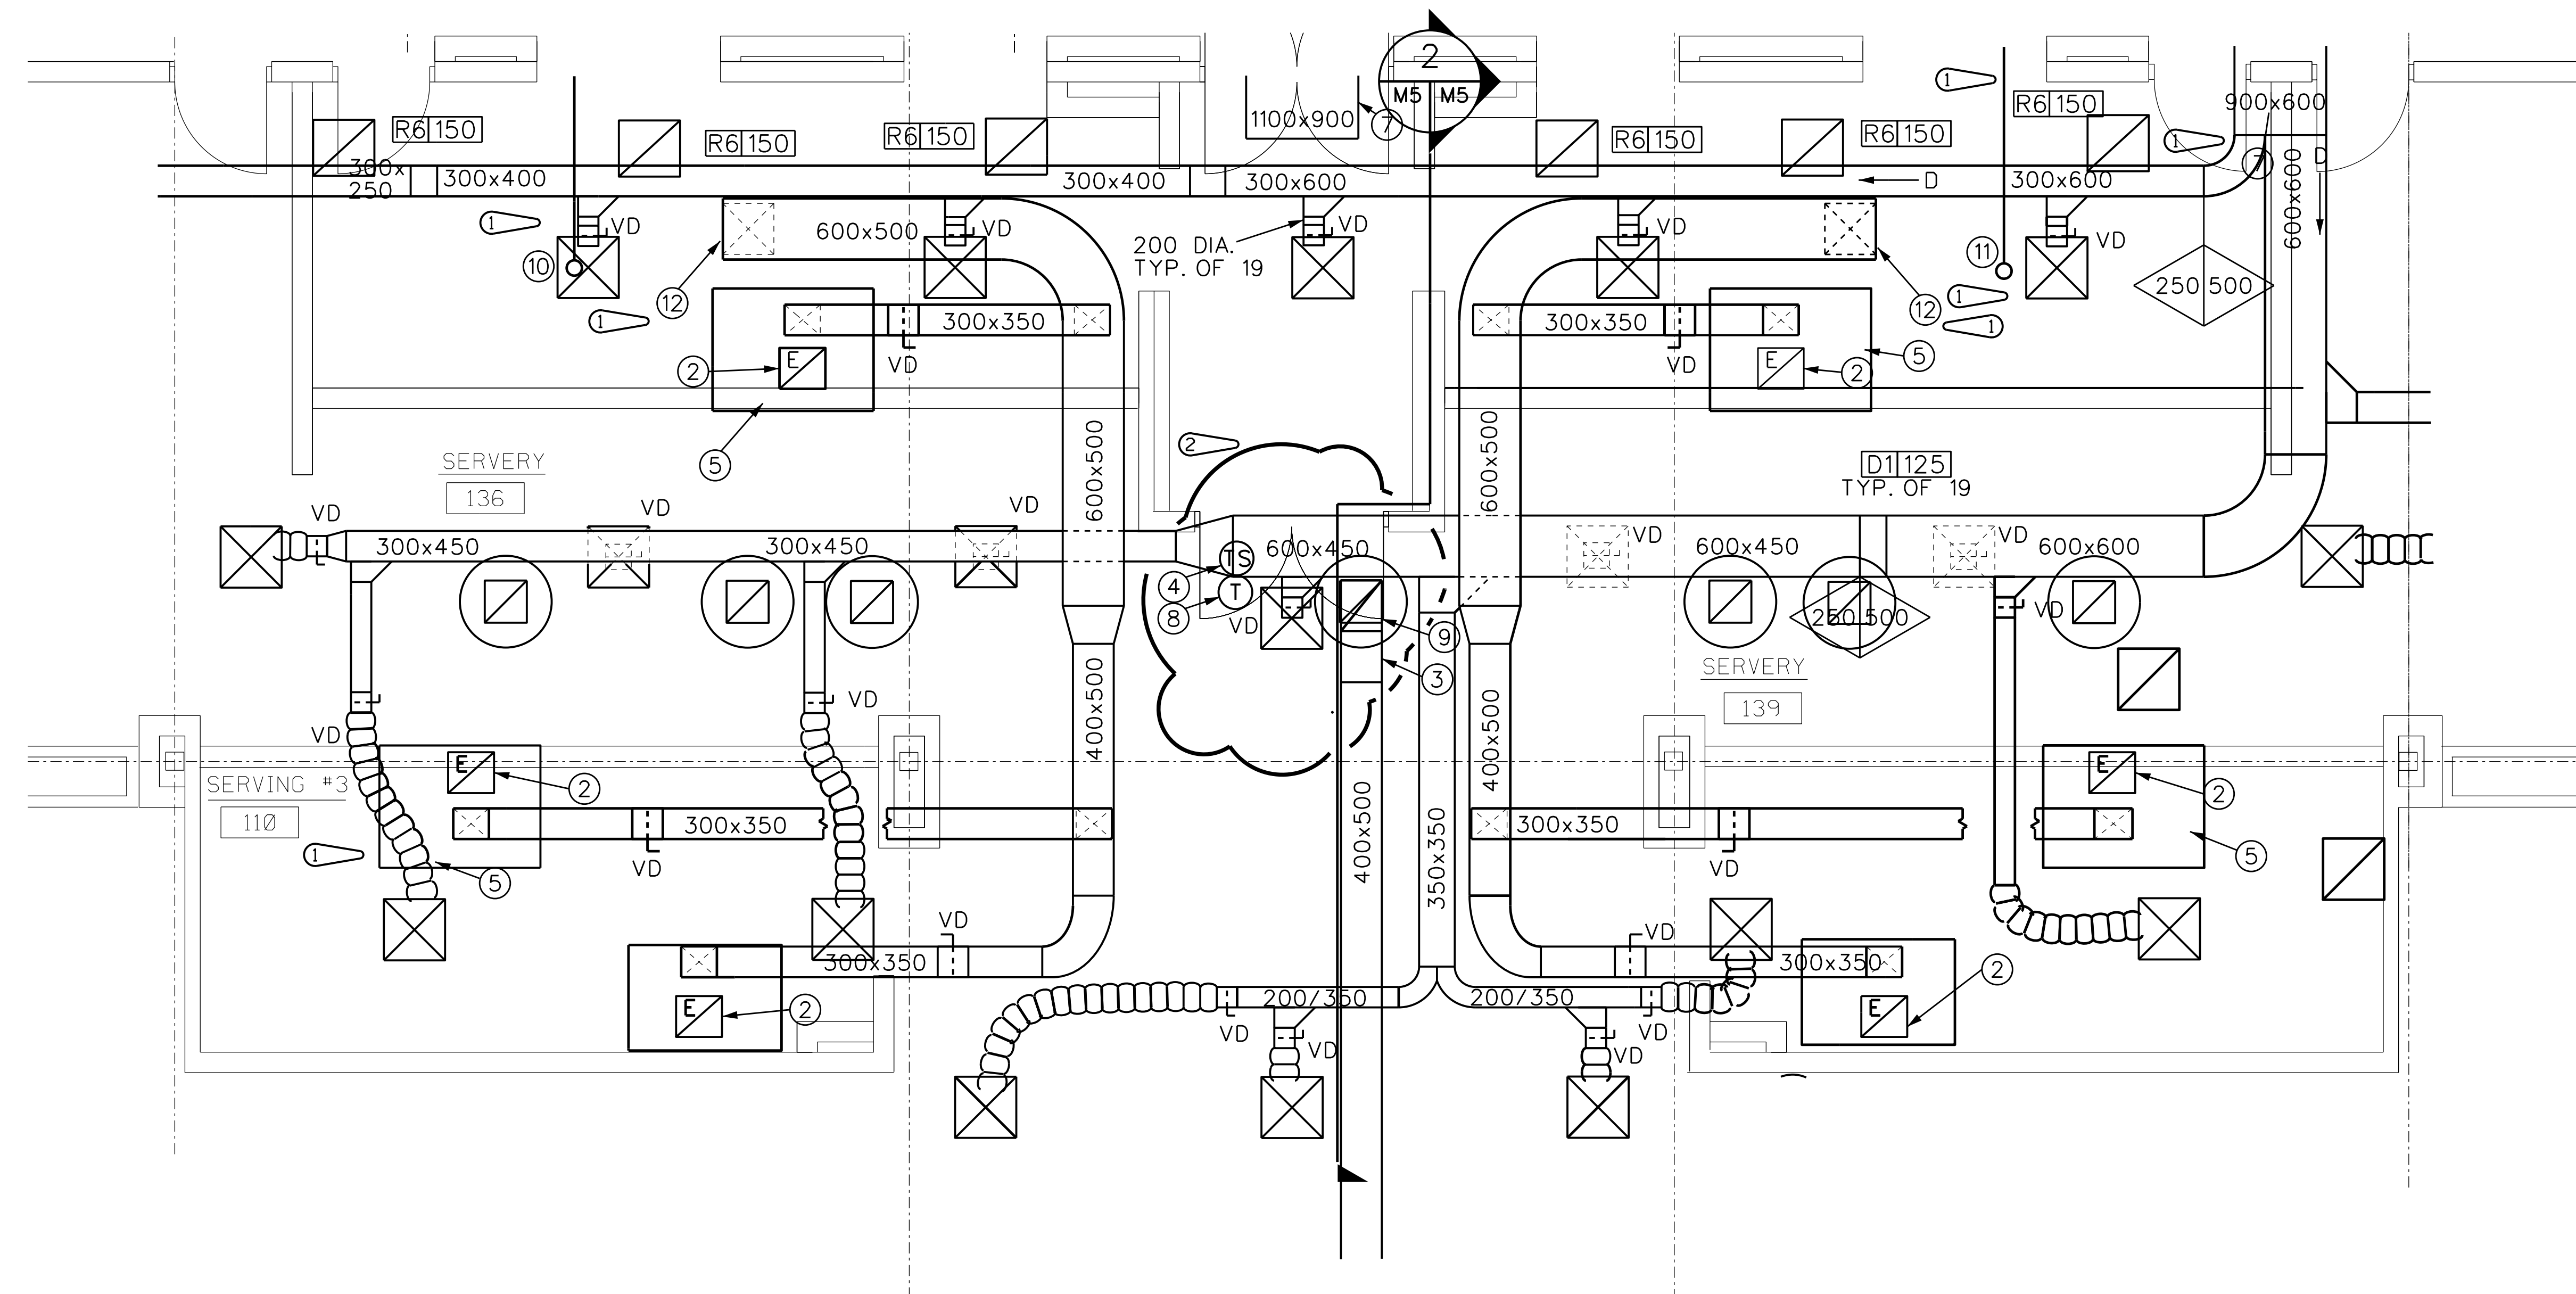

1 ENLARGED SERVED HVAC PLAN
SCALE 1:50

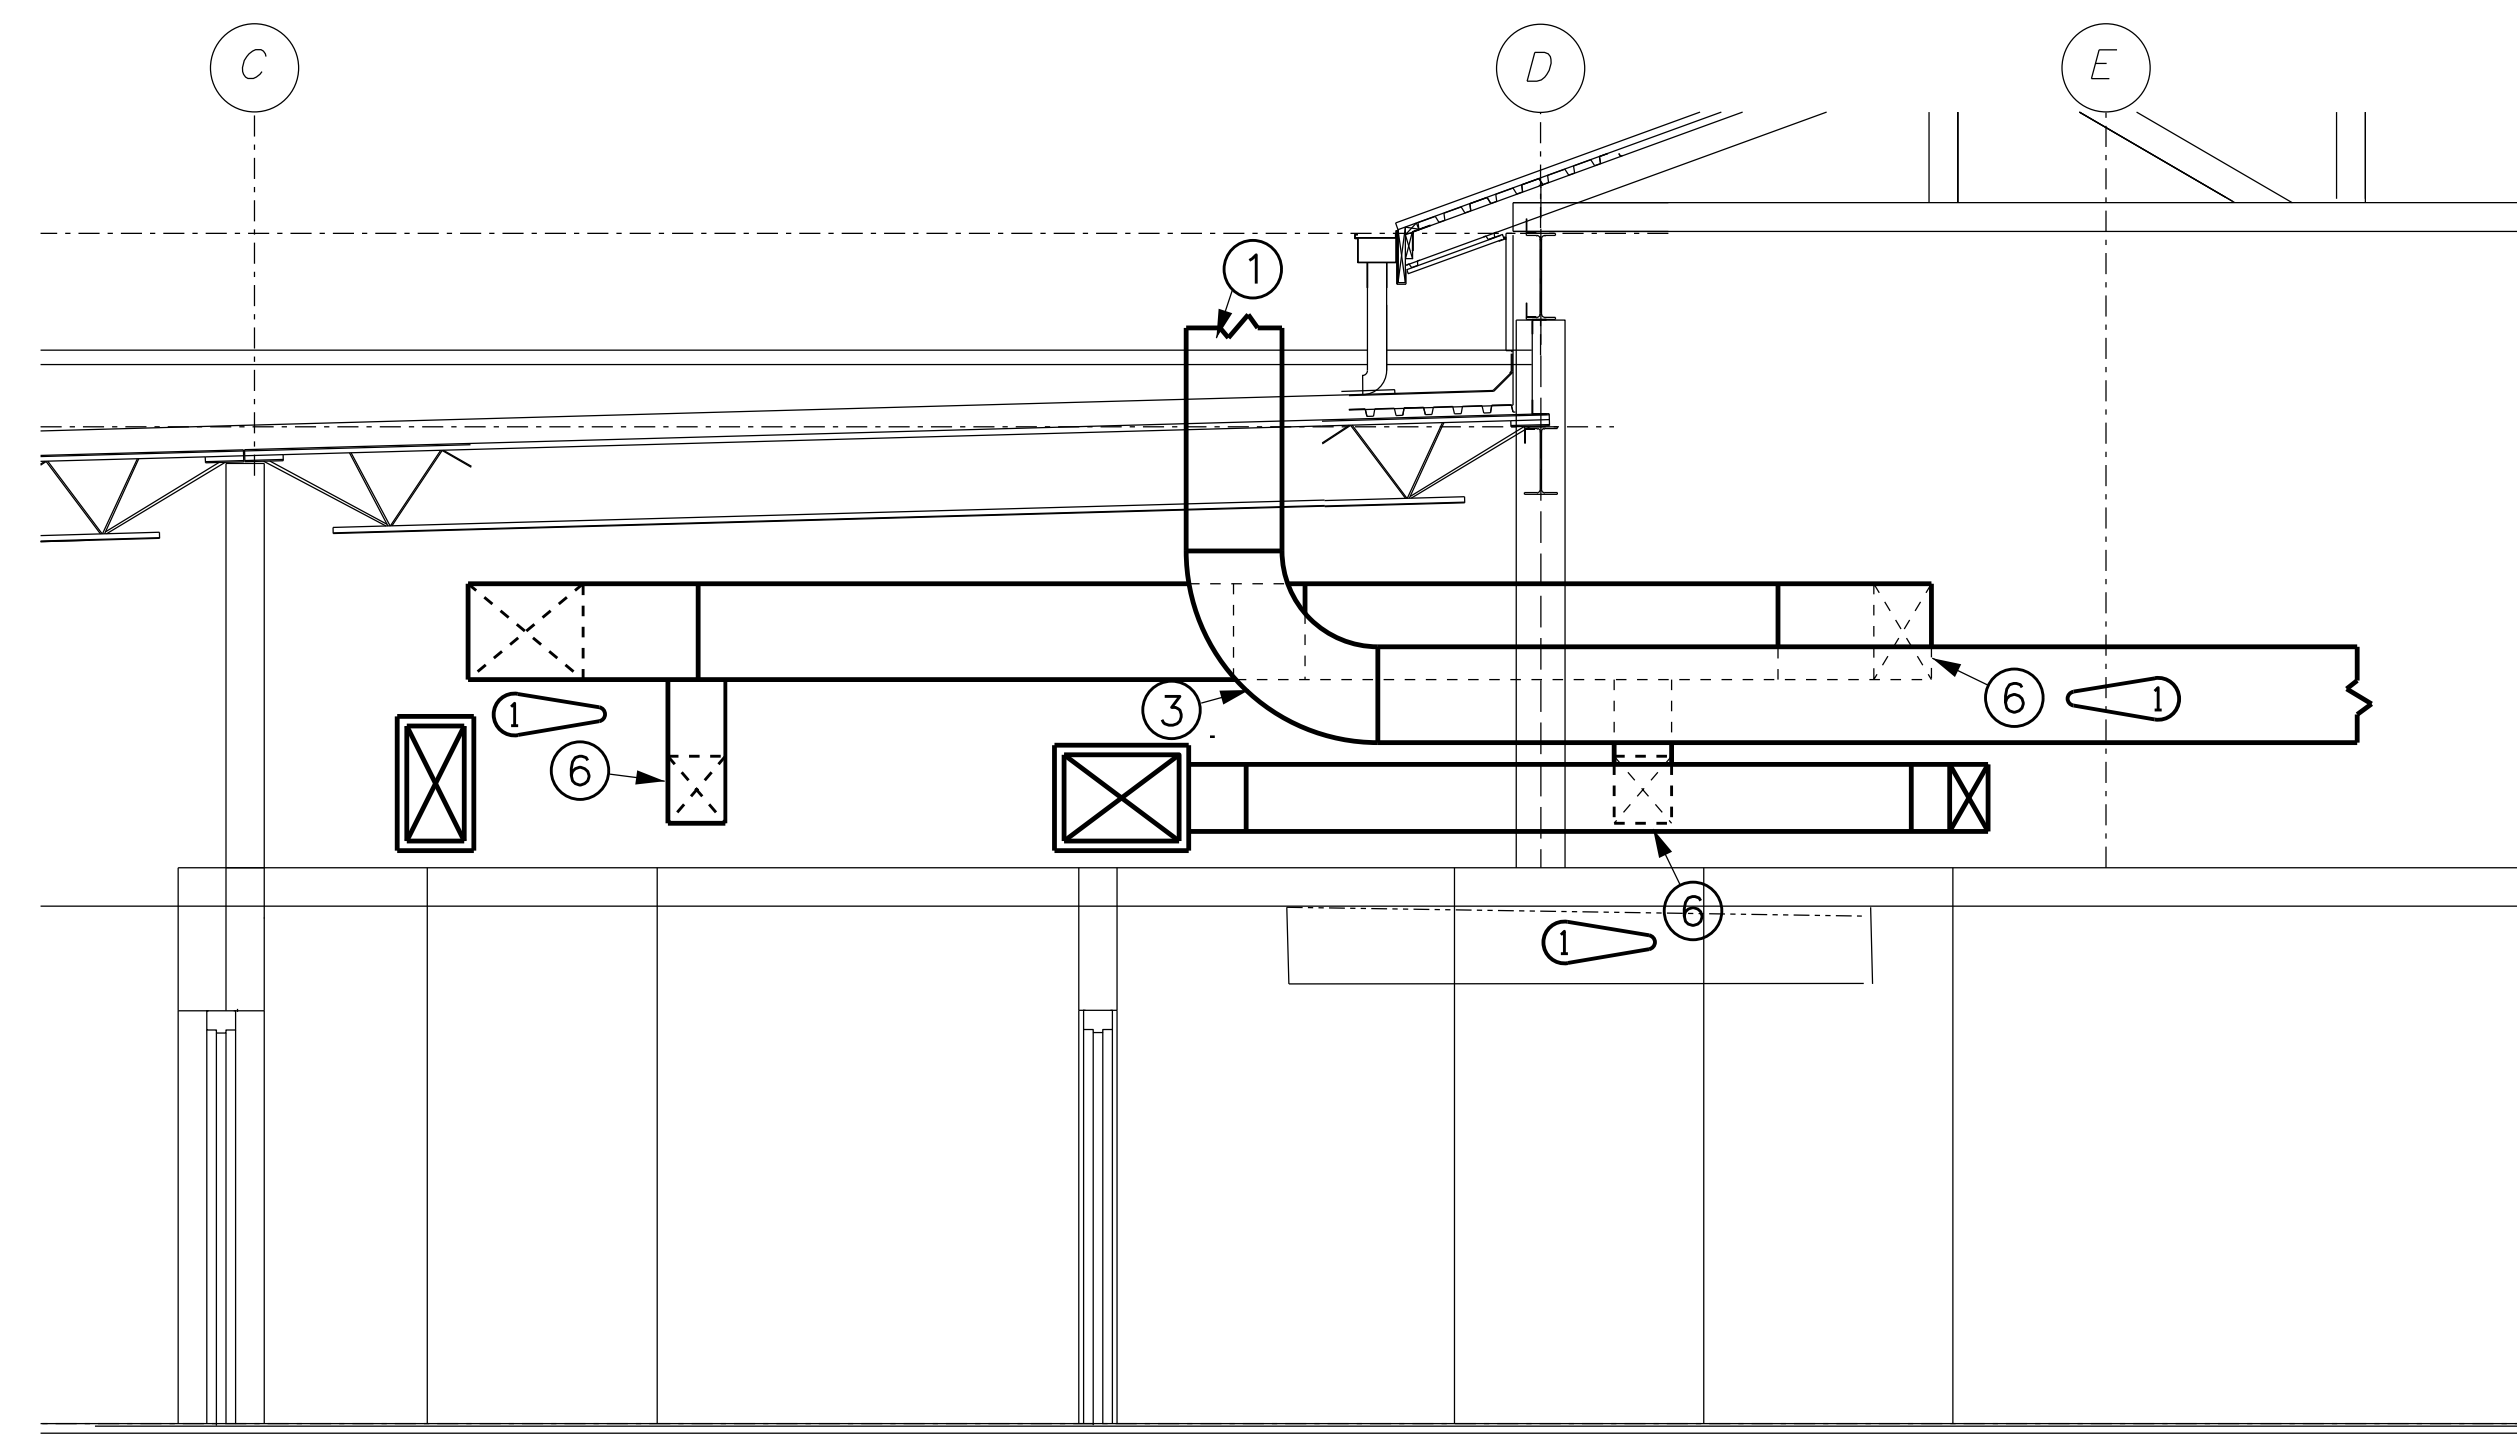


2 SECTION OF SERVED AREA
SCALE 1:50

GENERAL NOTES:

- SEE GENERAL NOTES ON SHEET M-2.

KEYED NOTES FOR SERVED HVAC:

- 500 X 400 STAINLESS STEEL EXHAUST DUCT UP TO EF-11 ON ROOF. SEE SHEET M-8 FOR CONTINUATION.
- 450 X 400 STAINLESS STEEL EXHAUST DUCT UP TO EXHAUST FAN ON ROOF. SEE SHEET M-8 FOR CONTINUATION.
- LONG RADIUS ELBOW FROM VERTICAL POSITION TO HORIZONTAL.
- TEMPERATURE SENSOR TO AHU-2.
- INSTALL HOOD NEXT TO BULKHEAD FRAMING.
- MAKE-UP AIR DUCT TO EXHAUST HOOD.
- MOUNT BOTTOM OF DUCT AT 3000mm A.F.F. COORDINATE WITH STRUCTURAL OPENING IN WALL.
- NIGHT STAT FOR AHU-2.
- 400 X 500 STAINLESS STEEL EXHAUST DUCT UP TO EF-11 ON ROOF. SEE SHEET M-8 FOR CONTINUATION.
- 65mm GAS LINE UP TO MAU-3 ON ROOF. SEE SHEET M-8 FOR CONTINUATION.
- 65mm GAS LINE UP TO MAU-4 ON ROOF. SEE SHEET M-8 FOR CONTINUATION.
- 500 X 500 MAKE-UP AIR DUCT UP TO MAKE-UP AIR UNIT ON ROOF. SEE SHEET M-8 FOR CONTINUATION.

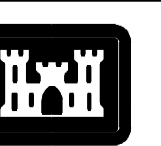

US ARMY CORPS
OF ENGINEERS
SAVANNAH DISTRICT

DATE	REV.
14 JUL 97	
CATEGORY CODE	
721-H-11	
SOLICITATION NO.	
DACA2197-B-0055	
PLOT DATE: 14 JUL 97	
PLOT SCALE: 1	


DATE	BY	DESCRIPTION
30 SEP 04	DCC	AS BUILT
17 AUG 98	SWM	REVISED IN ACCORDANCE WITH MODIFICATION 98-22-H
30 JUL 97	SWM	GENERAL REVISIONS

RANGER BARRACKS COMPLEX FORT BENNING, GEORGIA	DINING FACILITY ENLARGED HVAC PLANS
--	--

PLATE REFERENCE NUMBER:
M-5
SHEET 327

GRAPHIC SCALE 1:50

THIS LENGTH OF SCALE REPRESENTS 5m ON PLAN

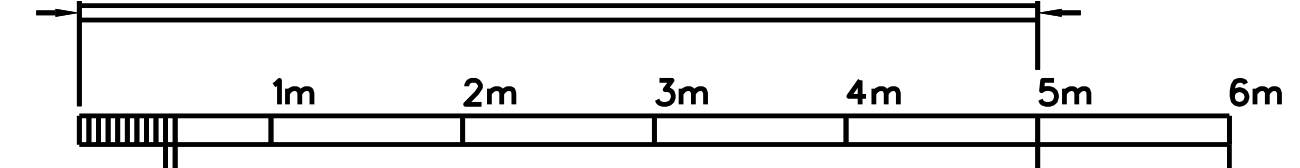

THIS LENGTH OF
SCALE REPRESENTS
50mm ON PLAN

THIS LENGTH OF
SCALE REPRESENTS
1m ON PLAN

ALL DIMENSIONS ARE MILLIMETERS (mm) UNLESS OTHERWISE NOTED.

US ARMY CORPS
OF ENGINEERS
SAVANNAH DISTRICT

DATE: 14 JUL 97

REV.

CATEGORY CODE
721-11-11

U.S. ARMY ENGINEER DISTRICT
CORPS OF ENGINEERS
SAVANNAH, GEORGIA

SOLICITATION NO:
DACA2197-B-0055

U.S. ARMY ENGINEER DISTRICT
CORPS OF ENGINEERS
SAVANNAH, GEORGIA

PLOT DATE: 14 JUL 97

DATE

PLOT SCALE: 1:50

BY

CONTRACT NO: DACA21-98-C-0022

DESCRIPTION

AS BUILT

GENERAL

REVISIONS

DATE

BY

RANGER BARRACKS COMPLEX
FORT BENNING, GEORGIA
DINING FACILITY

ENLARGED HVAC PLANS

PLATE
REFERENCE
NUMBER:

M-6
SHEET 328

1 ENLARGED CARRY-OUT HVAC PLAN
SCALE 1:50

2 ENLARGED DISHWASHING AREA HVAC PLAN
SCALE 1:50

GENERAL NOTES:

- SEE GENERAL NOTES ON SHEET M-2.

KEYED NOTES FOR CARRY-OUT AREA HVAC PLAN:

- 400 X 400 DUCT DOWN FROM MAU-5 ON THE ROOF. SEE SHEET M-8 FOR CONTINUATION.
- 400 X 350 DUCT TO EXHAUST HOOD.
- 350 X 350 STAINLESS STEEL EXHAUST DUCT UP TO EF-10 ON ROOF. SEE SHEET M-8 FOR CONTINUATION. OFFSET WILL BE REQUIRED IN DUCT TO AVOID JOIST ABOVE. SEE DETAIL 8, SHEET M-10 FOR OFFSET CONSTRUCTION.
- 20mm GAS LINE UP TO/DOWN FROM MAU-5 ON ROOF. SEE SHEET M-8 FOR CONTINUATION.
- 100 CHR; 80 HWR; 80 HWS; 100 CHS.
- MODULATING T-STAT FOR ZONE 3 OF MZ-1.
- 100 CHR; 100 CHS; 80 HWR; 80 HWS.

3 SECTION OF DISHWASHING AREA
SCALE 1:50

GENERAL NOTES:

- SEE GENERAL NOTES ON SHEET M-2.

KEYED NOTES FOR DISHWASHING AREA HVAC PLAN AND SECTION:

- ALL DUCT IN THIS SYSTEM SHALL BE CONSTRUCTED OF STAINLESS STEEL. DUCT SHALL BE INSTALLED WITH A 2% SLOPE BACK TOWARD THE AIR INLETS.
- 275 X 200 DUCT UP FROM EXHAUST HOOD. INSTALL VOLUME DAMPER AND USE 45° CONNECTION AT MAIN DUCT. BALANCE AIR FLOW TO 360 L/s.
- DUCT UP FROM EXHAUST HOOD. INSTALL VOLUME DAMPER AND USE 45° CONNECTION AT MAIN DUCT. DUCT SIZE PER KITCHEN EQUIPMENT SCHEDULE. BALANCE AIR FLOW TO 260 L/s.
- AIR IN FROM DISHWASHER. VOLUME DAMPERS SHALL BE PROVIDED WITH DUCT CONNECTION KIT SUPPLIED BY DISHWASHER MANUFACTURER.
- RUN DUCT BETWEEN JOISTS.
- AIR INTO EXHAUST HOOD FROM OCCUPIED SPACE.
- MAINTAIN DISTANCE REQUIRED FOR VOLUME DAMPERS.
- SLOT RETURNS ARE TO BE CONTINUOUS ALONG WALL.


GRAPHIC SCALE 1:50

THIS LENGTH OF SCALE REPRESENTS 5m ON PLAN


THIS LENGTH OF SCALE REPRESENTS 50mm ON PLAN

THIS LENGTH OF SCALE REPRESENTS 1m ON PLAN


ALL DIMENSIONS ARE MILLIMETERS (mm) UNLESS OTHERWISE NOTED.

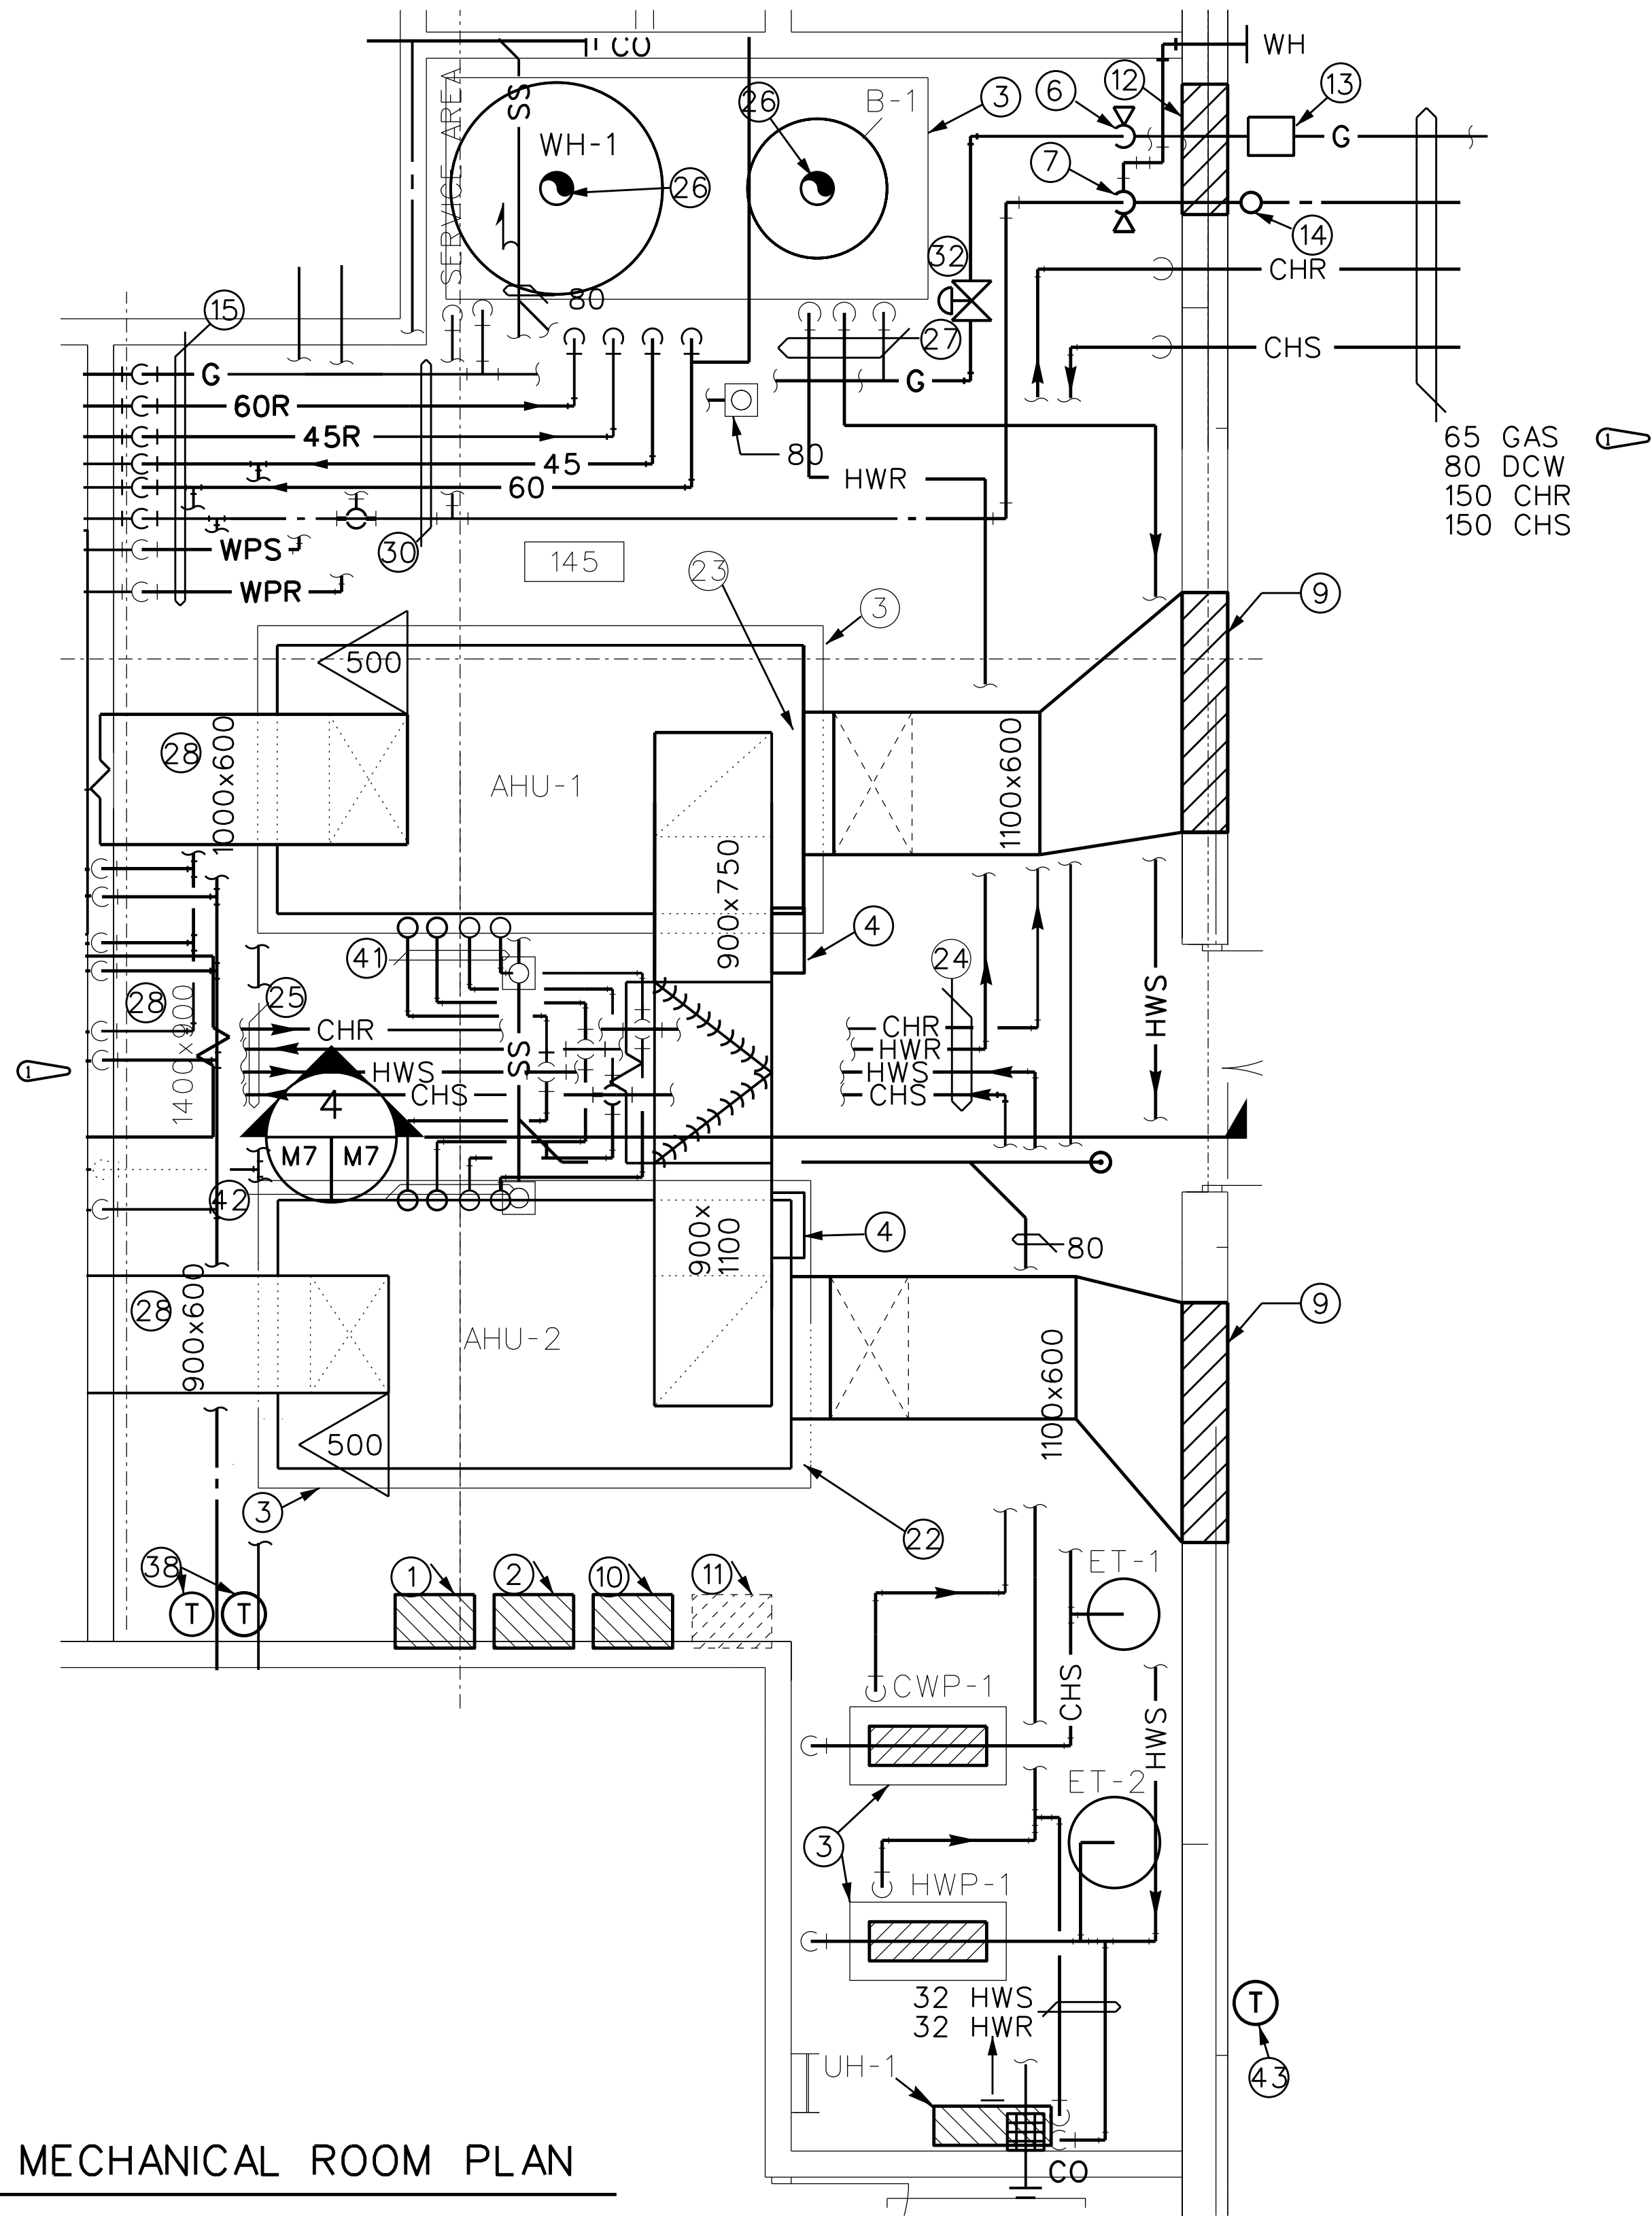


1 ENLARGED MECHANICAL ROOM PLAN
MP2 M7
M3 SCALE 1:50

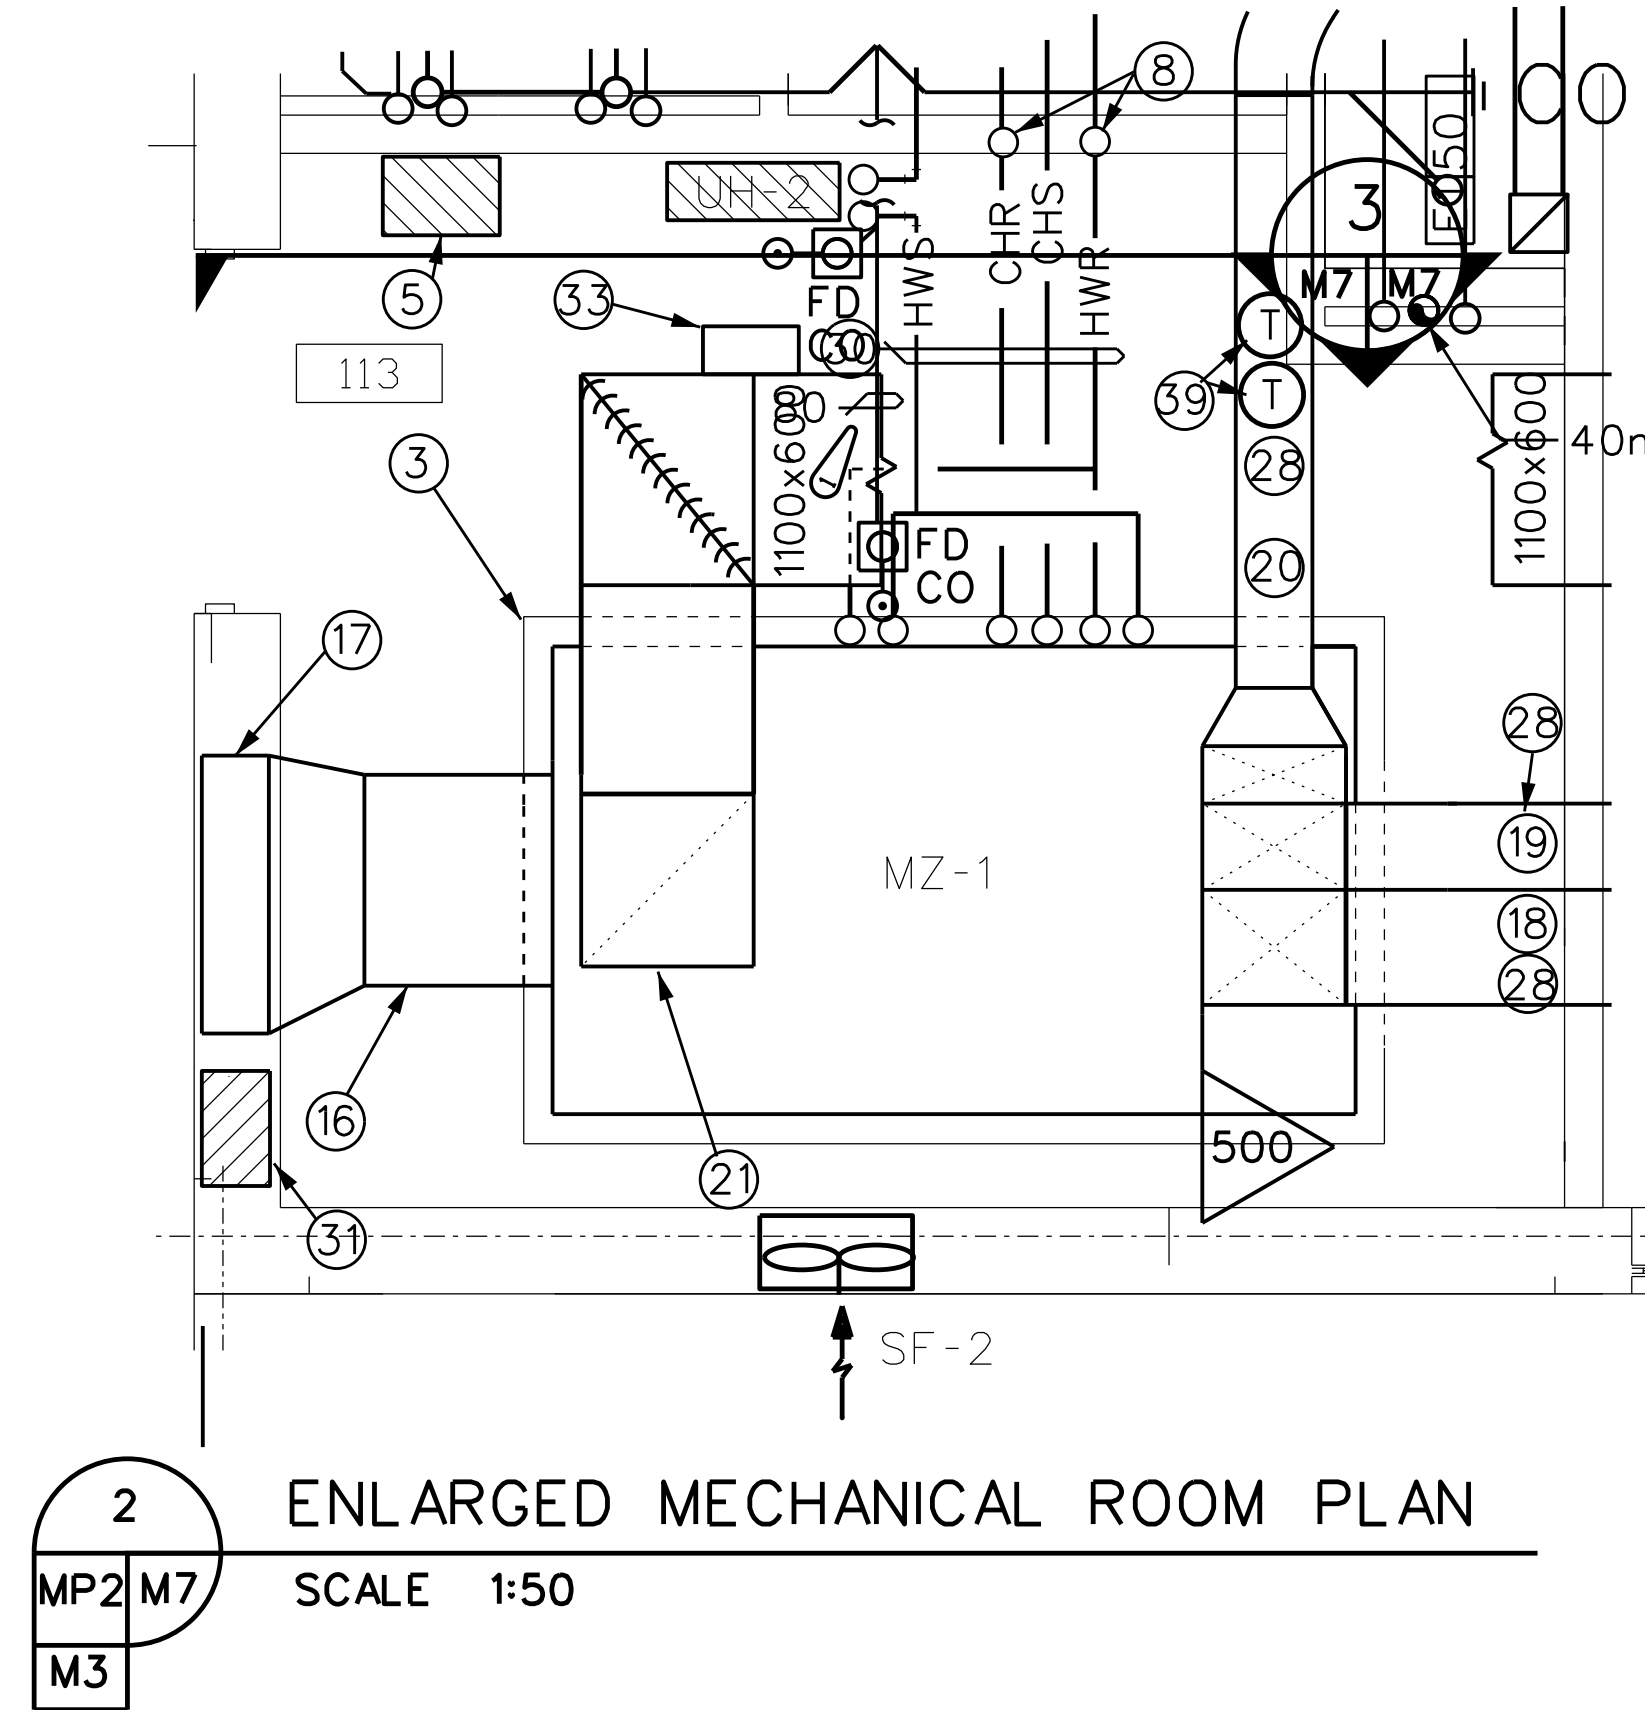


2 ENLARGED MECHANICAL ROOM PLAN
MP2 M7
M3 SCALE 1:50

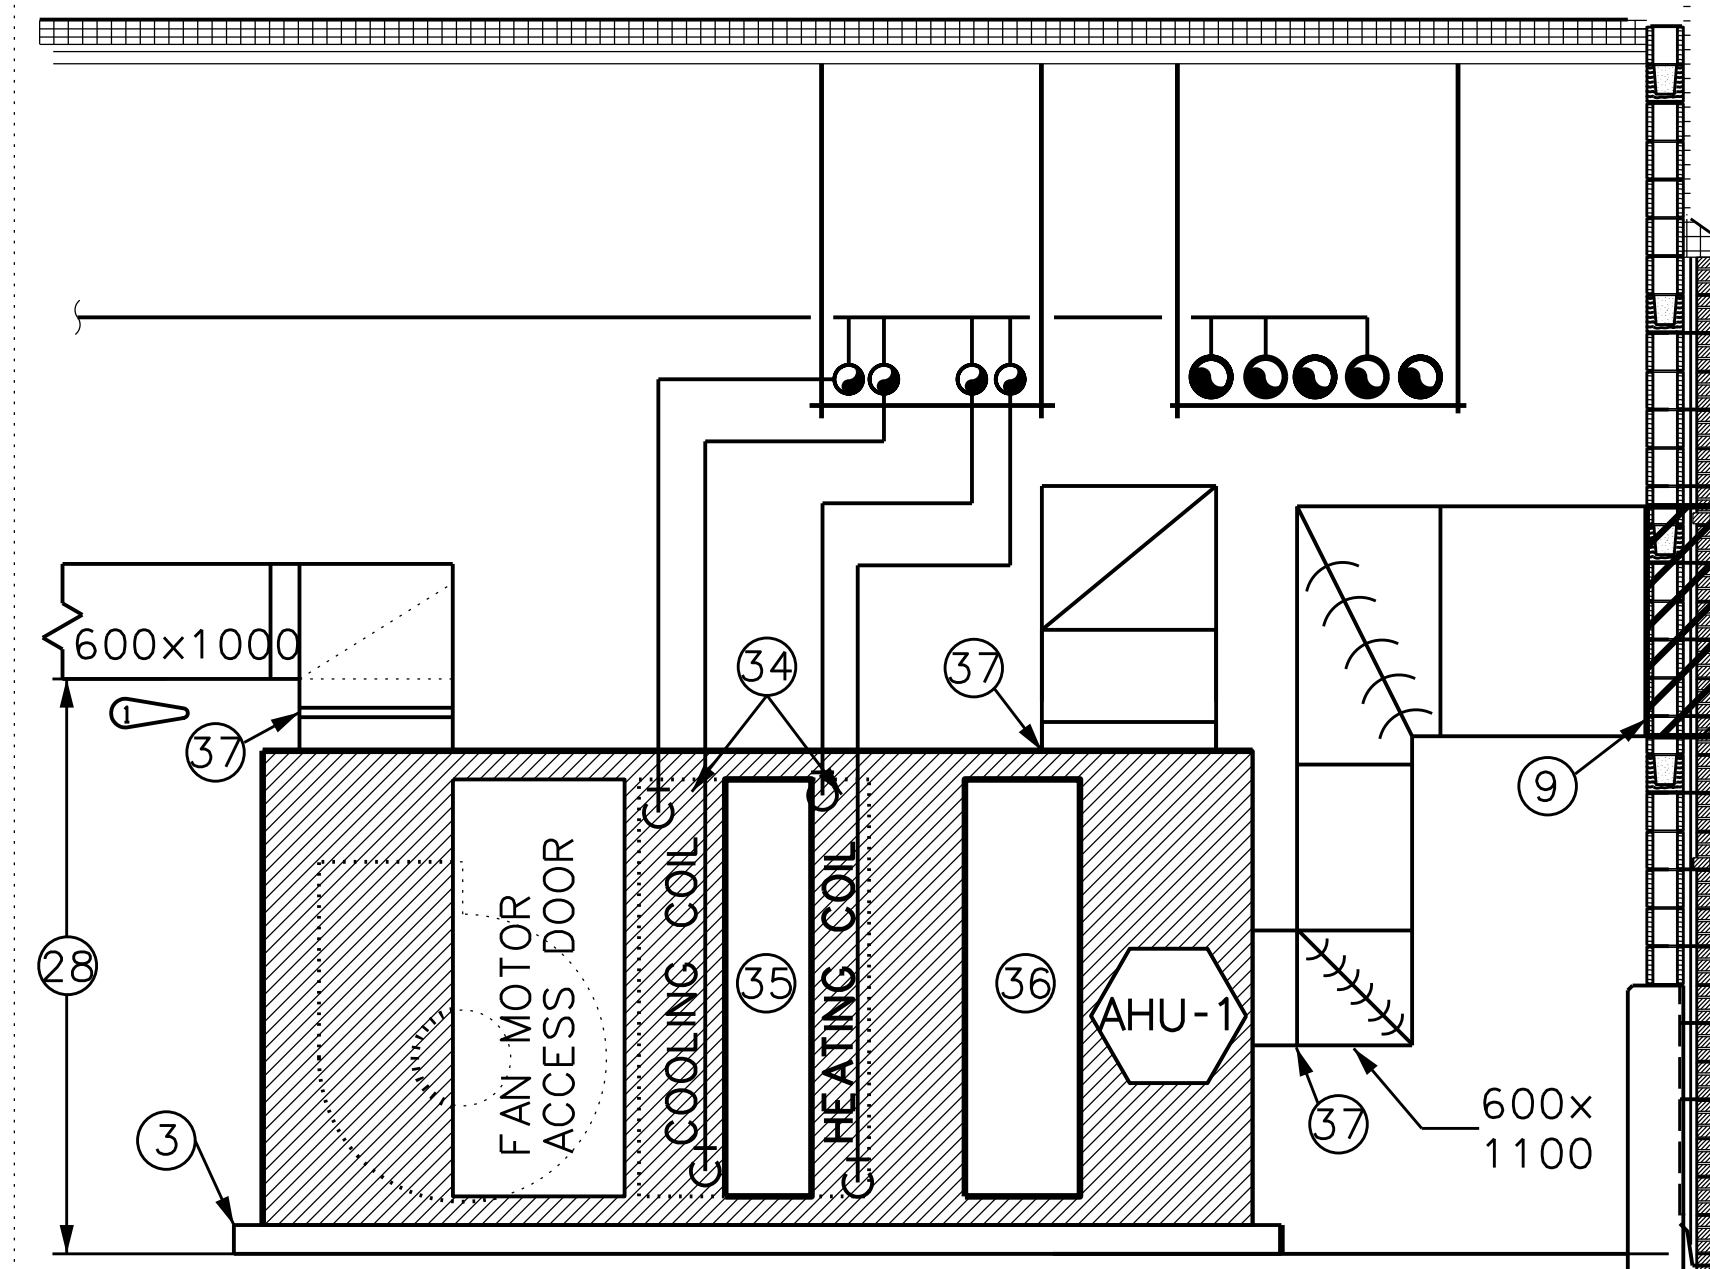

4 SECTION THRU MECHANICAL ROOM
M7 M7 SCALE 1:50

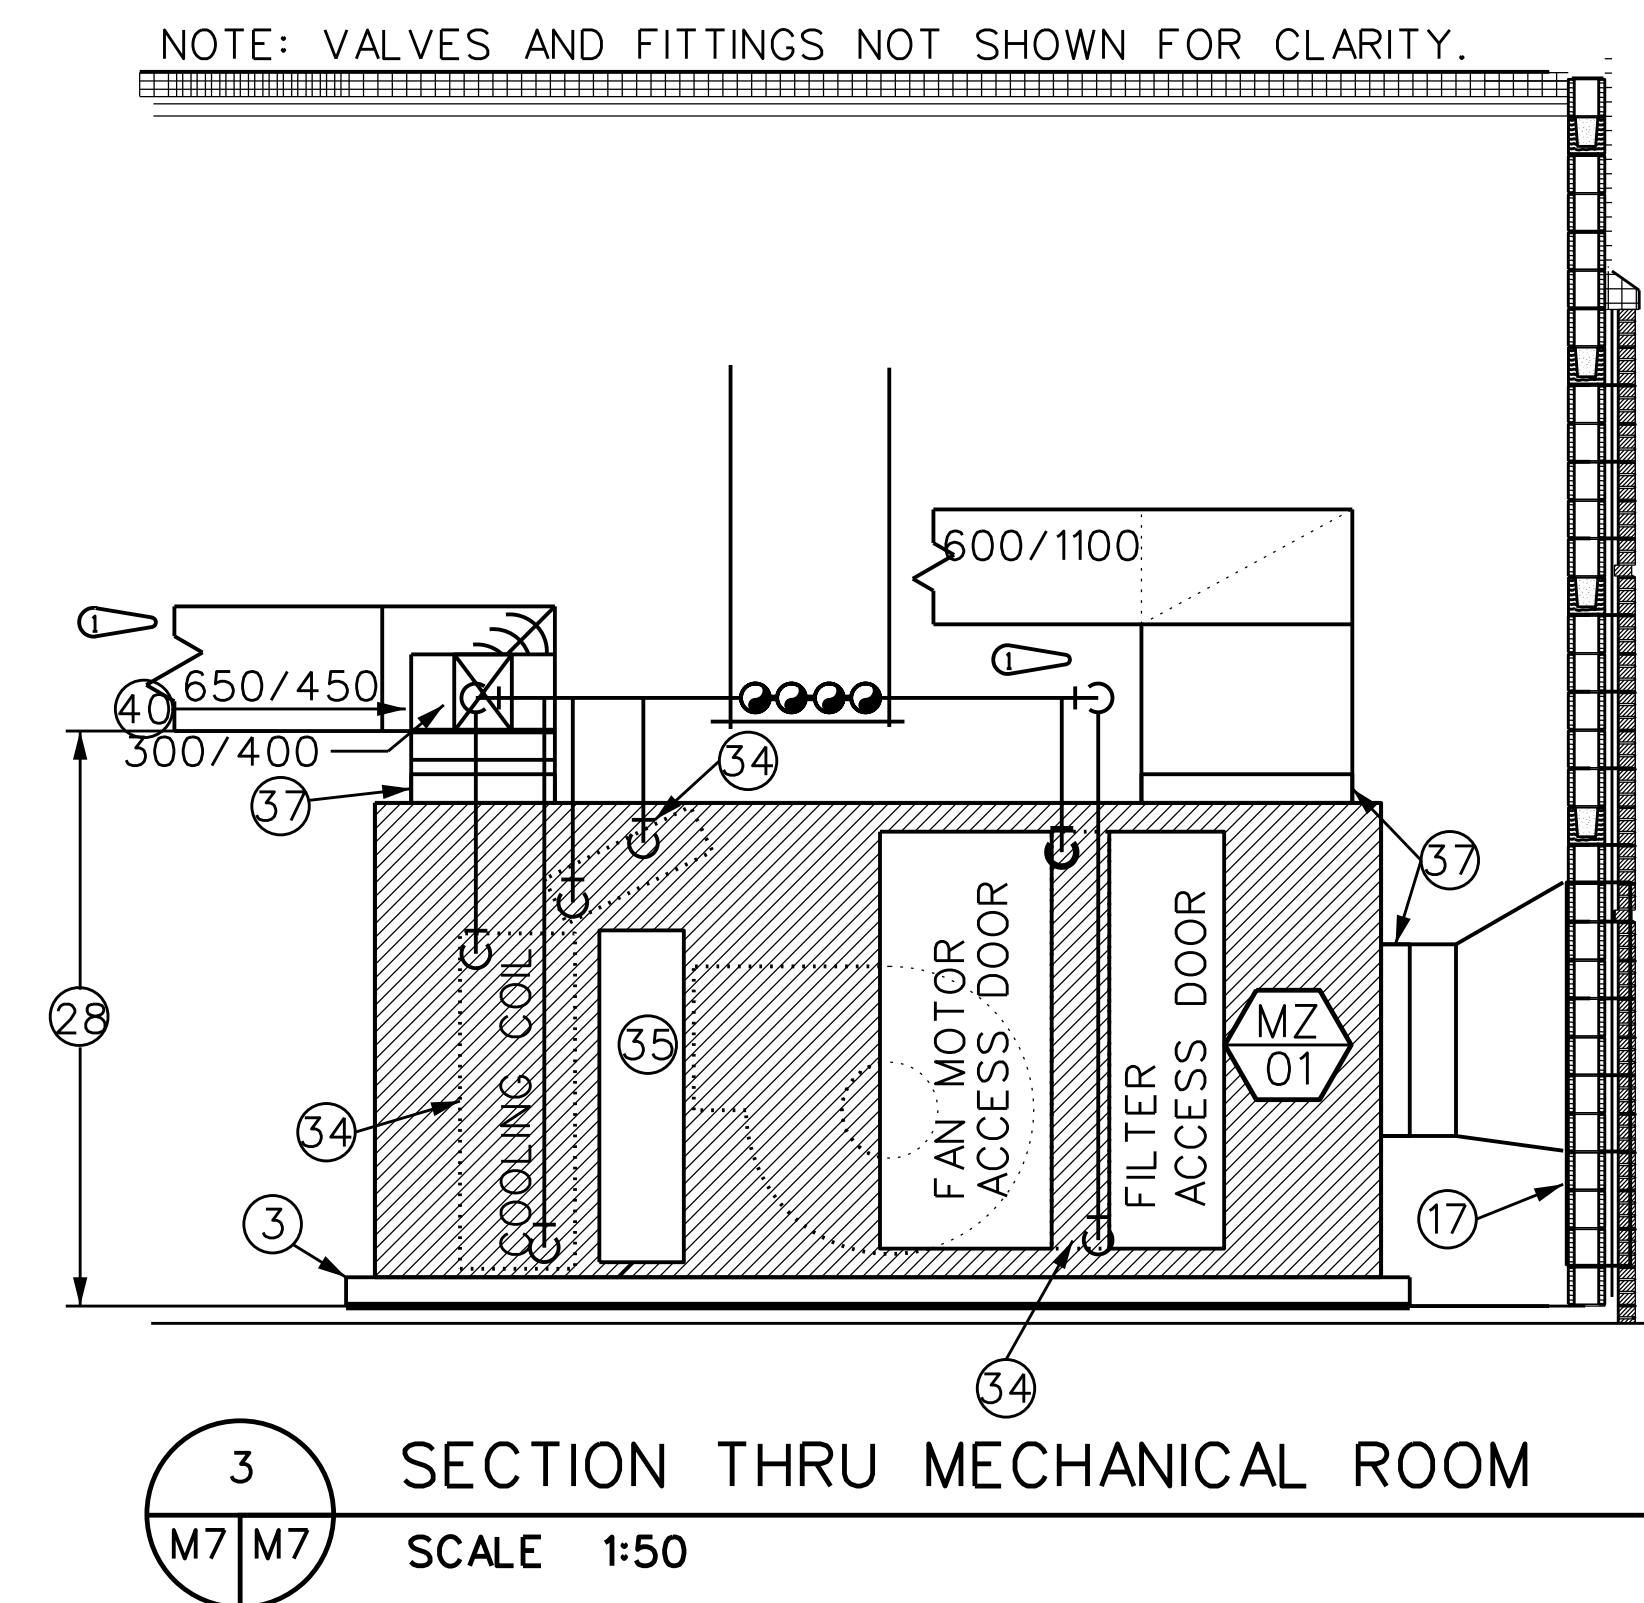

3 SECTION THRU MECHANICAL ROOM
M7 M7 SCALE 1:50

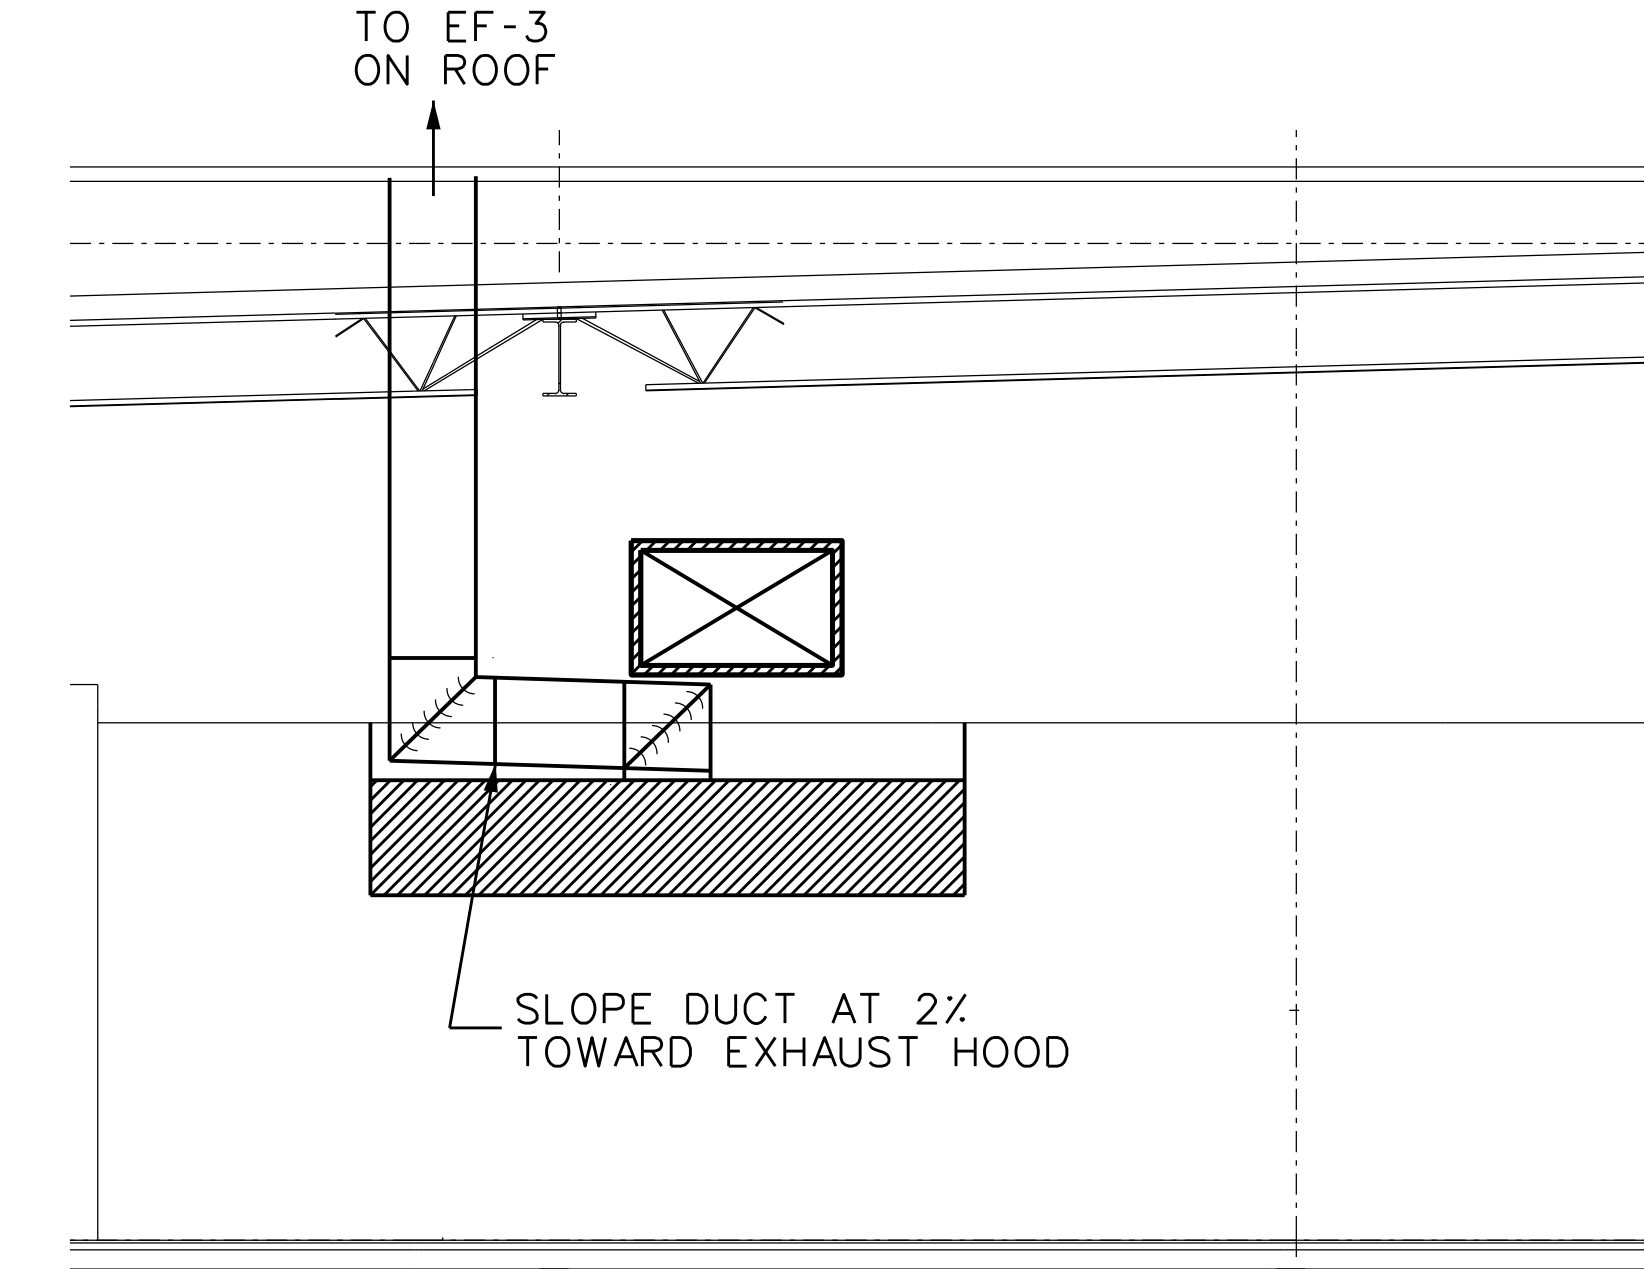

5 SECTION AT POT AND PAN WASH
M4 M7 SCALE 1:50



KEYED NOTES FOR MECHANICAL ROOM PLANS AND SECTIONS:

- ① AHU-1 AND HYDRONIC SYSTEM CONTROL PANEL.
- ② AHU-2 CONTROL PANEL.
- ③ 150mm HIGH HOUSEKEEPING PAD. EXTEND PAD 150mm BEYOND UNIT FOOTPRINT.
- ④ 500mmX650mm RELIEF AIR DUCT. RELIEVE AIR INTO MECH. ROOM.
- ⑤ MZ-1 CONTROL PANEL.
- ⑥ PLUG VALVE IN GAS LINE
- ⑦ BALL VALVE IN DOMESTIC WATER LINE.
- ⑧ AUTOMATIC AIR VENT. PIPING AT THIS POINT IS TO BE HIGHER THAN ANY OTHER POINT IN THE SYSTEM. SEE DETAIL 6, SHEET M-10.
- ⑨ 1800mmX1200mm OUTDOOR AIR INTAKE LOUVER. SEE SECTION C, SHEET A-5, FOR EXACT LOCATION.
- ⑩ DATA TERMINAL CABINET.
- ⑪ FIELD INTERFACE PANEL. NOT IN CONTRACT.
- ⑫ 2600mmX1000mm LOUVER AND 800mmX1000mm LOUVER. SEE ARCHITECTURAL FOR EXACT LOCATION AND DETAIL 4, SHEET M-10 FOR CONFIGURATION.
- ⑬ GAS METER WITH PULSE GENERATOR, SEE DETAIL 7, SHEET MP-9. GAS CONSUMPTION WILL BE 50 L/s.
- ⑭ WATER METER WITH PULSE GENERATOR. SEE SPEC. SECTION 02660. SYSTEM WAS DESIGNED FOR A FLOW OF 9 L/s AT 276 kPa.
- ⑮ PIPES DOWN TO CRAWL SPACE BELOW. SEE DETAIL 2, SHEET MP-11.
- ⑯ 1100mmX1000mm OUTSIDE AIR DUCT TO MZ-1.
- ⑰ 1400mmX2000mm LOUVER. TOP PORTION (1400mmX1400mm) OUTSIDE AIR LOUVER FOR MZ-1. BOTTOM PORTION (1400mmX600mm) SHALL HAVE A MOTORIZED DAMPER. DAMPER SHALL BE INTERLOCKED SF-2 OPERATION. WITH SEE SECTION A, SHEET A-4, FOR EXACT LOCATION.
- ⑱ 600mmX650mm SUPPLY AIR DUCT FOR ZONE 1.
- ⑲ 450mmX650mm SUPPLY AIR DUCT FOR ZONE 2.
- ⑳ 400mmX300mm SUPPLY AIR DUCT FOR ZONE 3.
- ㉑ 900mmX900mm RETURN AIR DUCT TO MZ-1.
- ㉒ 1100mmX900mm RETURN AIR DUCT TO AHU-2. 1100mmX900mm RELIEF AIR DUCT. RELIEVE AIR INTO MECHANICAL ROOM.
- ㉓ 750mmX900mm RETURN AIR DUCT DOWN TO AHU-1. 750mmX900mm RELIEF AIR DUCT UP INTO MECH. ROOM.
- ㉔ 150mm CHR; 100mm HWR; 100mm HWS; 150mm CHS
- ㉕ 100mm CHR; 80mm HWR; 80mm HWS; 100mm CHS.
- ㉖ 250mm DIA. FLUE THRU ROOF. SEE DETAIL 8, SHEET MP-9.
- ㉗ 50mm GAS; 100mm HWS; 100mm HWR.
- ㉘ MOUNT BOTTOM OF DUCT AT 3000mm A.F.F. COORDINATE WITH STRUCTURAL OPENING IN WALL.
- ㉙ SEE FIRE PROTECTION DRAWINGS FOR CONTINUATION.
- ㉚ 65mm GAS; 20mm 60R; 20mm 45R; 50mm 45°C; 40mm 60°C; 80 DCW.
- ㉛ 600mmX2400mm LOUVER FOR RELIEF AIR. BAROMETRIC DAMPER SHALL BE SET AT 12.5 Pa.

- ㉜ ELECTRICALLY OPERATED SOLENOID VALVE. VALVE SHALL BE A NORMALLY CLOSED PLUG VALVE. VALVE SHALL BE OPENED WHEN THE FIRE ALARM CONTROL PANEL IS NOT IN AN ARMED CONDITION.
- ㉝ 500mmX500mm RELIEF AIR DUCT. RELIEVE AIR INTO MECH. ROOM.
- ㉞ SEE DETAIL 1, SHEET M-9 FOR PIPING CONNECTIONS TO COIL.
- ㉟ MINIMUM 300mm WIDE ACCESS DOOR.
- ㊱ ACCESS DOOR TO FILTER SECTION. THIS DOOR MAY BE USED FOR ACCESS TO HEATING COIL FACE.
- ㊲ FLEXIBLE CONNECTION, SEE DETAIL 10, SHEET M-9.
- ㊳ THERMOSTATS FOR UH-1 AND SF-1.
- ㊴ THERMOSTATS FOR UH-2 AND SF-2.
- ㊵ MANUAL, LOCKING, OPPOSED BLADE DAMPER (TYP. FOR EACH ZONE).
- ㊶ 80 mm CHS; 80mm CHR; 80mm HWS; 80mm HWR
- ㊷ 80mm CHR; 80mm CHS; 50mm HWS; 50mm HWR
- ㊸ OUTSIDE AIR TEMP. SENSOR WITH SUNSHIELD.

GENERAL NOTES:

1. SEE GENERAL NOTES ON SHEET M-2.

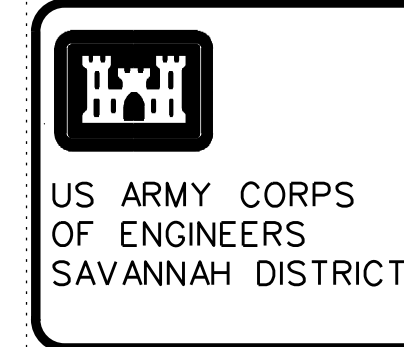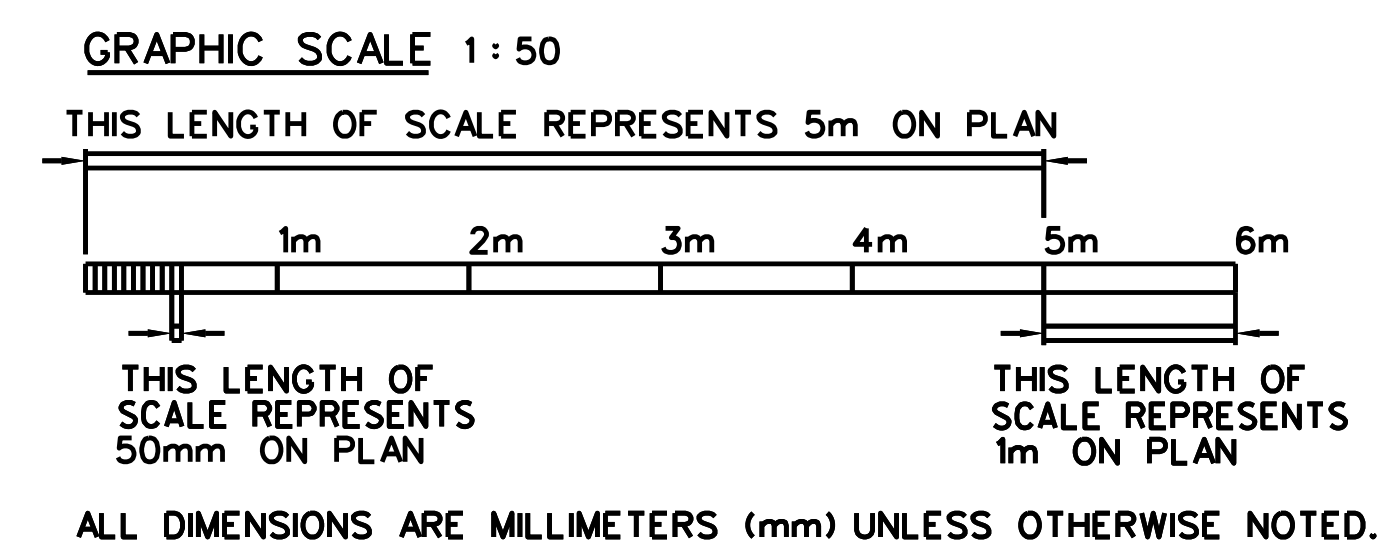

DATE	REV.
14 JUL 97	
CATEGORY CODE	721-H-11
SOLICITATION NO.	DACA2197-B-0055
PLOT DATE	14 JUL 97
PLOT SCALE	1:50
CONTRACT NO.	DACA21-98-C-0022

AS BUILT	CHANGE TEXT OF THREE KEY NOTES	GENERAL REVISIONS	DATE	BY
30 SEP 04 DGC				
08 AUG 97 SWM				
30 JUL 97 SWM				

RANGER BARRACKS COMPLEX FORT BENNING, GEORGIA	DINING FACILITY ENLARGED HVAC PLANS
--	--

PLATE REFERENCE NUMBER:
M-7 SHEET 329

AIR HANDLING UNIT COIL PIPING
SINGLE COIL CONNECTION

NOT TO SCALE

① FLOOR DRAIN. COORDINATE LOCATION WITH CONDENSATE DRAIN.
② DISTANCE = 50mm + [UNIT S.P. (Pa.) × 0.1 (mm/Pa.)]
(UNIT S.P. IS THE TOTAL UNIT STATIC PRESSURE IN Pa.)

AUTOMATIC AIR VENT
NOT TO SCALE

ELEVATION

PLAN

DUCT TEST HOLE DETAIL
NOT TO SCALE

HANGAR FOR
STAINLESS STEEL DUCT
NOT TO SCALE

LOUVER/DAMPER DETAIL

NOT TO SCALE

NOTES:

1. PROVIDE TWO ADJUSTING RODS FOR DUCTS OVER 50mm DEEP.
2. D1 AND D2 ARE THE LINEAR WIDTH OF THEIR RESPECTIVE DUCT.
3. DAMPER BLADE SHALL BE $1.5 \times$ THE SMALLER OF D1 AND D2 AND SHALL BE THE FULL DEPTH OF THE DUCT.

SUPPLY AIR DIFFUSER DETAIL

NOT TO SCALE

TYPICAL BRANCH DUCT TAKE-OFF
NOT TO SCALE

FLEXIBLE CONNECTOR
NOT TO SCALE

HOT WATER UNIT HEATER DETAIL
NOT TO SCALE

① DOUBLE THICKNESS TURNING VANES ARE TO BE INSTALLED FOR VANES OVER 914mm IN LENGTH.



US ARMY CORPS
OF ENGINEERS
SAVANNAH DISTRICT

DATE: 14JUL97	REV.
CATEGORY CODE 721-11-11	
SOLICITATION NO: DACA21-97-B-0055	
PLOT DATE: \$\$\$DATE\$\$\$\$\$	
PLOT SCALE: :	

U.S. ARMY ENGINEER DISTRICT
CORPS OF ENGINEERS
SAVANNAH, GEORGIA


[illegible]

RANGER BARRACKS COMPLEX
FORT BENNING, GEORGIA


DINING FACILITY
HVAC DETAILS

PLATE
REFERENCE
NUMBER:


M-9
ET 331

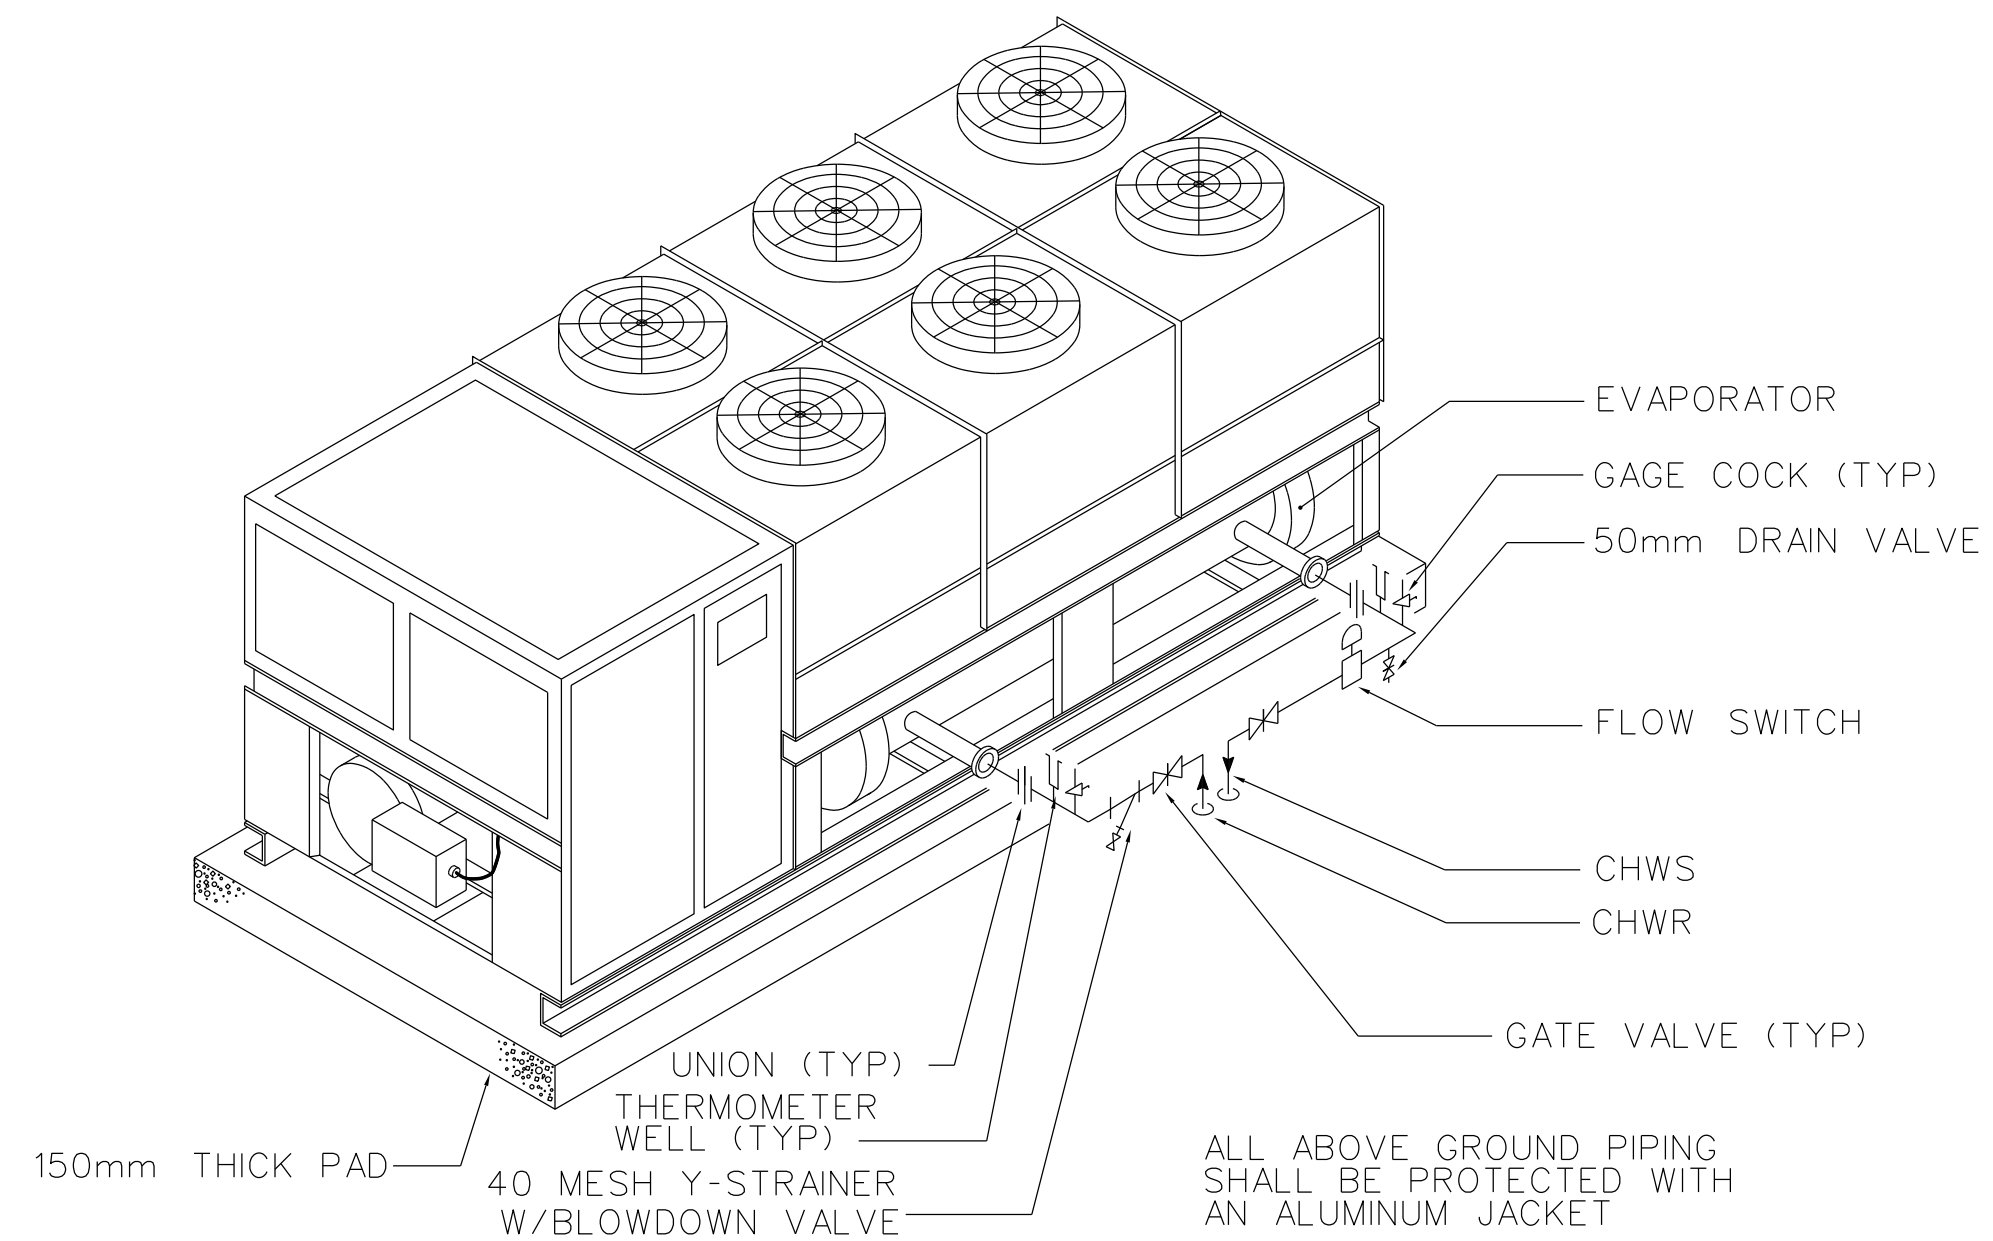

1 AIR COOLED CHILLER DETAIL
NOT TO SCALE

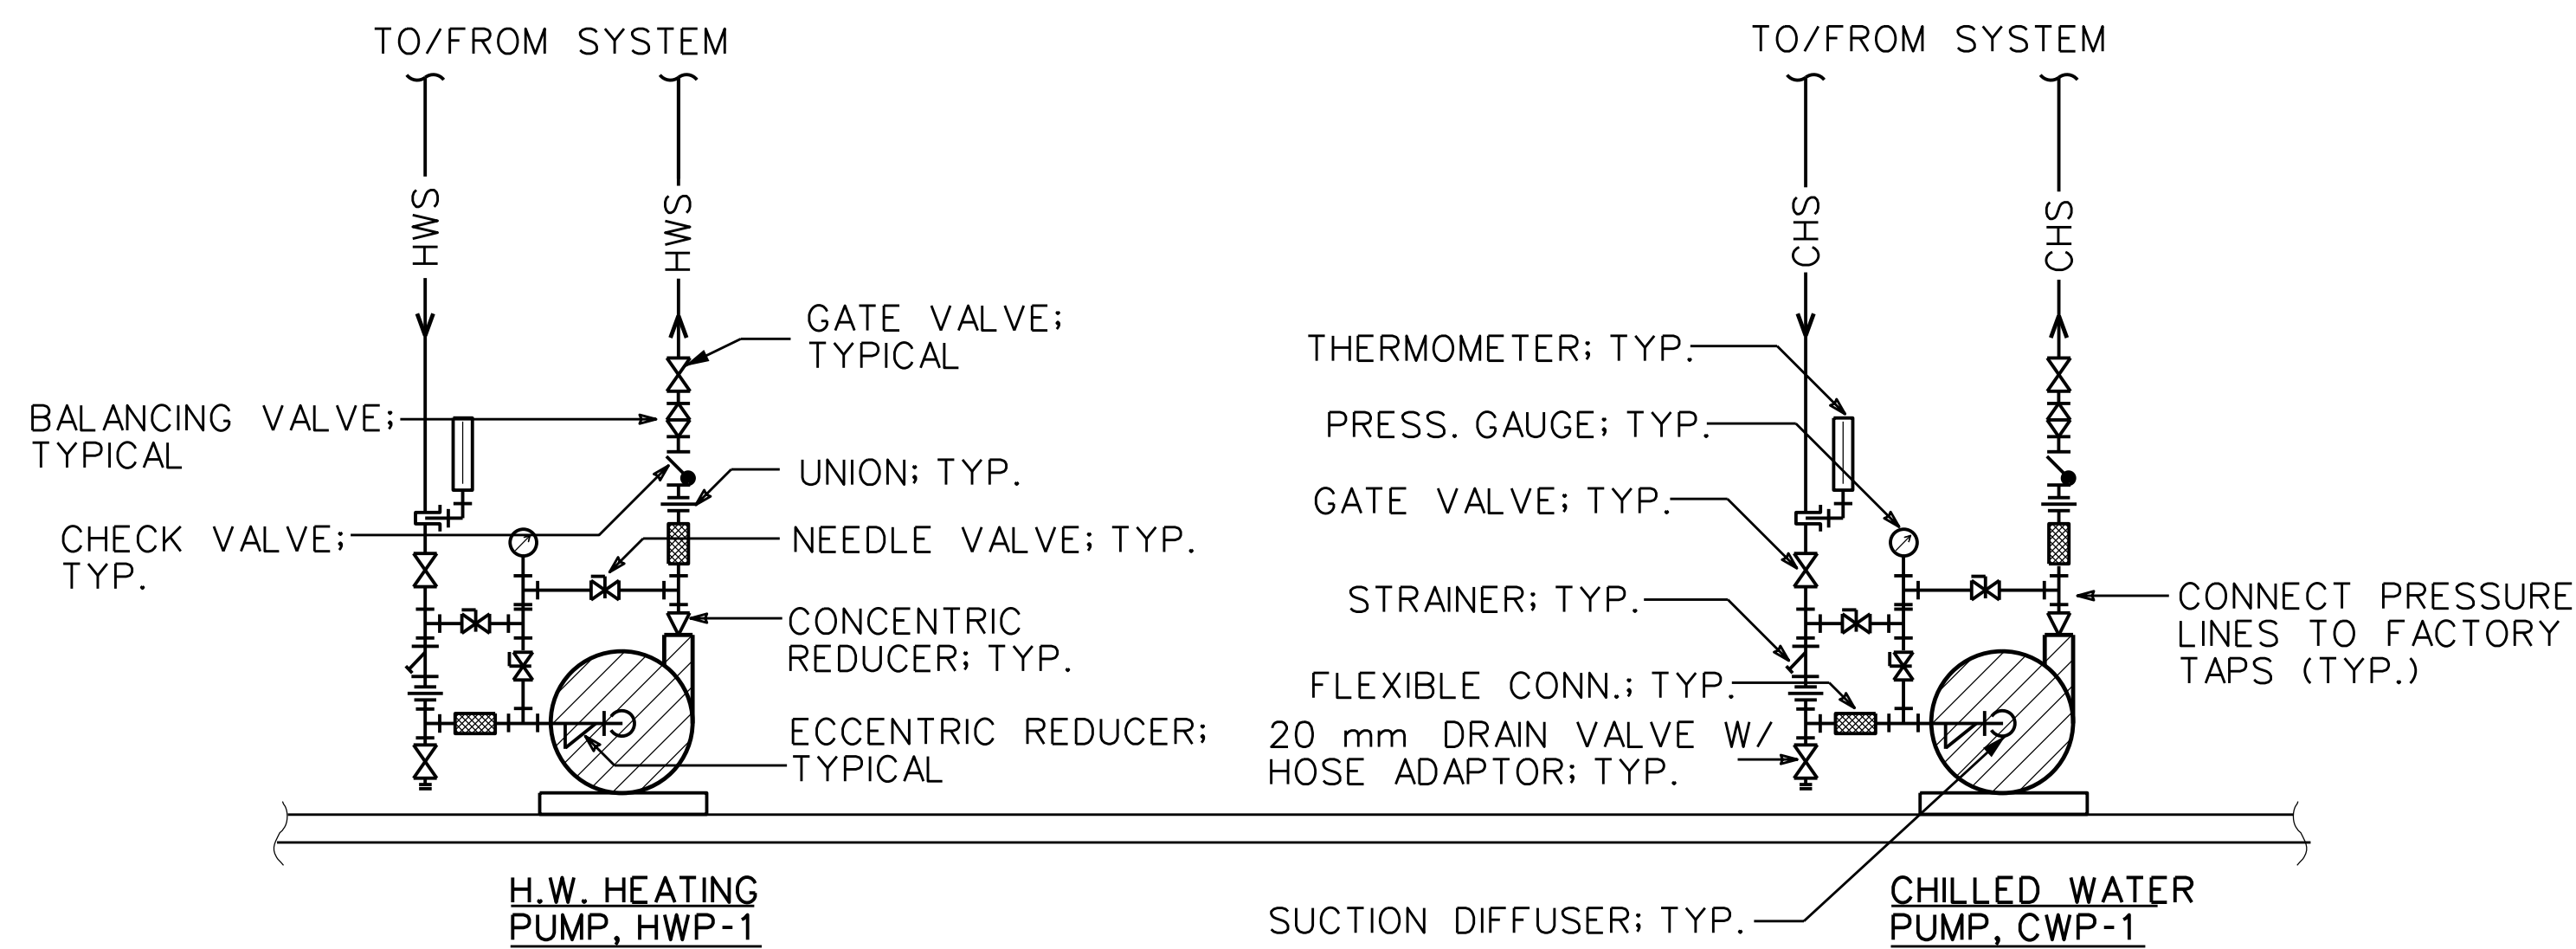


2 CHILLED AND HEATING WATER PUMP SCHEMATIC
NOT TO SCALE

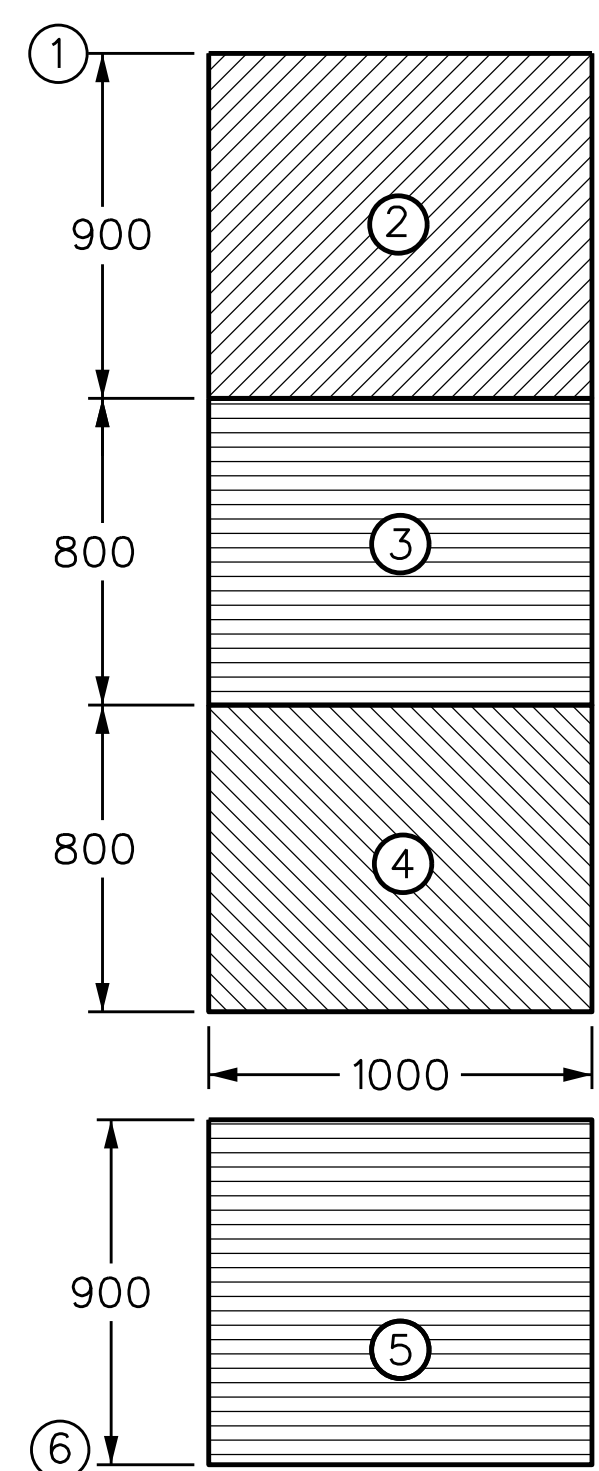

4 LOUVER PROFILE
NOT TO SCALE

KEYED NOTES:

- 1 MOUNT TOP OF LOUVER NO FURTHER THAN 300mm FROM THE BOTTOM OF THE ROOF.
- 2 900 X 1000 COMBUSTION AIR LOUVER.
- 3 800 X 1000 LOUVER WITH BAROMETRIC DAMPER. SET DAMPER AT 12.5 Pa.
- 4 800 X 1000 LOUVER WITH MOTORIZED DAMPER. INTERLOCK DAMPER WITH SF-01 OPERATION. SEE SHEET MC-7 FOR CONTROLS.
- 5 900 X 1000 COMBUSTION AIR LOUVER.
- 6 MOUNT BOTTOM OF LOUVER NO FURTHER THAN 300mm A.F.F.

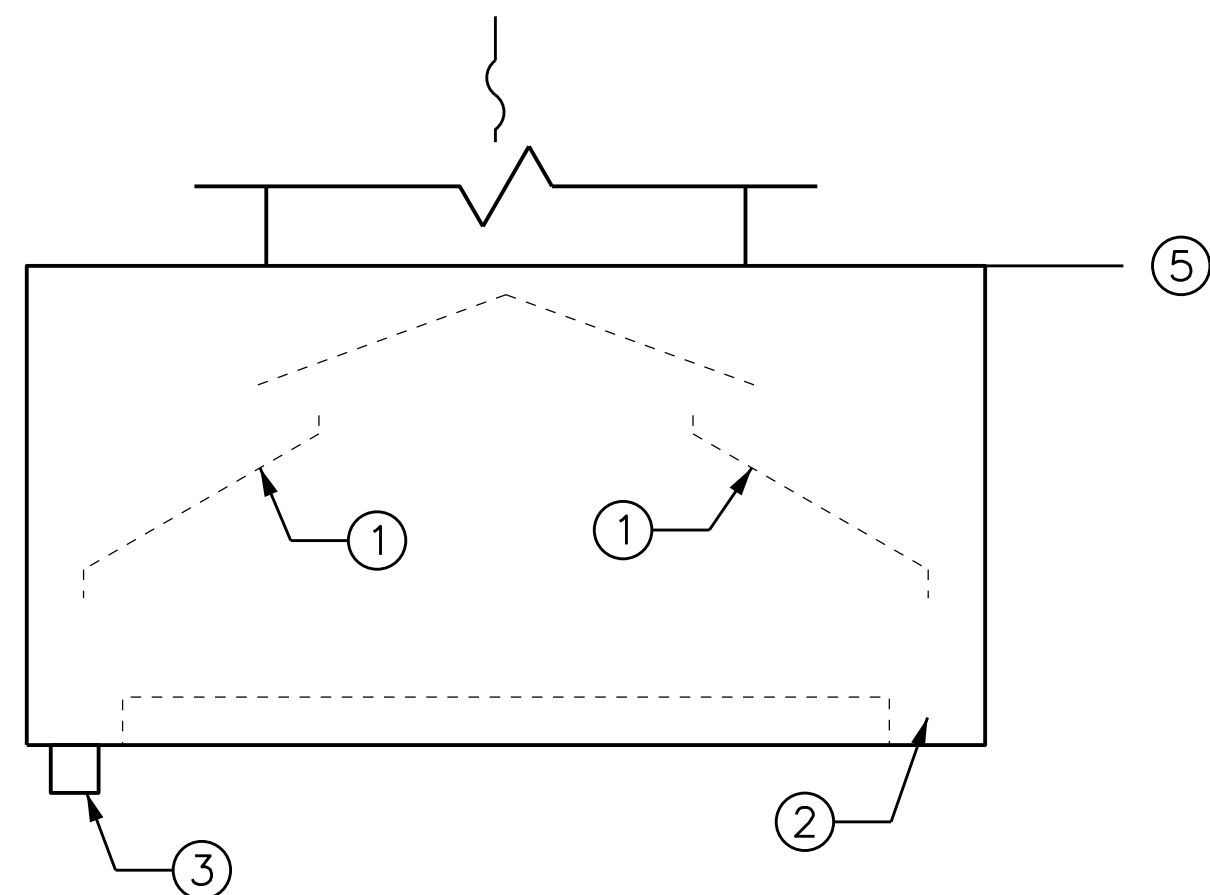


KEYED NOTES:

- 1 REMOVABLE CONDENSATE BAFFLE. NUMBER AS REQUIRED BY MFG.
- 2 CONDENSATE GUTTER
- 3 DRAIN FITTING. RUN DRAIN LINE FULL SIZE TO FLOOR SINK.
- 4 ALL HOOD COMPONENTS SHALL BE CONSTRUCTED OF STAINLESS STEEL WITH LIQUID TIGHT WELDS.
- 5 INSTALL HOOD WITH TOP AT OR ABOVE THE CEILING.


5 CONDENSATE HOOD CONSTRUCTION
NOT TO SCALE

KEYED NOTES:

- 1 AIR FROM EXHAUST HOOD
- 2 AIR TO EXHAUST FAN
- 3 ANGLE SHALL BE NO GREATER THAN 15° (TYP.).

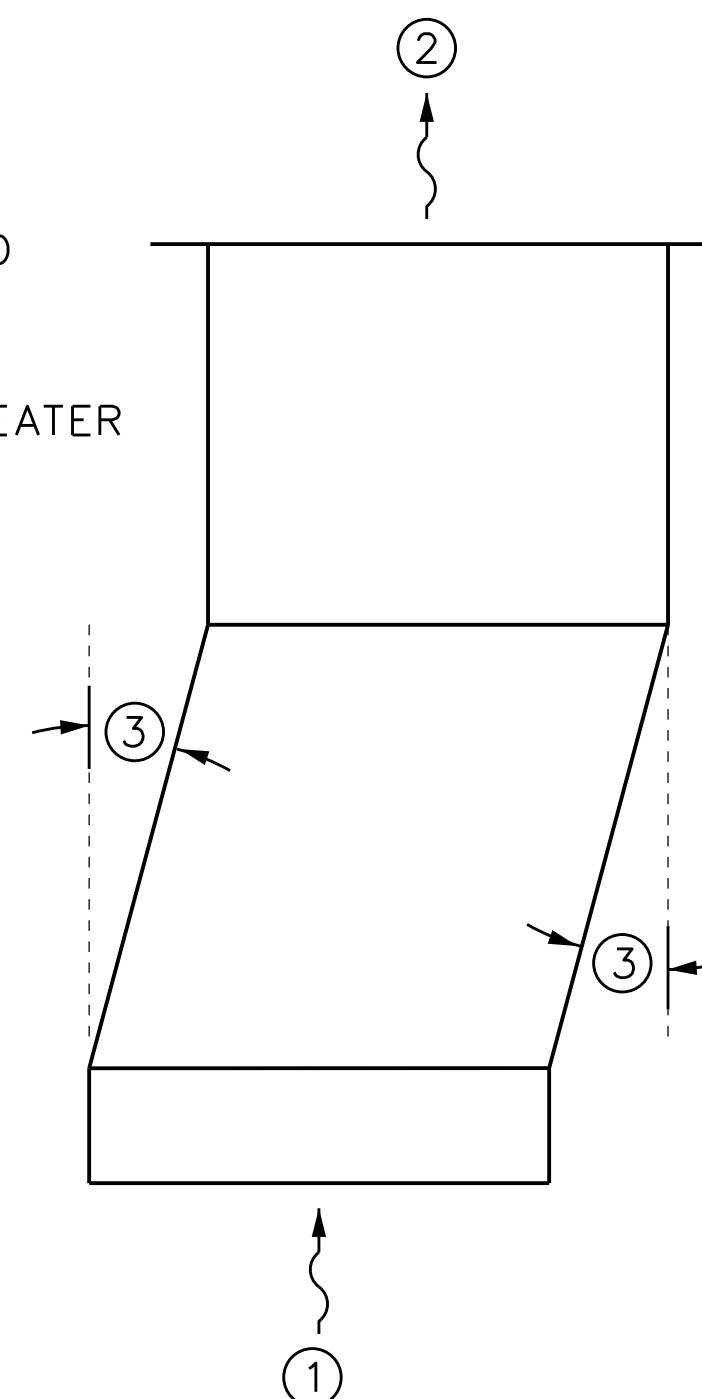


6 EXHAUST HOOD DUCT OFFSET CONSTRUCTION
NOT TO SCALE

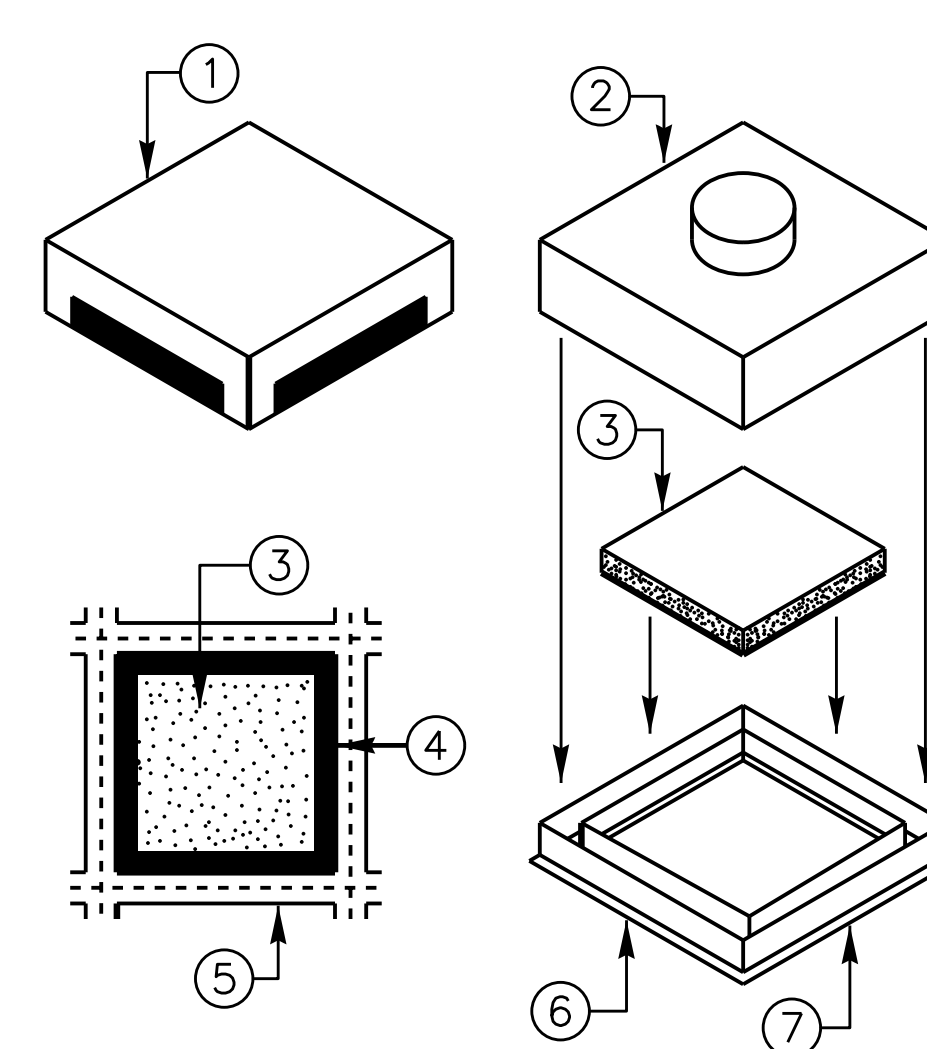

KEYED NOTES:

- 1 LIGHT BLOCKING CASING FOR RETURN AIR. INTERIOR SURFACES ARE FACTORY PAINTED BLACK.
- 2 OUTER CASING FOR SUPPLY AIR
- 3 CEILING TILE INSERT TO MATCH SURROUNDING TILE. INSERT TO BE FABRICATED BY CEILING MANUFACTURER.
- 4 SLOTS
- 5 T-BAR FOR CEILING GRID
- 6 SECURE DEVICE TO CEILING GRID
- 7 FRAME AND SLOT ASSEMBLY

7 SUPPLY DIFFUSER AND RETURN GRILLE CONSTRUCTION DETAIL
NOT TO SCALE

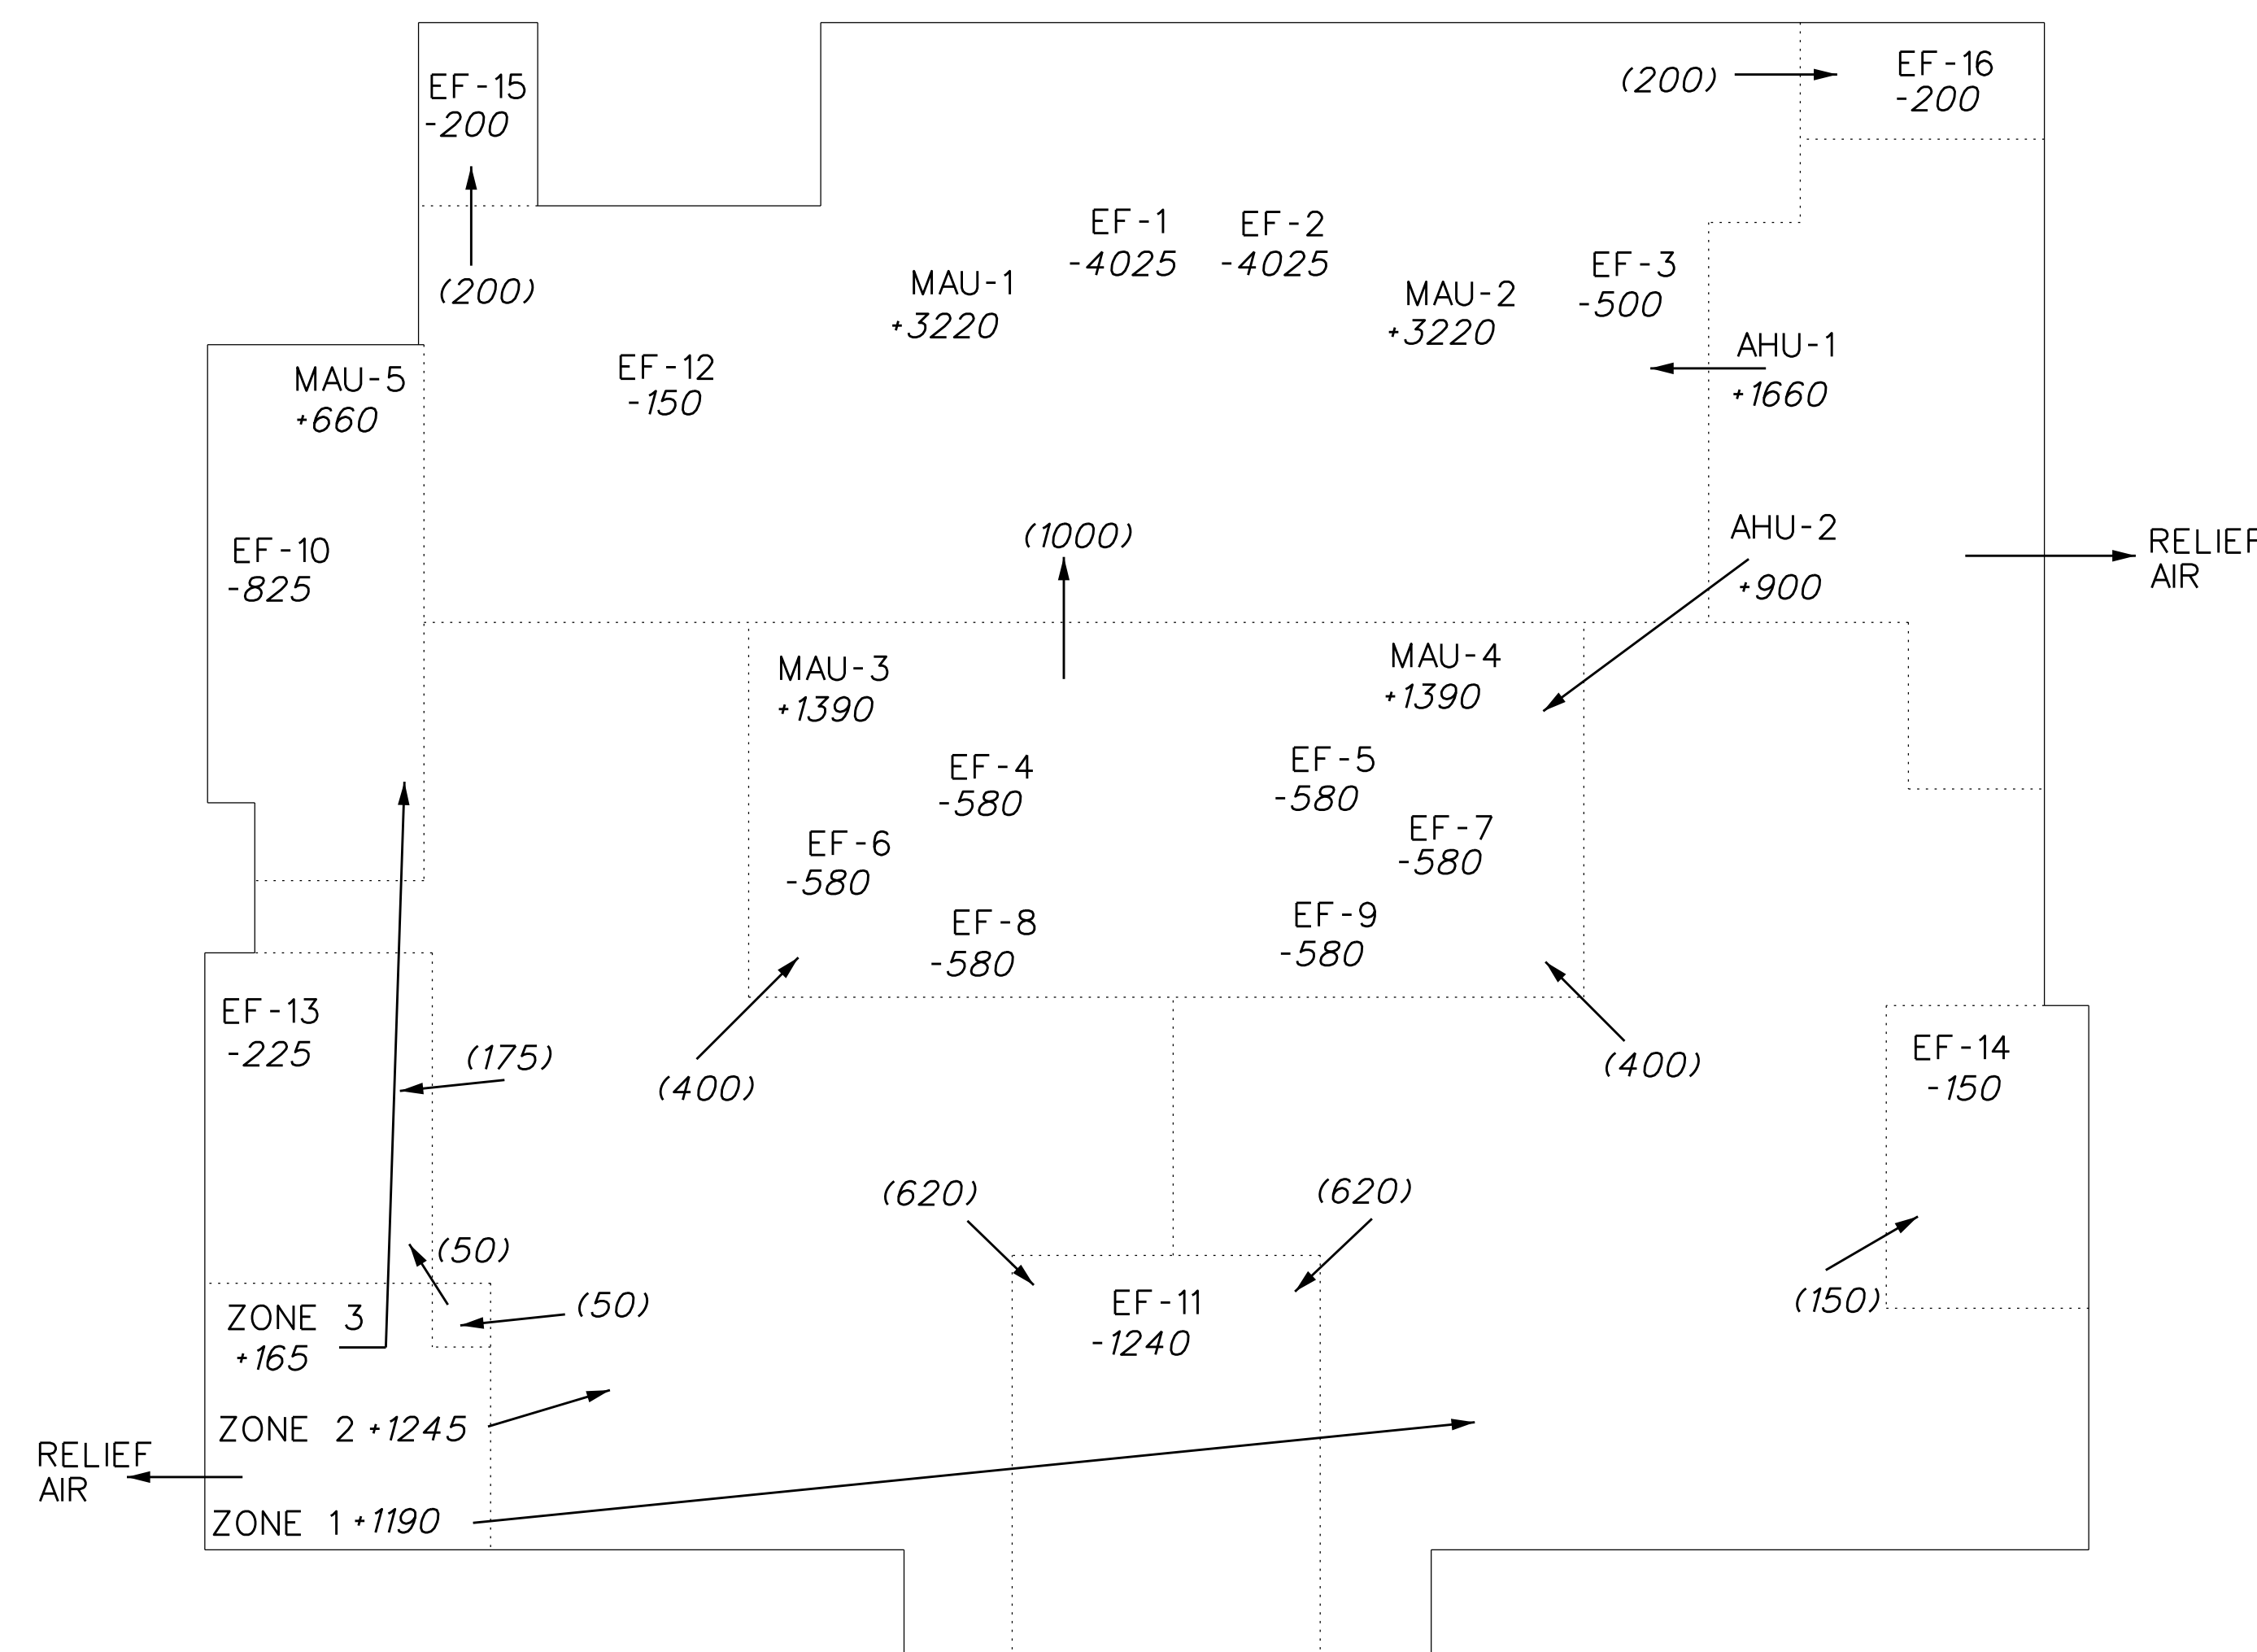

OUTSIDE AIR AND RELATIVE BUILDING PRESSURIZATION DIAGRAM NOTES:

1. ALL AIRFLOWS SHOWN ARE IN L/s.
2. WHEN EF-4, EF-5, EF-6, EF-7, EF-8 AND EF-9 ARE NOT OPERATING, AHU-2 OPERATES IN THE MINIMUM OUTSIDE AIR POSITION OF 300 L/s.
3. NOTATION: +XXX = XXX L/S OF OUTSIDE AIR IS INTRODUCED.
-YYY = YYY L/S OF AIR IS EXHAUSTED AT THIS POINT.
(ZZZ) = ZZZ L/S OF AIR IS TRANSFERRED.
4. ALL RELIEF AIR DAMPERS WILL BE SET AT 12.5 Pa.

3 OUTSIDE AIR AND RELATIVE BUILDING PRESSURIZATION DIAGRAM
NOT TO SCALE

US ARMY CORPS OF ENGINEERS SAVANNAH DISTRICT

REV.	DATE	CATEGORY CODE	SOLICITATION NO.	DATE	SCALE
1	14 JUL 97	721-H-11	DACA2197-B-0055	14 JUL 97	1:1


U.S. ARMY ENGINEER DISTRICT
CORPS OF ENGINEERS
SAVANNAH, GEORGIA

SYMBOL	DESCRIPTION	DATE	BY
30SEP04	DGC		

AS BUILT


RANGER BARRACKS COMPLEX
FORT BENNING, GEORGIA
DINING FACILITY
HVAC DETAILS

PLATE
REFERENCE
NUMBER:
M-10
SHEET 332

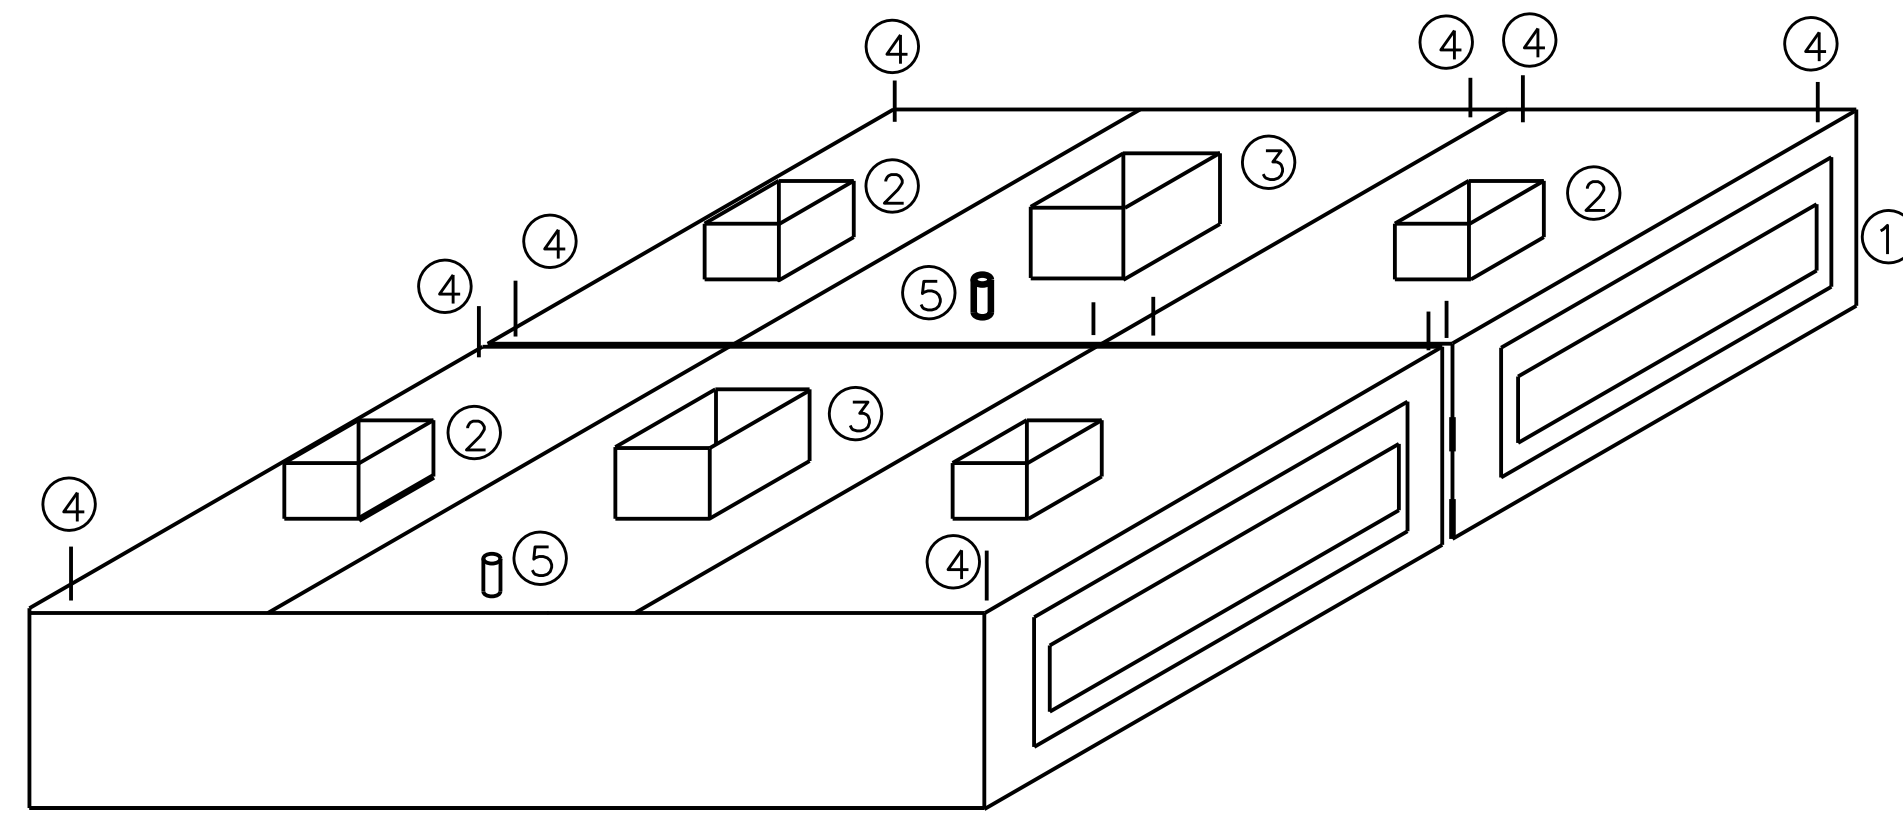


- 1 FIXED LOUVER SUPPLY HORIZONTAL DISCHARGE
- 2 SUPPLY AIR DUCT COLLAR
- 3 EXHAUST DUCT COLLAR
- 4 SUPPORTING ELEMENTS TIE TO STRUCTURE ABOVE
- 5 WATER WASH PIPING STUB OUT

1 ISLAND TYPE CANOPY HOOD
NOT TO SCALE

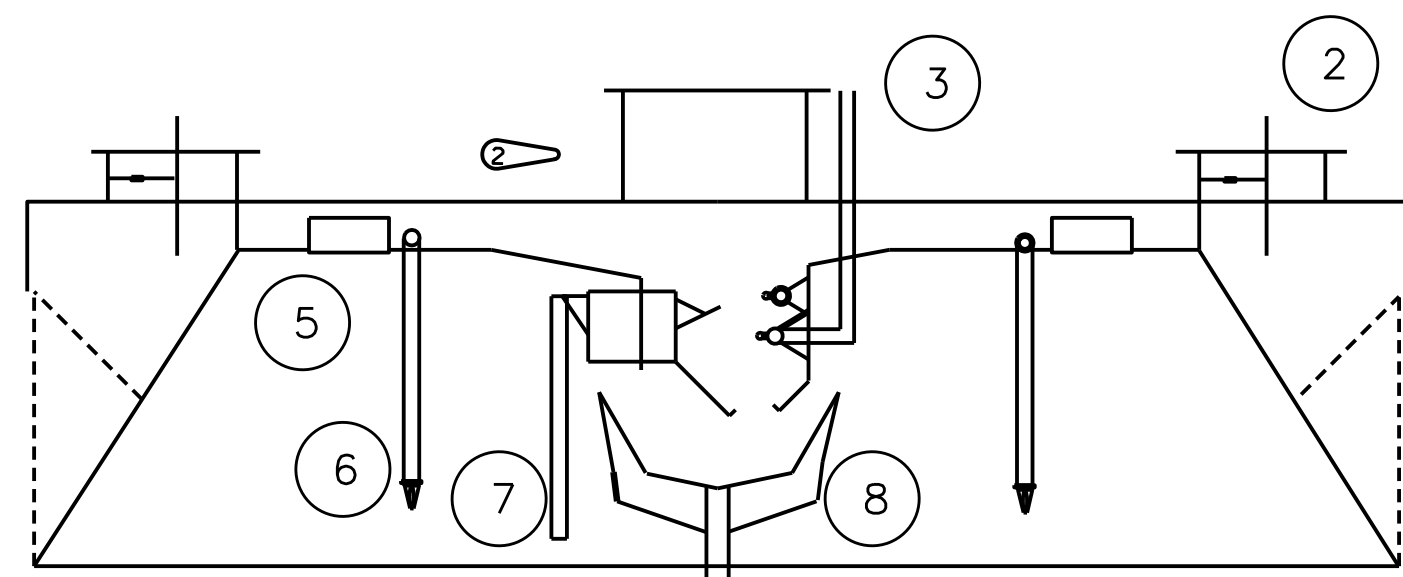

- 1 SUPPLY GRILLE FIXED LOUVER TYP.
- 2 FUSIBLE LINK DAMPER IN SUPPLY DUCT
- 3 WATER WASH PIPING AND WATER FLOW NOZZLES
- 4 NOT USED
- 5 RECESSED FLUORESCENT LIGHTING TYP.
- 6 FIRE SUPPRESSION PIPING
- 7 DAMPER RESET LEVER
- 8 GREASE COLLECTION TROUGH WITH DRAIN


4 ISLAND TYPE CANOPY HOOD SECTION
NOT TO SCALE

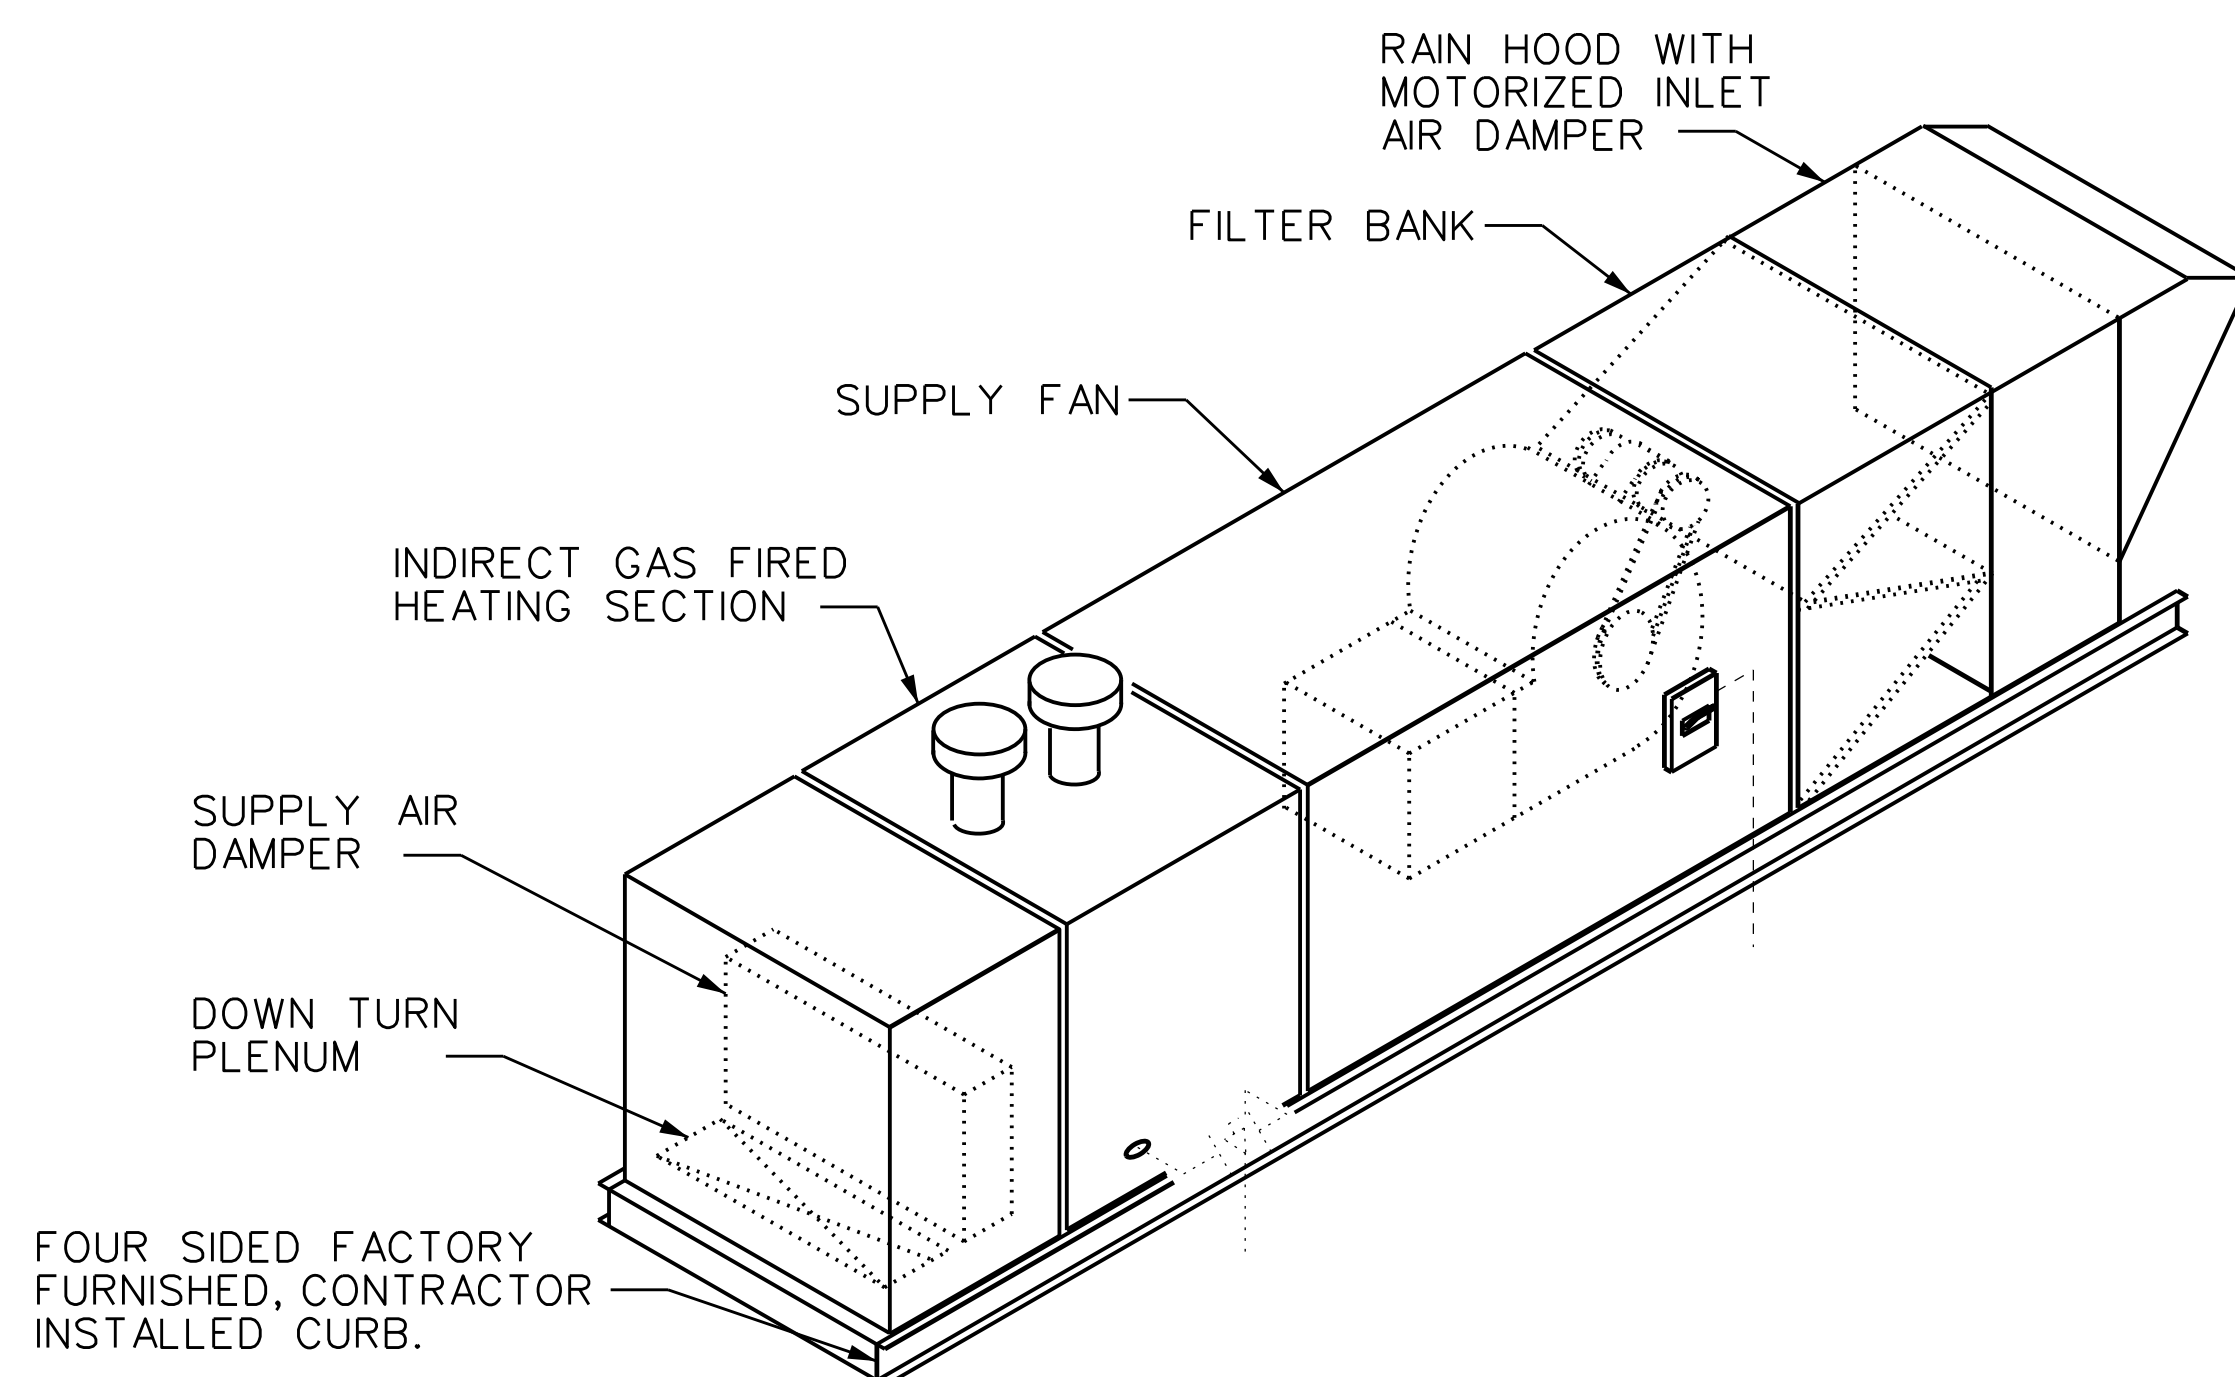

6 MAKE-UP AIR UNIT WITH GAS FURNACE
NOT TO SCALE


GENERAL NOTES:

1. PIPING AND CONDUIT SHALL PENETRATE ROOF INSIDE CURB AS SHOWN AND REMAIN INSIDE THE UNIT.
2. UNIT SHALL HAVE A WEATHER-PROOF HOUSING.


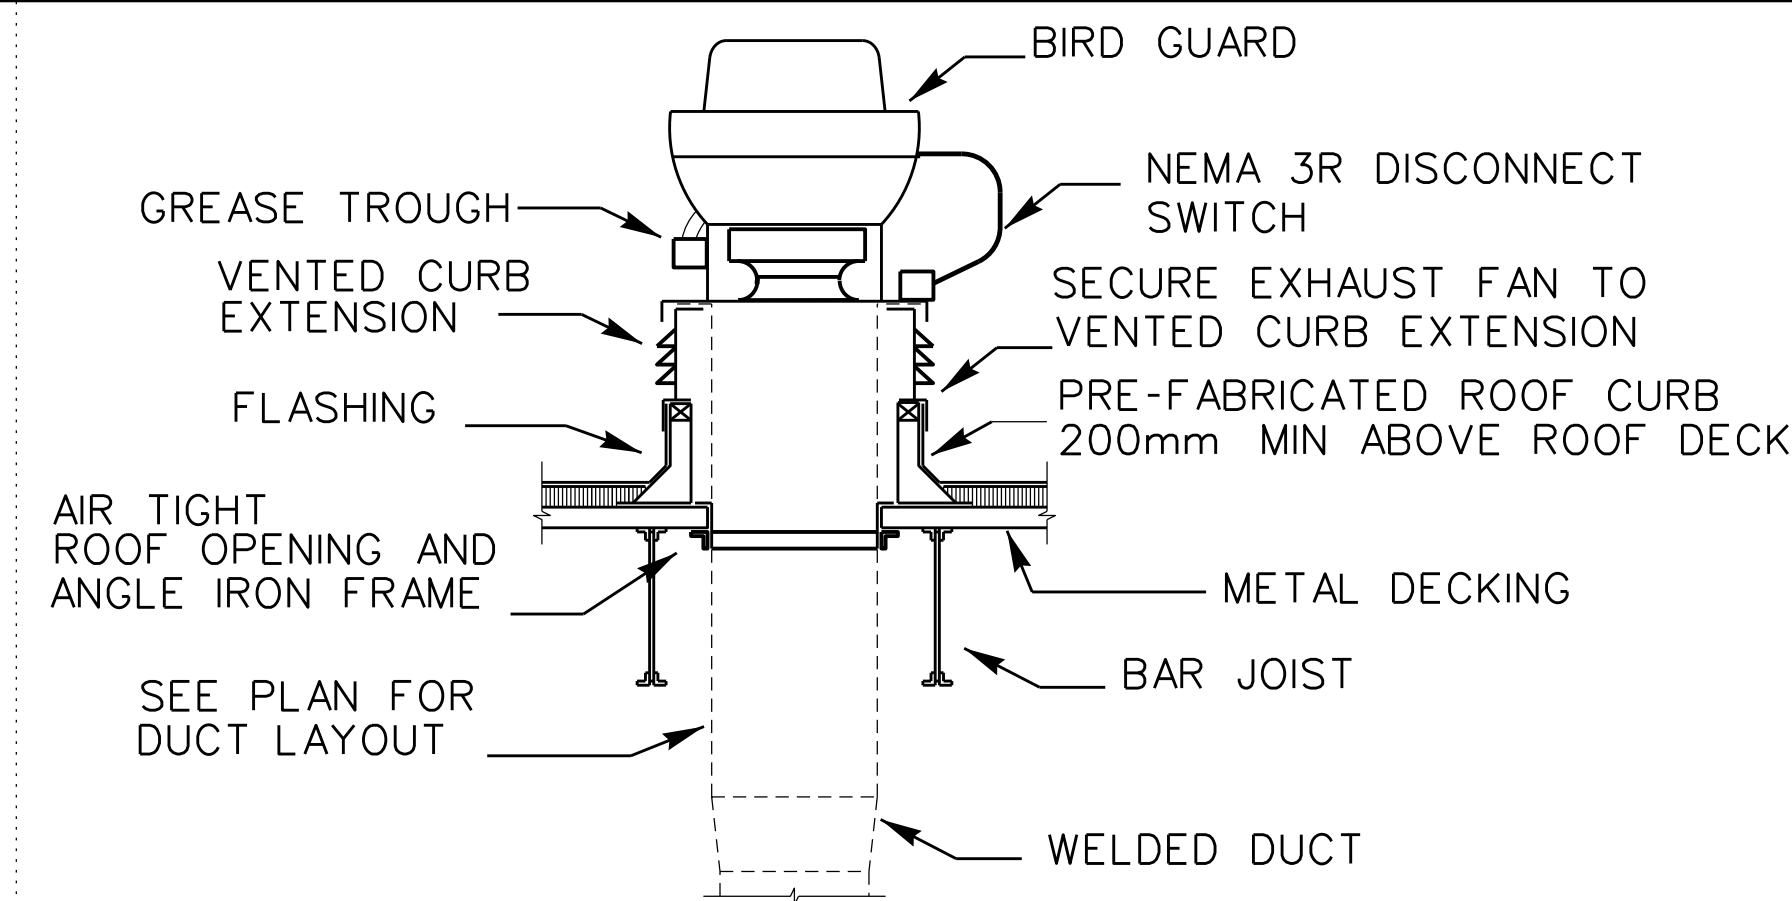


- NOTES:
1. FAN CURB AND FLASHING SHALL MATCH COLOR OF ROOF.
 2. PROVIDE HINGED CONNECTION IN ACCORDANCE WITH NFPA 96-1994 PARAGRAPH 4-8.2.1.
 3. MINIMUM DISCHARGE HEIGHT 1000mm ABOVE ROOF DECK

2 UPBLAST EXHAUST FAN FOR GREASE LAIDEN AIR INSTALLATION
NOT TO SCALE


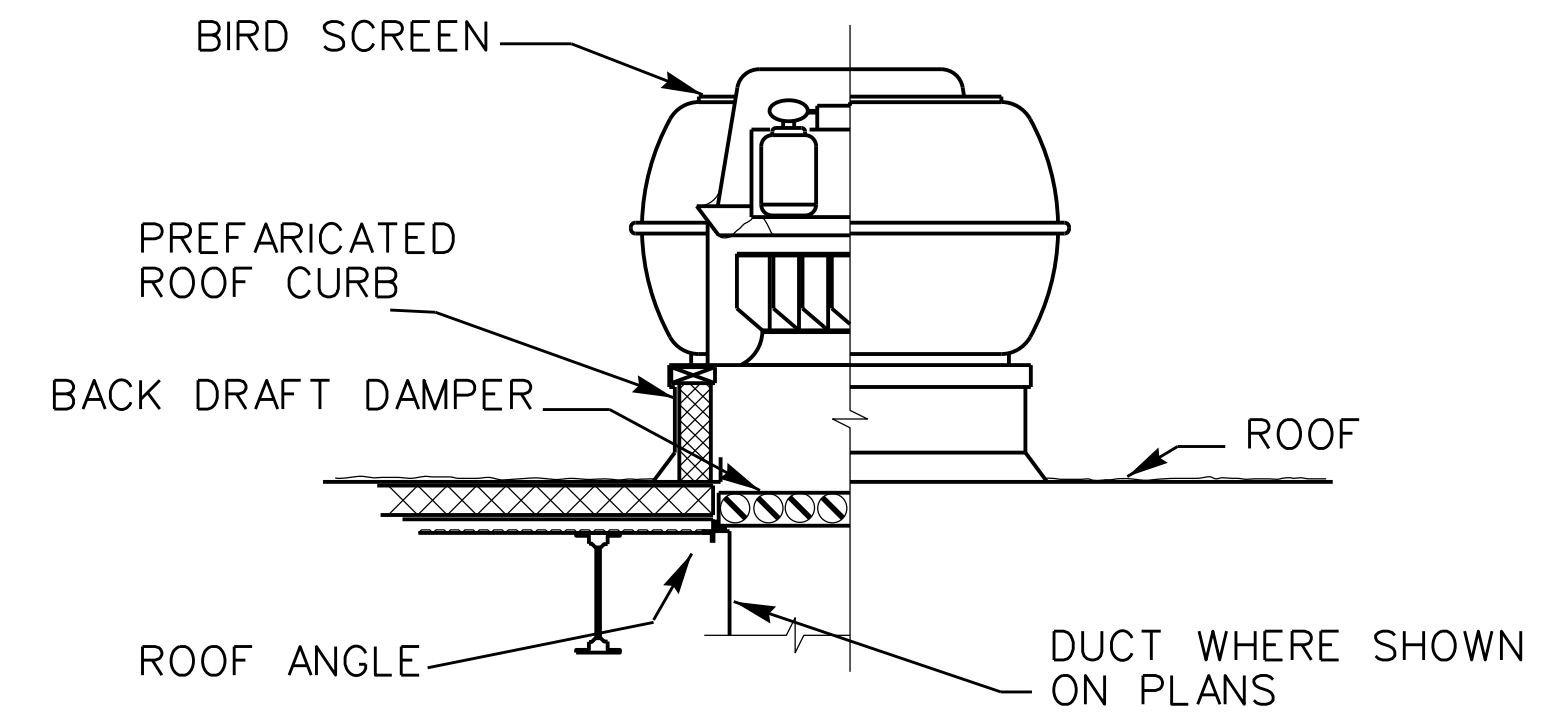


3 EXHAUST FAN FOR NON-GREASE LAIDEN AIR
NOT TO SCALE

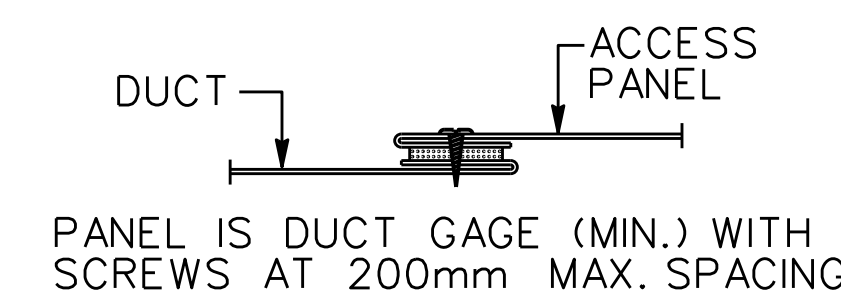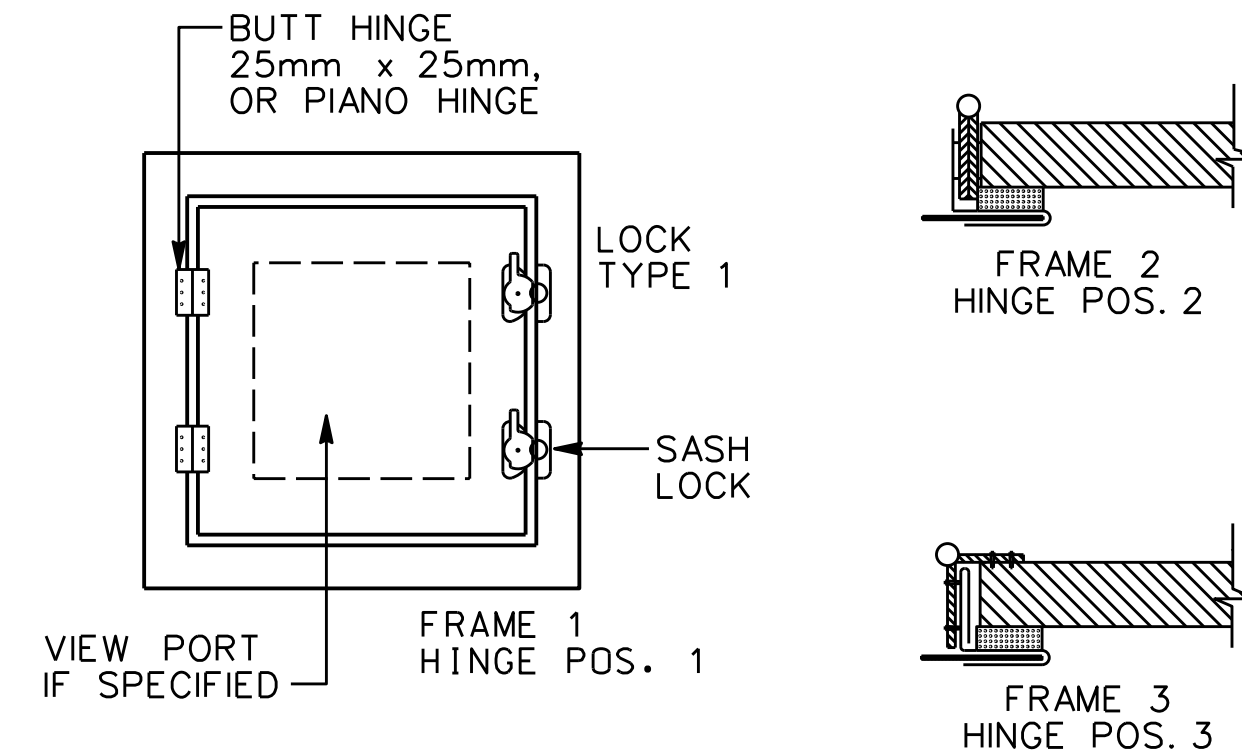


DUCT PRESSURE CLASS	DOOR SIZE	NO. HINGES	NO. LOCKS	METAL GAGE		
				FRAME	DOOR	BACK
500 PASCAL STATIC AND LESS	300mm x 300mm	2	1-S	24	26	26
	400mm x 500mm	2	2-S	22	24	26
	600mm x 600mm	3	2-S	22	22	26
750 PASCAL STATIC	300mm x 300mm	2	1-S	22	22	26
	400mm x 500mm	2	1-S, 1-T, 1-B	20	20	26
	600mm x 600mm	3	2-S, 1-T, 1-B	20	20	24
1000 PASCAL TO 2500 PASCAL	300mm x 300mm	2	1-S, 1-T, 1-B	20	20	26
	400mm x 500mm	3	2-S, 1-T, 1-B	18	18	24
	600mm x 600mm	3	2-S, 2-T, 2-B	18	18	24

S = SIDE OPPOSITE HINGES, T = TOP, B = BOTTOM

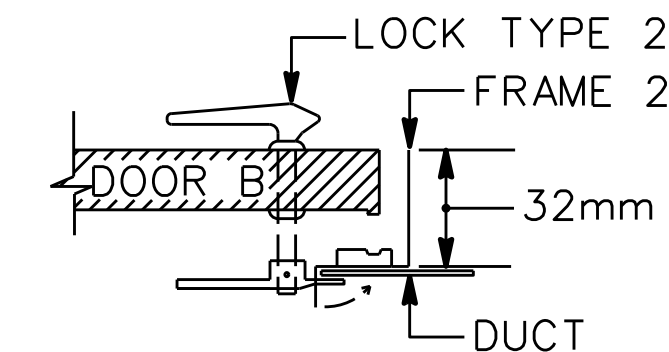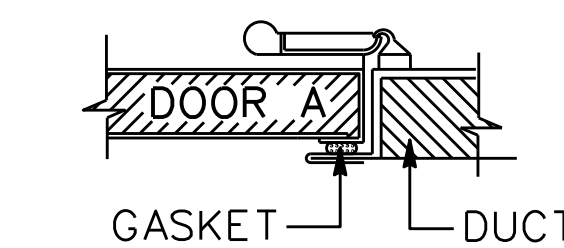

5 DUCT ACCESS DOOR DETAIL
NOT TO SCALE

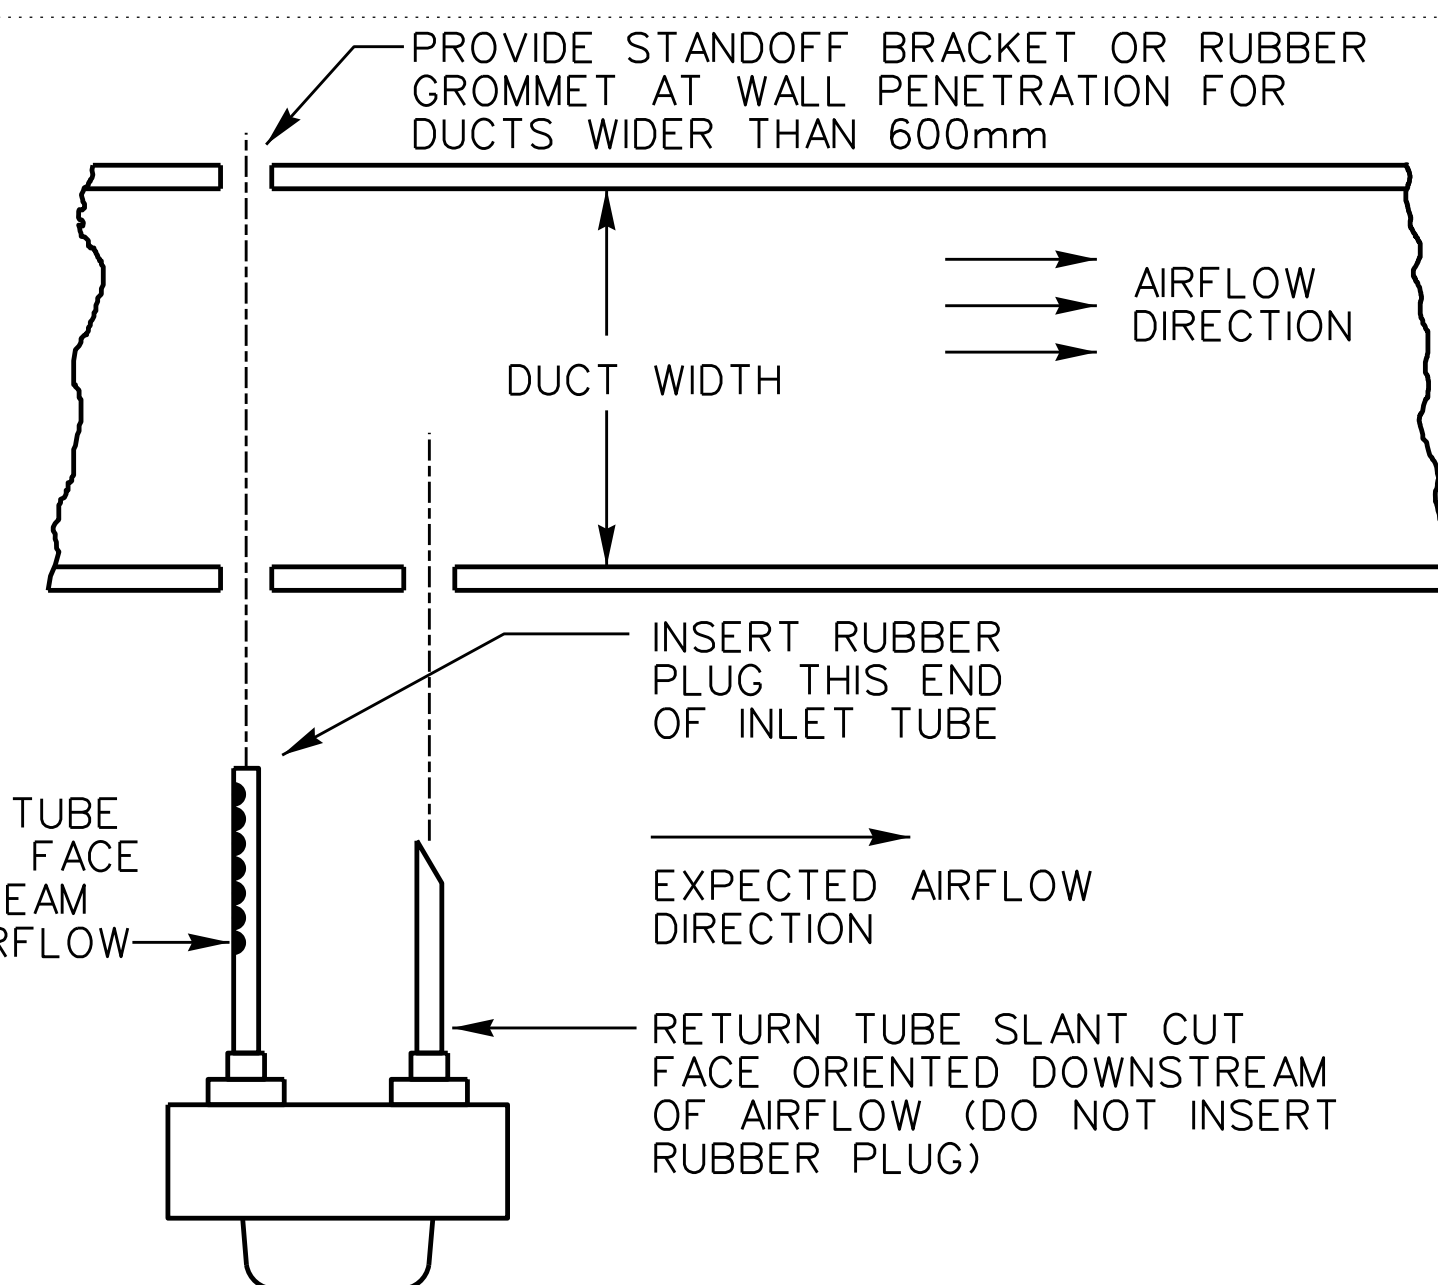

INSTALLATION NOTE:
MOUNT 6 TO 10 DUCT DIAMETERS DOWN/UPSTREAM OF ANY FITTING/COIL/DAMPER/FILTER

7 DUCT SMOKE DETECTOR
NOT TO SCALE

EQUIPMENT TYPE	SLAB ON GRADE			OTHER		
	BASE TYPE	ISOLATOR TYPE	MIN. DEFL.	BASE TYPE	ISOLATOR TYPE	MIN. DEFL.
PUMPS UP TO 5.5kW	B	2	18mm	B	3	18mm
PUMPS UP TO 30kW	B	3	18mm	B	3	18mm
ROOFTOP AHU'S AND MAU'S	-	-	-	B	4	18mm
INDOOR AHU'S UP TO 7.5kW	A	2	5mm	A	3	18mm
INDOOR AHU'S OVER 7.5kW	A	2	5mm	A	3	38mm
TANK-MOUNTED AIR COMPRESSOR	A	3	18mm	A	3	38mm
CENTRIFUGAL FAN UP TO 560mm DIA.	-	-	-	A/B	3	18mm
CENTRIFUGAL FAN OVER 560mm DIA.	-	-	-	B	3	38mm

BASE TYPES:
A = NO BASE, ISOLATOR ATTACHED DIRECTLY TO EQUIPMENT
B = STRUCTURAL STEEL RAILS OR FRAME

ISOLATOR TYPES:
1 = NEOPRENE OR FIBERGLASS PAD
2 = HIGH DEFLECTION NEOPRENE OR FIBERGLASS ELEMENT
3 = SPRING MOUNT OR HANGER
4 = RESTRAINED SPRING ISOLATOR

US ARMY CORPS OF ENGINEERS SAVANNAH DISTRICT

DATE: 14 JUL 97	REV.
CATEGORY CODE 721-11-11	
SOLICITATION NO. DAC2197-B-0055	
PLOT DATE: 14 JUL 97	
PLOT SCALE: 1	


CONTRACT NO: DAC21-98-C-0022

U.S. ARMY ENGINEER DISTRICT CORPS OF ENGINEERS SAVANNAH, GEORGIA

30 SEP 04	DCC
08 AUG 97	SWM
AS BUILT	REMOVED NOTE 4 FROM DETAIL 4
SYMBOL	DESCRIPTION

RANGER BARRACKS COMPLEX
FORT BENNING, GEORGIA
DINING FACILITY
HVAC DETAILS

PLATE REFERENCE NUMBER:
M-11
SHEET 333

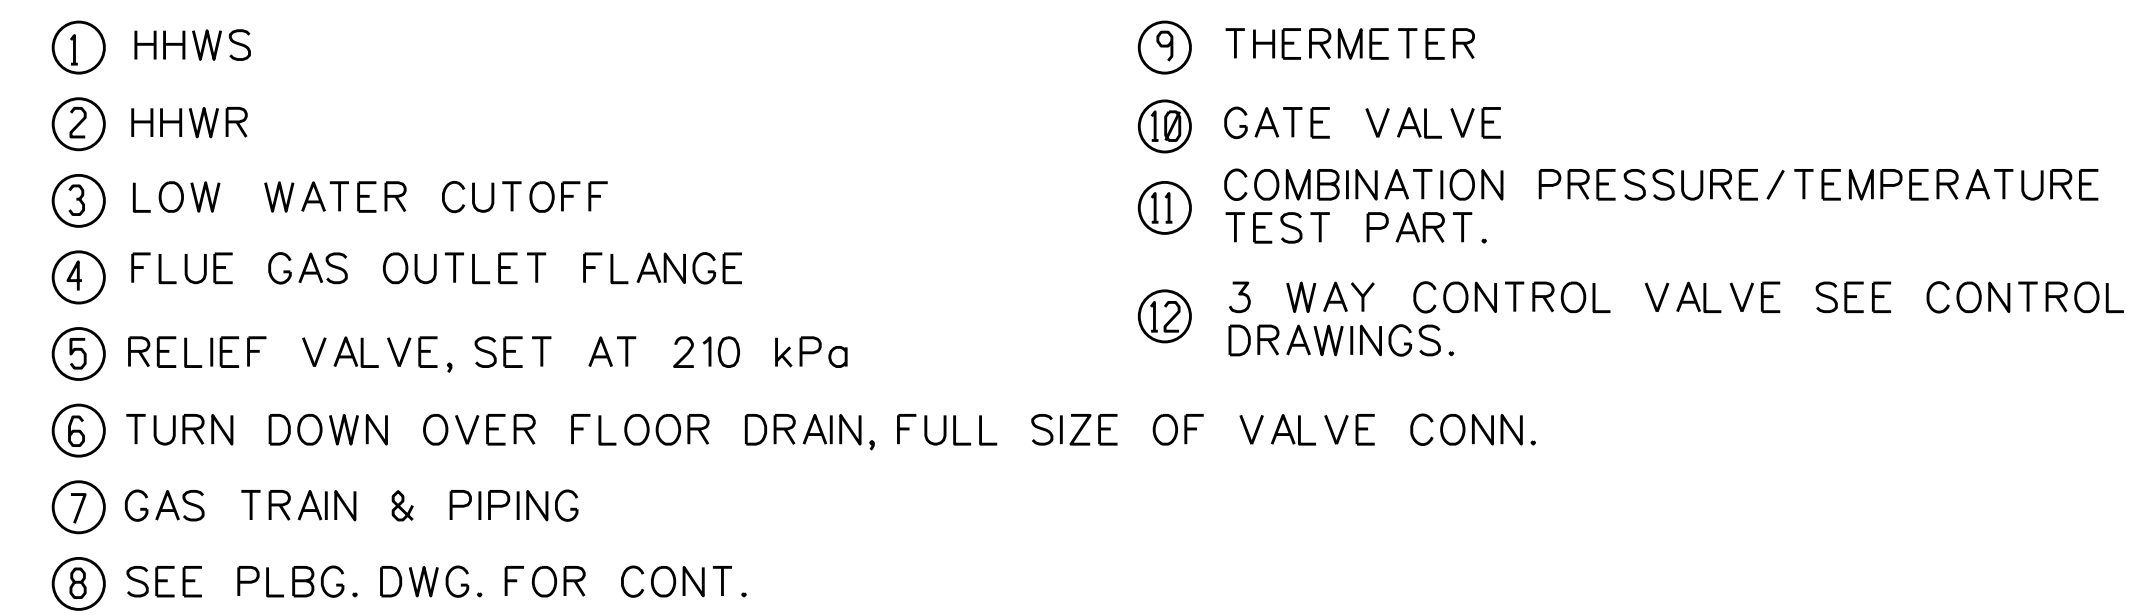

REMOVABLE SCREEN

135 deg

450mm MIN

SMACNA GOOSENECK


ROOF CURB AND FLASHING

ROOF

EXHAUST DUCT

BASE BID

2 ROOF MOUNT GOOSENECK DETAIL
TYPM12 NOT TO SCALE

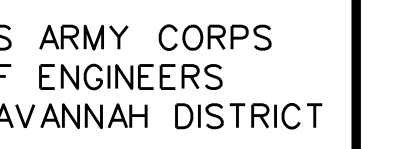

14-JUL-97	CATEGORY CODE 721-11-11
SOLICITATION NO: DACA21-97-B-0055	
PLOT DATE: \$\$\$DATE\$\$\$\$\$	
PLOT SCALE: :	
CONTRACT NO: DACA21-98-C-0055	

CORPS OF ENGINEERS
SAVANNAH, GEORGIA

	(U)	AS BUILT	30SEP04	DGC
		SHEET ADDED BY AMENDMENT 0001	30SEP04	SW
		DESCRIPTION	DATE	BY


DINING FACILITY
HVAC DETAILS

PLATE
REFERENCE
NUMBER:

M-12

SHEET 334



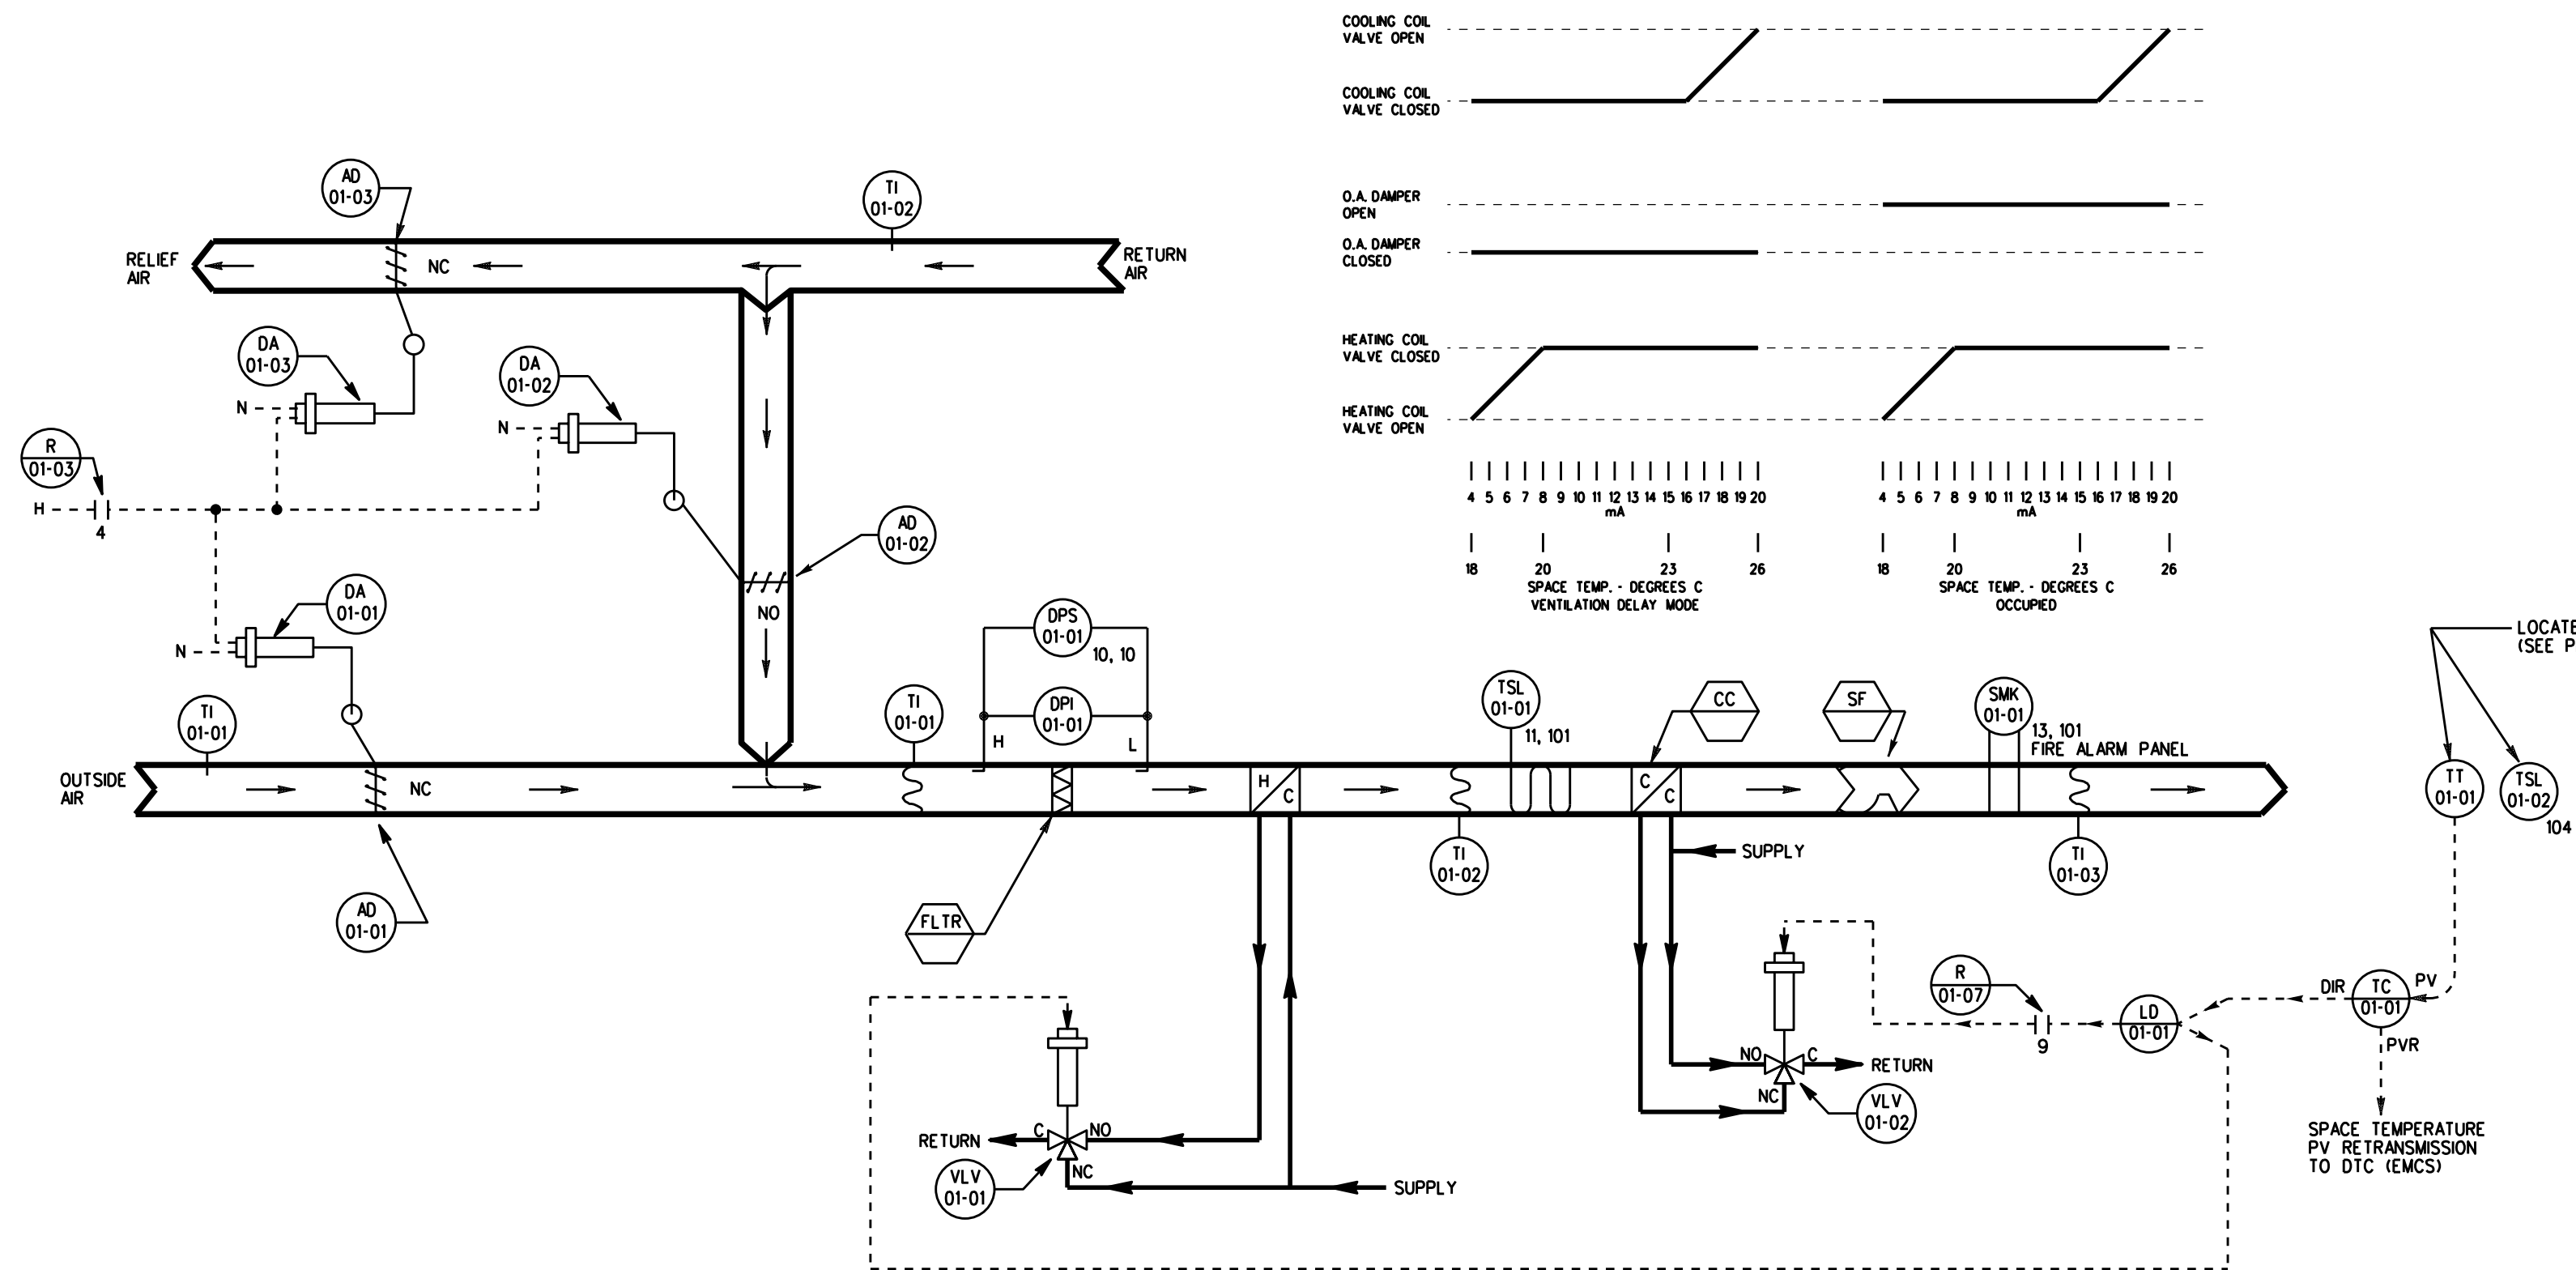

Single Zone Unit AHU-1 Sequence of Operation

Occupied, Unoccupied and Ventilation-Delay Modes:
Ventilation-delay mode timing shall start prior to the occupied-mode timing. The time clock shall close a contact, which shall turn on the ventilation-delay pilot light and energize a relay which shall prevent the outside air damper from opening. At the time shown, the clock shall close another contact which shall turn on the occupied mode pilot light and shall place the control system in the occupied mode of operation. At the expiration of the ventilation-delay mode timing period, the time clock shall open the contact to turn off the ventilation-delay mode pilot light and de-energize a relay to allow the outside air damper to open. At the time shown, the time clock shall open the contact to turn off the occupied mode pilot light and shall place the control system in the unoccupied mode of operation.

Outside-air, Return-air, and Relief-air Damper Control:
Occupied mode: The outside-air and relief-air dampers shall open fully and the return-air damper shall close.

Unoccupied and Ventilation-delay modes: The outside-air, return-air and relief-air dampers shall return to their normal positions as shown.

Supply fan control:
Occupied and ventilation-delay modes: Supply fan shall start and shall run continuously.
Unoccupied mode: The supply fan shall cycle from a night-thermostat. The fans shall start at and stop at the setpoints as shown.

Heating and cooling coil control:
A space-temperature sensing element and transmitter operating through a space-temperature controller shall maintain the setpoint by sequencing the valves as shown. On a rise in space temperature, the space-temperature controller shall first gradually close the heating-coil valve. After the controller output passes through a deadband, the controller shall then gradually open the cooling-coil valve; except that, during Unoccupied mode, the cooling coil valve shall remain closed.

Filter:
A differential-pressure switch across the filter shall turn on the filter pilot light when the pressure drop across the filter reaches the setpoint.


Freeze Protection:
All Modes - A freeze stat, located as shown, shall stop the supply fan, cause the outside air, return air, and relief air dampers to return to their normal position as shown, and shall turn on the low-temperature pilot light in the HVAC control panel if the temperature drops below the freeze stat's setpoint as shown. Return to the normal mode of operation shall require manual reset at the freeze stat and at the HVAC control panel.

Emergency Fan Shutdown:
Activation of a duct smoke detector in the supply-air ductwork, or activation of a manual emergency fan shutdown switch shall cause the associated fan to shutdown in accordance with NFPA 90A. Activation of these devices shall operate a pilot light on the HVAC control panel. The panel shall require manual resetting after the detector and the manual switch are reset.


Exhaust fans EF-3, EF-12, EF-15 & EF-16:
Exhaust fans EF-3, EF-12 and EF-15 shall run continuously whenever AHU-1 is operating in occupied mode and ventilation-delay mode is off.
Exhaust fan EF-16 shall run continuously.

LOOP CONTROL FUNCTION	DEVICE NUMBER	DEVICE FUNCTION	SETPOINT	RANGE	ADDITIONAL PARAMETERS
SPACE TEMPERATURE	DA-01-01	DAMPER ACTUATOR	—	TWO-POSITION	—
	DA-01-02				
	DA-01-03				
	DPS-01-01	FILTER ALARM	PER FILTER MANUFACTURER'S RECOMMENDATION	PER FILTER MANUFACTURER'S RECOMMENDATION	—
	VLV-01-01	HEATING COIL VALVE	—	4 - 8 mA	Kv = 21 CLOSE AGAINST 25 kPa
	VLV-01-02	COOLING COIL VALVE	—	16 - 20 mA	Kv = 15 CLOSE AGAINST 130 kPa
	TC-01-01	SPACE TEMPERATURE CONTROLLER	24°C	10 TO 30 °C	—
	TT-01-01	SPACE TEMPERATURE TRANSMITTER	—	10 TO 30 °C	—
MIXED AIR TEMPERATURE	TSL-01-01	LOW TEMPERATURE PROTECTION THERMOSTAT	4°C	2.8°C DIFFERENTIAL	—
SPACE LOW TEMPERATURE	TSL-01-02	NIGHT STAT - SPACE LOW TEMPERATURE PROTECTION	13°C	2.8°C DIFFERENTIAL	—
OCCUPIED MODE	CLK-01-01 CONTACT	365 DAY SCHEDULE	—	WEEKDAY SCHEDULE CLOSED: 0600 HRS OPEN: 2000 HRS	SAT, SUN, HOLIDAY SCHEDULE
VENTILATION DELAY MODE	CLK-01-01 CONTACT	365 DAY SCHEDULE	—	WEEKDAY SCHEDULE CLOSED: 0600 HRS OPEN: 0700 HRS	—


NOTE: OTHER CONTROL DEVICES SUCH AS I/Ps, RELAYS, AND SIGNAL SELECTERS ARE NOT SHOWN.

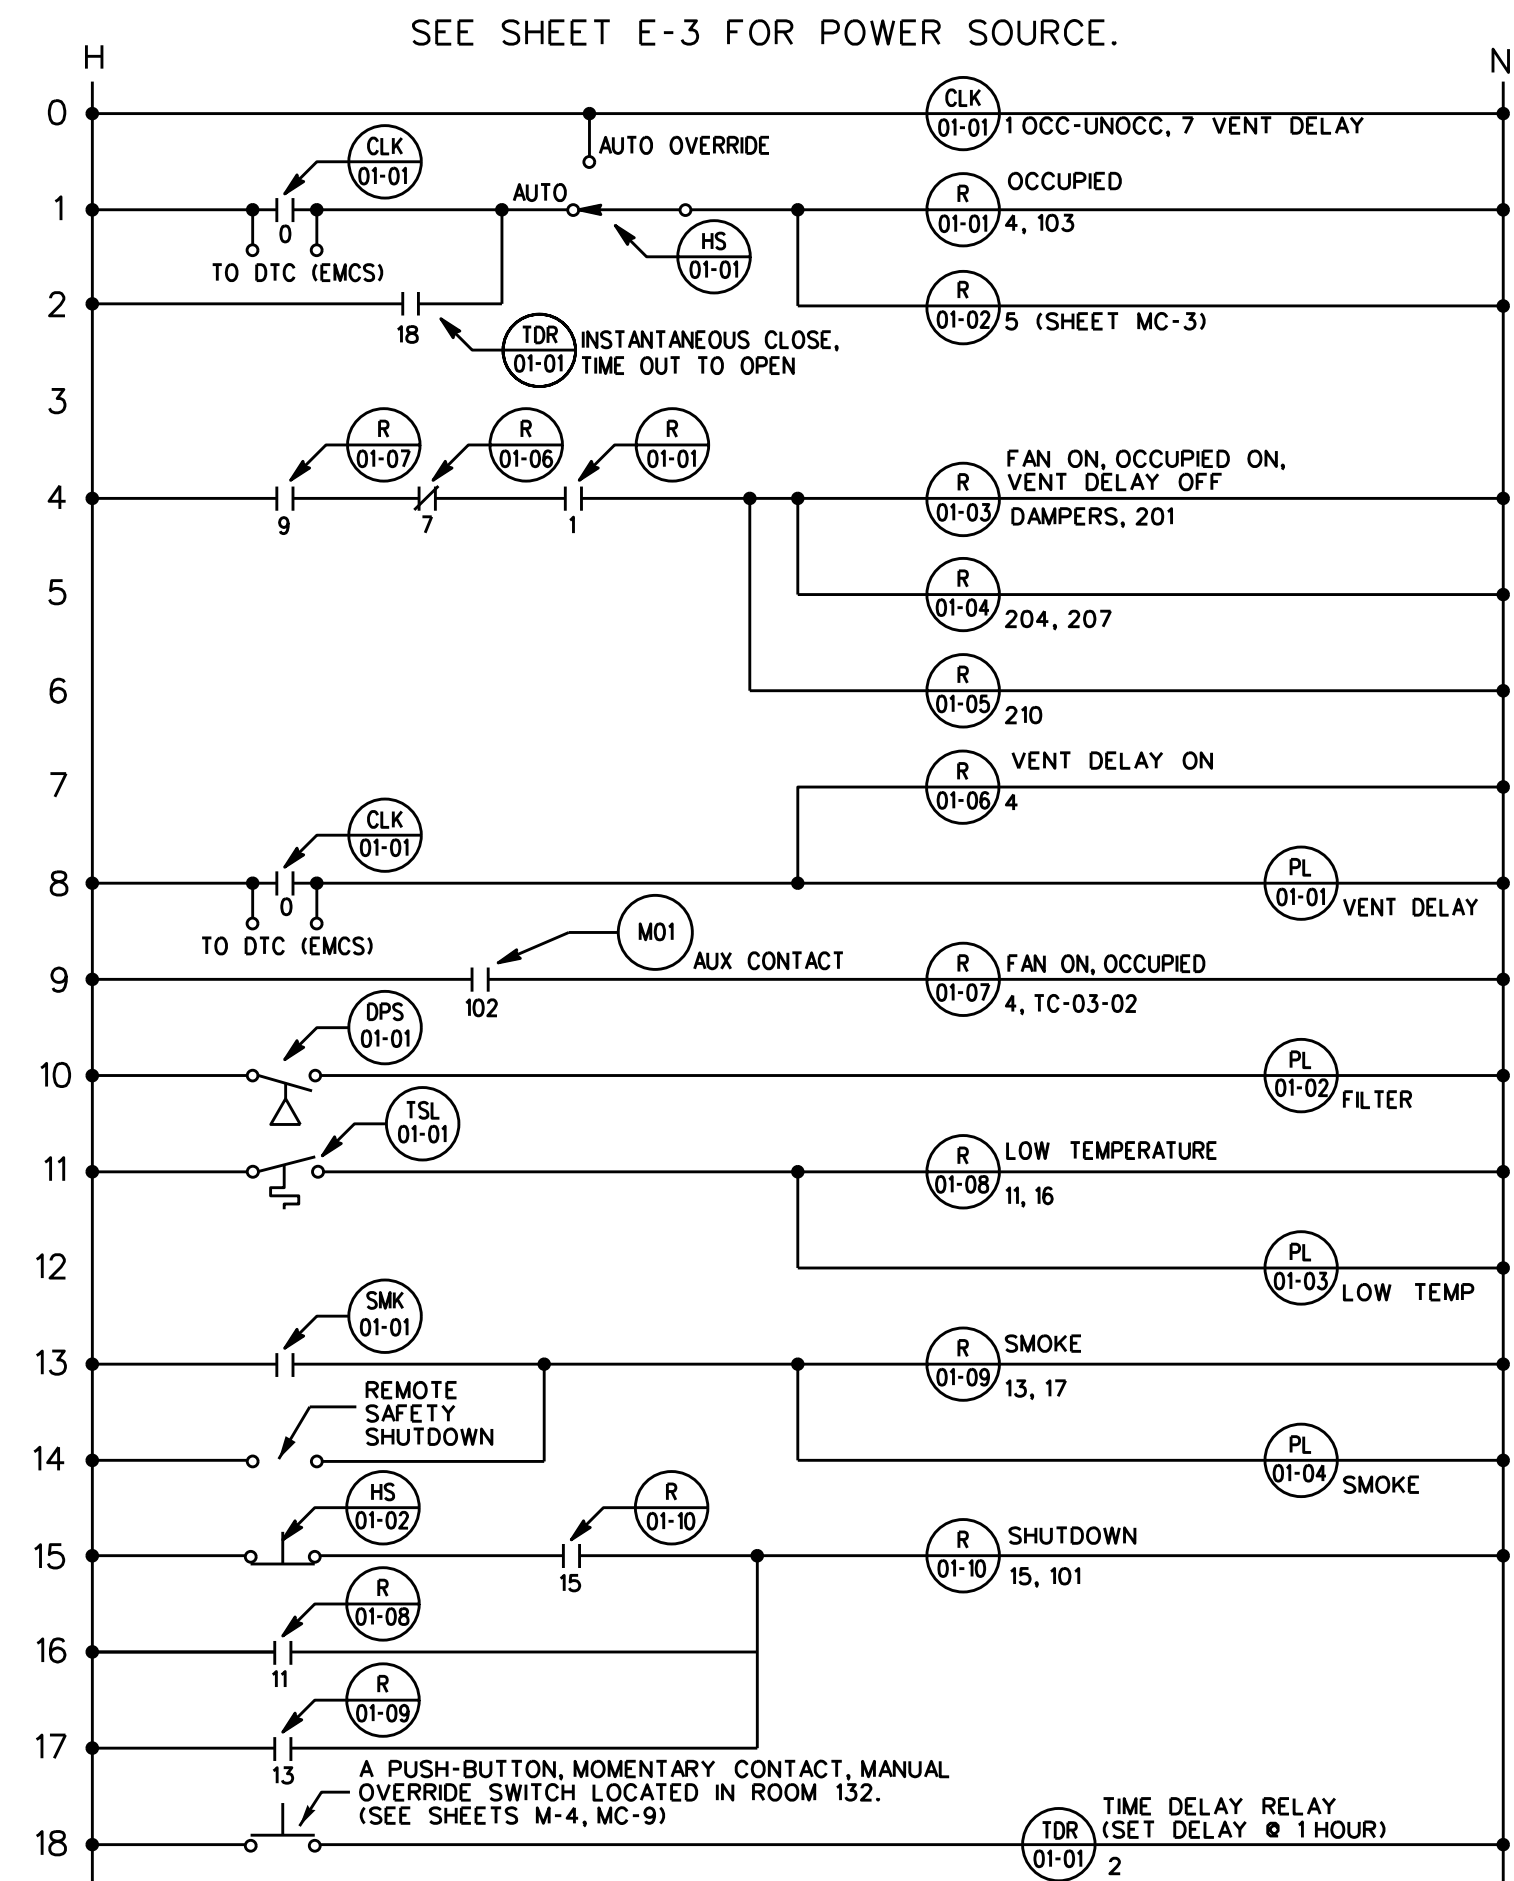

AIR HANDLING UNIT CONTROL PANEL

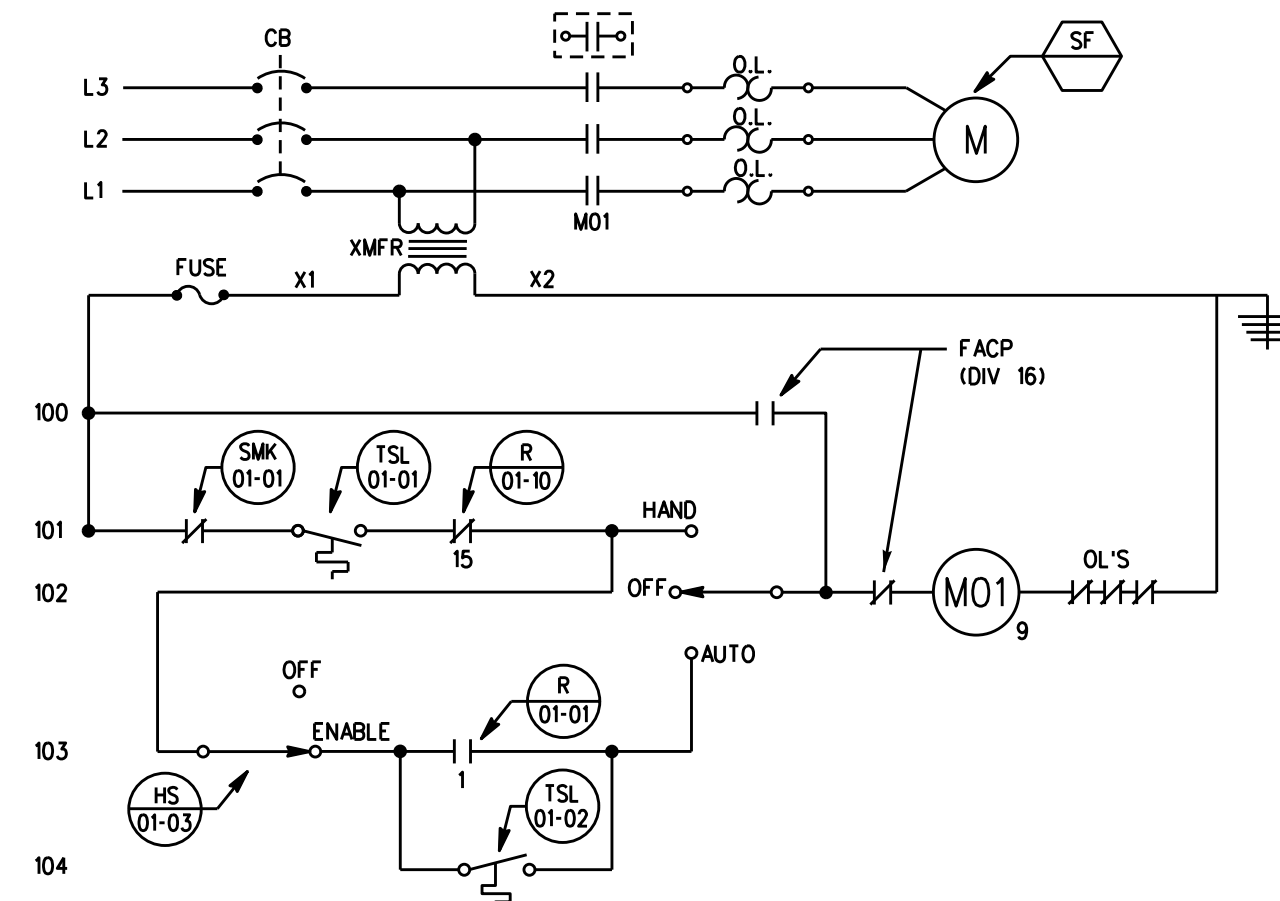

SUPPLY FAN STARTER

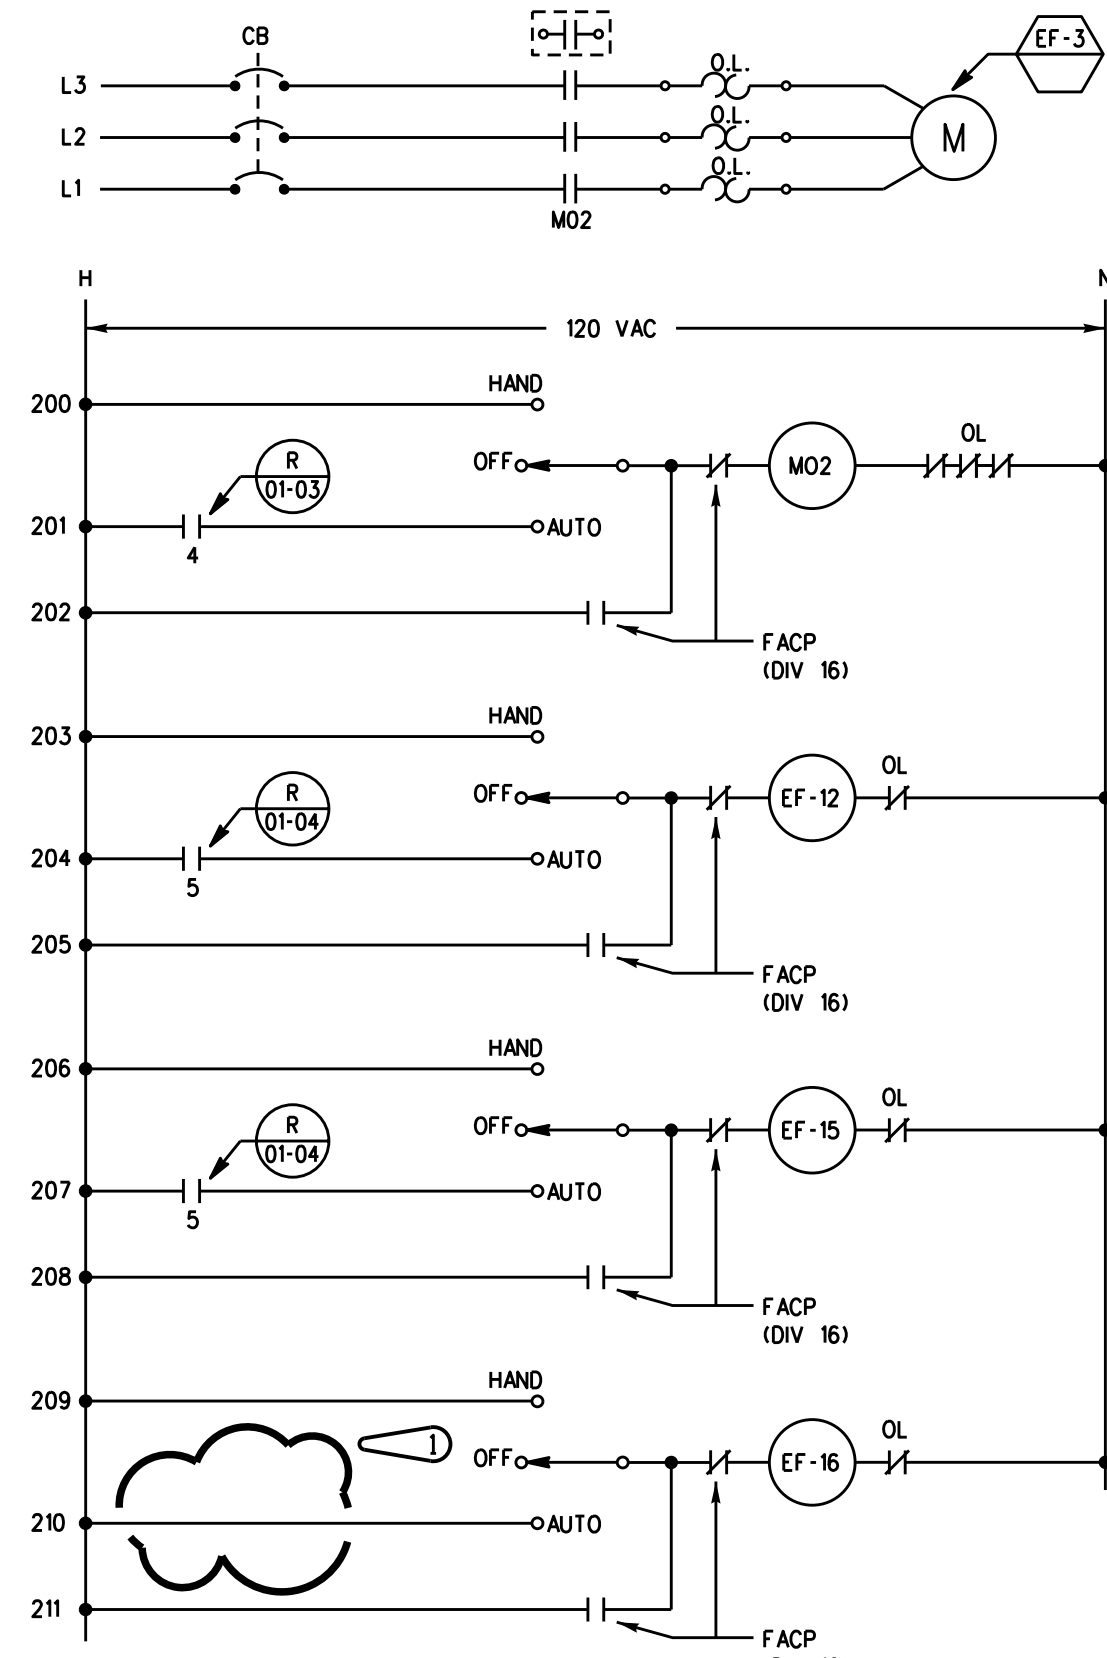

EXHAUST FAN STARTERS

US ARMY CORPS OF ENGINEERS SAVANNAH DISTRICT

REV. DATE: 14 JUL 97
CATEGORY CODE 721-11-11
SOLICITATION NO: DAC21-97-B-005
PLOT DATE: \$DATE\$
PLOT SCALE: 1

U.S. ARMY ENGINEER DISTRICT CORPS OF ENGINEERS SAVANNAH, GEORGIA


30 SEP 04 DGC
17 AUG 98 SWM
DATE BY
DESCRIPTION

RANGER BARRACKS COMPLEX
FORT BENNING, GEORGIA
DINING FACILITY
HVAC CONTROLS AHU-1

PLATE REFERENCE NUMBER:
MC-2
SHEET 337

CONTRACT NO: DAC21-98-C-0022

CONSECUTIVE SHEET NUMBER 333345 TIME 03:54

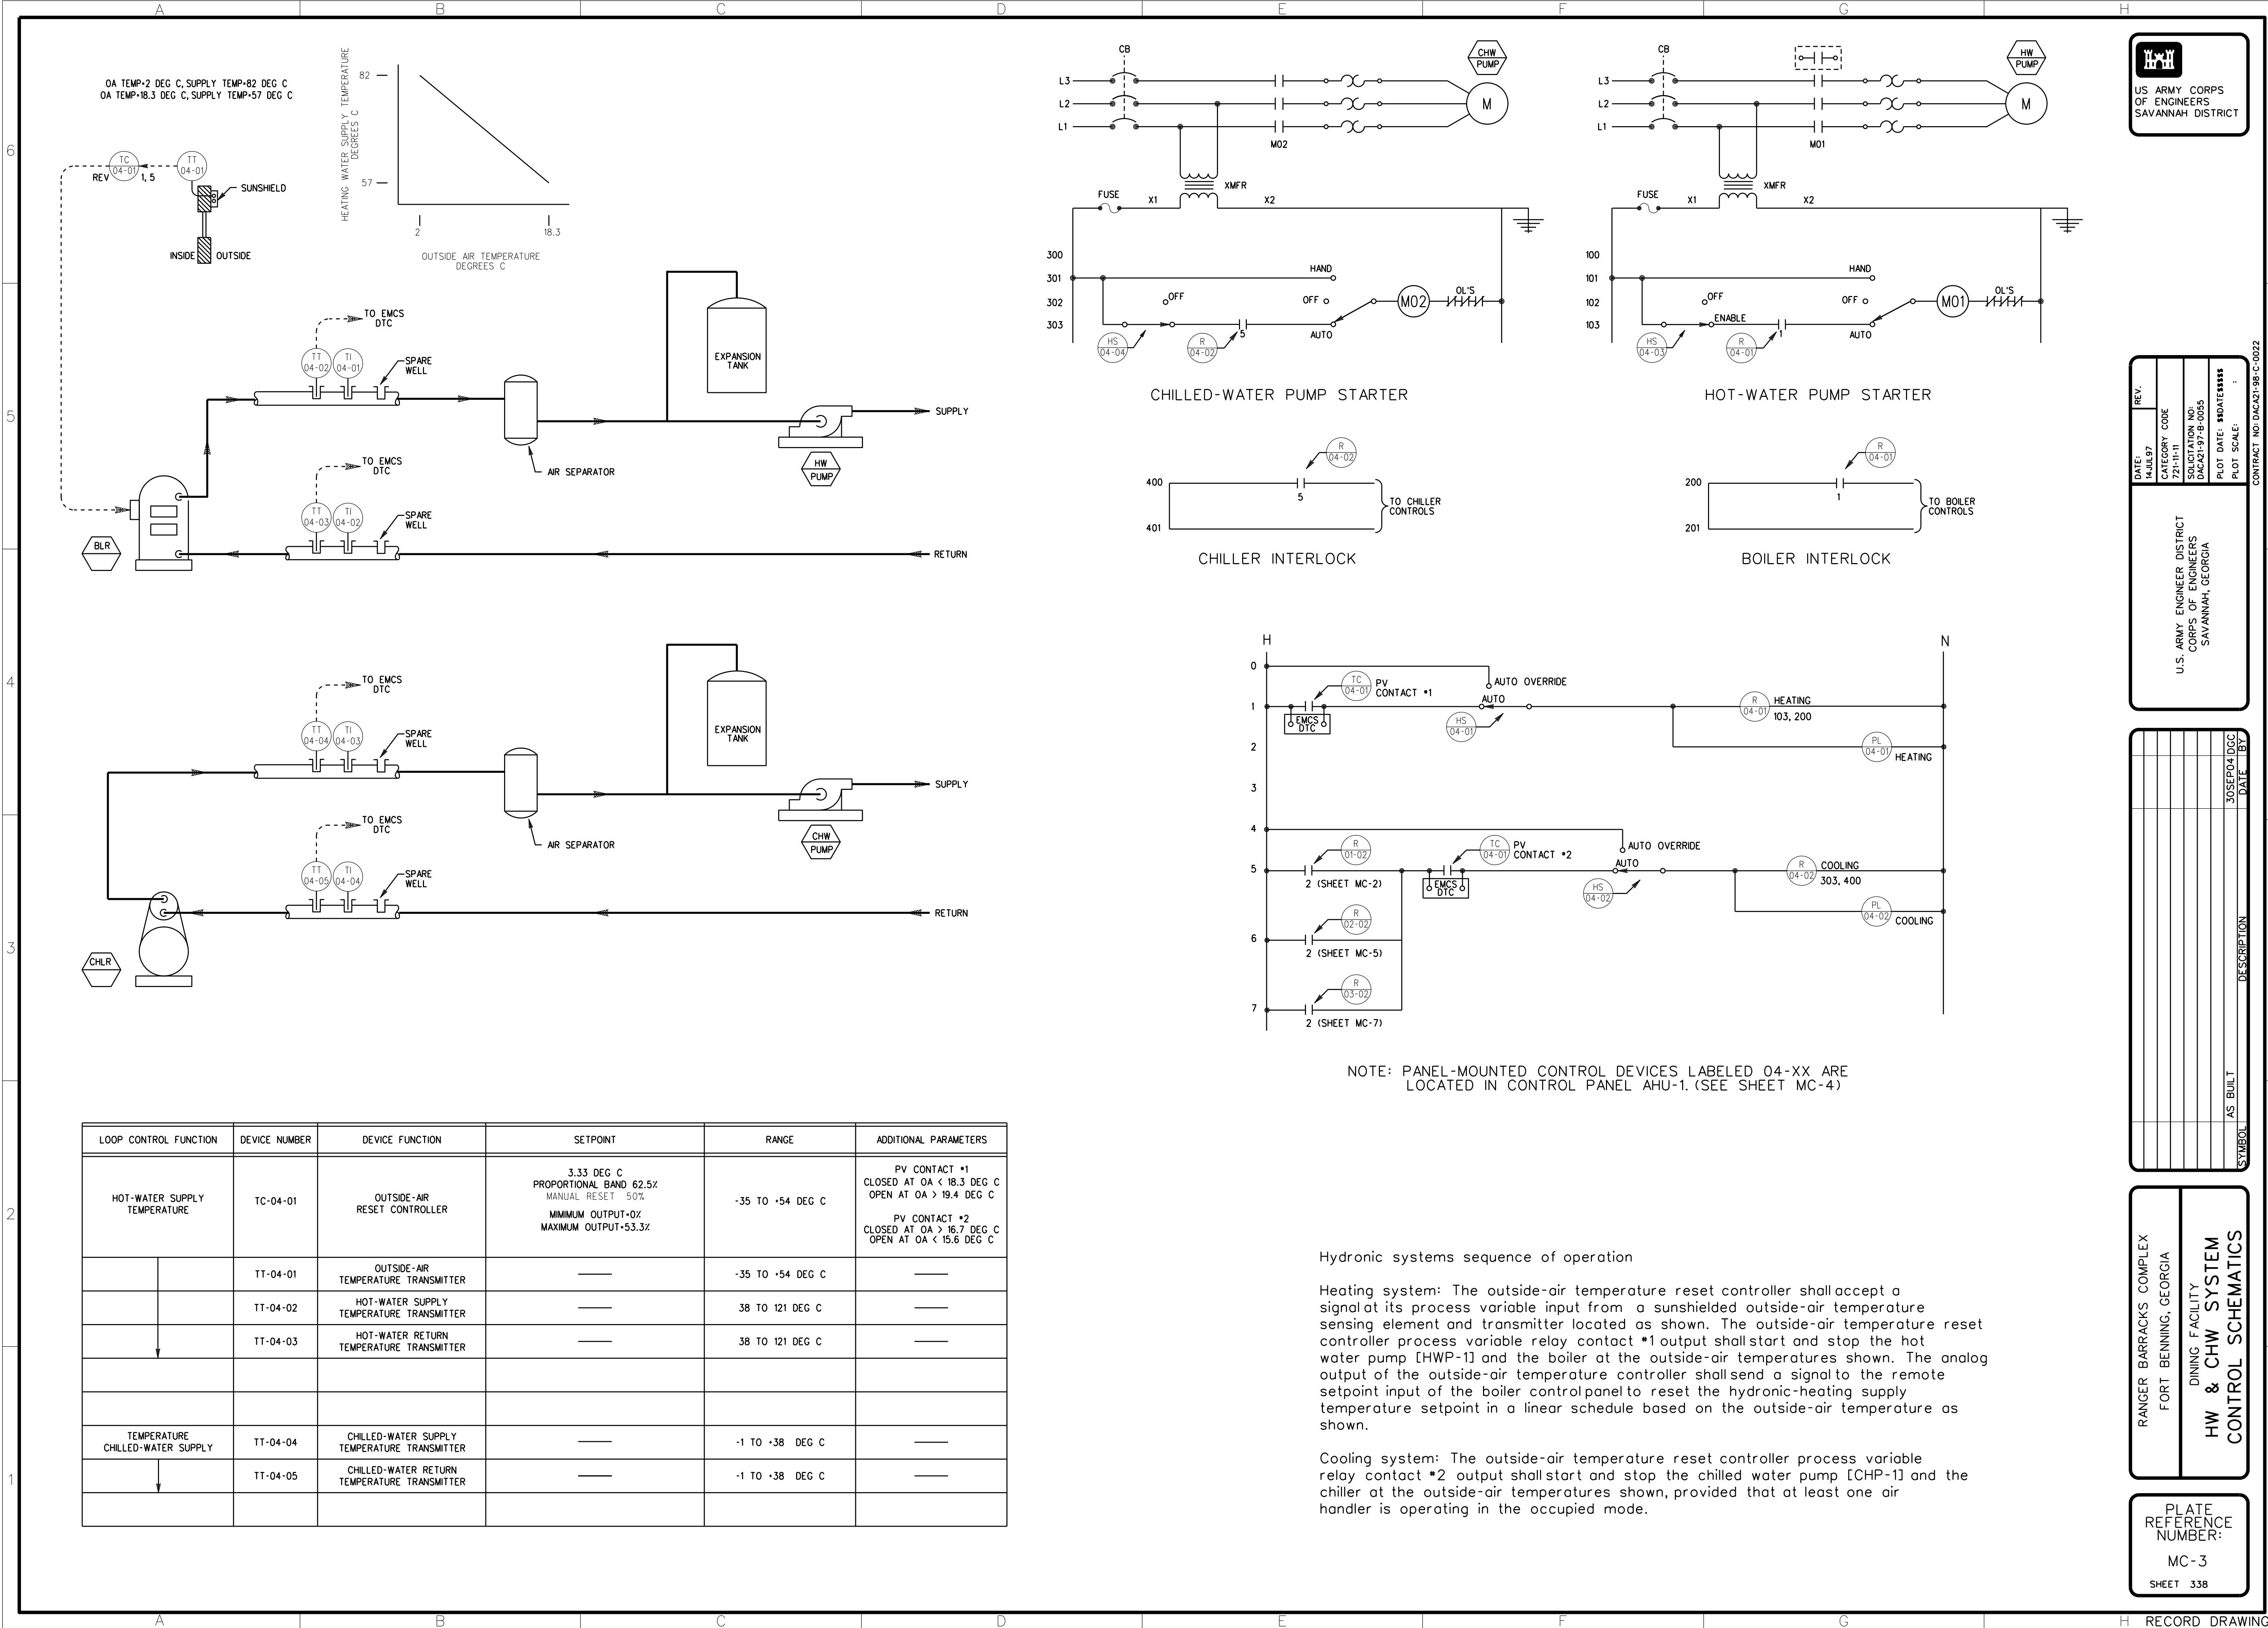

Hydronic systems sequence of operation

Heating system: The outside-air temperature reset controller shall accept a signal at its process variable input from a sunshielded outside-air temperature sensing element and transmitter located as shown. The outside-air temperature reset controller process variable relay contact *1 output shall start and stop the hot water pump [HWP-1] and the boiler at the outside-air temperatures shown. The analog output of the outside-air temperature controller shall send a signal to the remote setpoint input of the boiler control panel to reset the hydronic-heating supply temperature setpoint in a linear schedule based on the outside-air temperature as shown.

Cooling system: The outside-air temperature reset controller process variable relay contact *2 output shall start and stop the chilled water pump [CHP-1] and the chiller at the outside-air temperatures shown, provided that at least one air handler is operating in the occupied mode.

US ARMY CORPS OF ENGINEERS SAVANNAH DISTRICT

DATE: 14 JUL 97	REV.
CATEGORY CODE 721-11-11	
SOLICITATION NO: DAC21-97-B-005	
PLOT DATE: \$DATE\$	
PLOT SCALE: 1	

CONTRACT NO DAC21-98-C-0022

U.S. ARMY ENGINEER DISTRICT
CORPS OF ENGINEERS
SAVANNAH, GEORGIA


SYMBOL	AS BUILT	DATE	BY
		30 SEP 04	DGC

RANGER BARRACKS COMPLEX
FORT BENNING, GEORGIA

DINING FACILITY
HW & CHW SYSTEM
CONTROL SCHEMATICS

PLATE REFERENCE NUMBER:
MC-3
SHEET 338

RECORD DRAWING

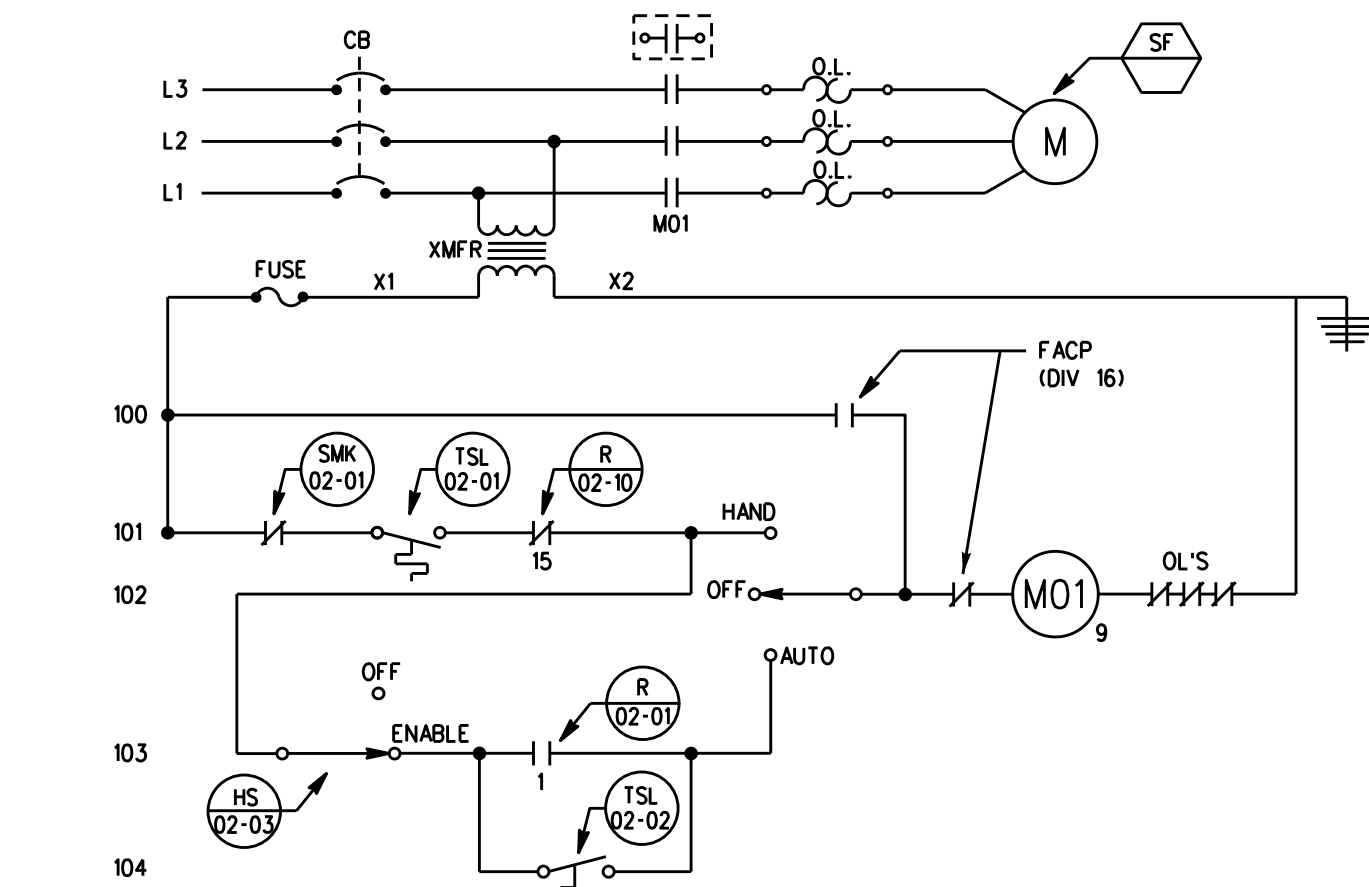

LOOP CONTROL FUNCTION		DEVICE NUMBER	DEVICE FUNCTION	SETPOINT	RANGE	ADDITIONAL PARAMETERS
SPACE TEMPERATURE		DA-02-01 DA-02-02 DA-02-03	DAMPER ACTUATOR	—	4 - 20 mA	—
		MPS-02-01	DAMPER MINIMUM POSITION	SET OUTPUT TO PROVIDE 300 L/s OUTSIDE AIR	—	—
		MPS-02-02	DAMPER MAXIMUM POSITION	SET OUTPUT TO POSITION DAMPER'S FULL STROKE	—	—
		DPS-02-01	FILTER ALARM	PER FILTER MANUFACTURER'S RECOMMENDATION	PER FILTER MANUFACTURER'S RECOMMENDATION	—
		VLV-02-01	HEATING COIL VALVE	—	4 - 8 mA	Kv • 21 CLOSE AGAINST 20 kPa
		VLV-02-02	COOLING COIL VALVE	—	16 - 20 mA	Kv • 19 CLOSE AGAINST 150 kPa
		TC-02-01	SPACE TEMPERATURE CONTROLLER	24°C	10 TO 30 °C	—
		TT-02-01	SPACE TEMPERATURE TRANSMITTER	—	10 TO 30 °C	—
MIXED AIR TEMPERATURE		TSL-02-01	LOW TEMPERATURE PROTECTION THERMOSTAT	4°C	2.8°C DIFFERENTIAL	—
SPACE LOW TEMPERATURE		TSL-02-02	NIGHT STAT - SPACE LOW TEMPERATURE PROTECTION	13°C	2.8°C DIFFERENTIAL	—
OCCUPIED MODE		CLK-02-01 CONTACT	365 DAY SCHEDULE	—	WEEKDAY SCHEDULE CLOSED: 0600 HRS OPEN: 2000 HRS	SAT, SUN, HOLIDAY SCHEDULE
VENTILATION DELAY MODE		CLK-02-01 CONTACT	365 DAY SCHEDULE	—	WEEKDAY SCHEDULE CLOSED: 0600 HRS OPEN: 0700 HRS	


A	B	C	D	E	F	G	H	RECORD	DRAWING
---	---	---	---	---	---	---	---	--------	---------




Occupied, Unoccupied and Ventilation-Delay Modes:
Ventilation-delay mode timing shall start prior to the occupied-mode timing. The time clock shall close a contact, which shall turn on the ventilation-delay pilot light and energize a relay which shall prevent the outside air damper from opening. At the time shown, the clock shall close another contact which shall turn on the occupied mode pilot light and shall place the control system in the occupied mode of operation. At the expiration of the ventilation-delay mode timing period, the time clock shall open the contact to turn off the ventilation-delay mode pilot light and de-energize a relay to allow the outside air damper to open. At the time shown, the time clock shall open the contact to turn off the occupied mode pilot light and shall place the control system in the unoccupied mode of operation. Activation of a time-delay relay, thru a space mounted manual switch, shall place the system in the occupied mode for a period of one hour.

Supply fan control:
Occupied and ventilation-delay modes: Supply fan shall start and shall run continuously.
Unoccupied mode: The supply fan shall cycle from a night-thermostat. The fans shall start at and stop at the setpoints as shown.

Emergency Fan Shutdown:
Activation of a duct smoke detector in the supply-air ductwork, or activation of a manual emergency fan shutdown switch shall cause the associated fan to shutdown in accordance with NFPA 90A. Activation of these devices shall operate a pilot light on the HVAC control panel. The panel shall require manual resetting after the detector and the manual switch are reset.

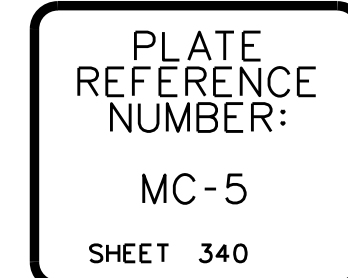


DO NOT SCALE DRAWING
DATE: 14 JUL 97
BY: JMS

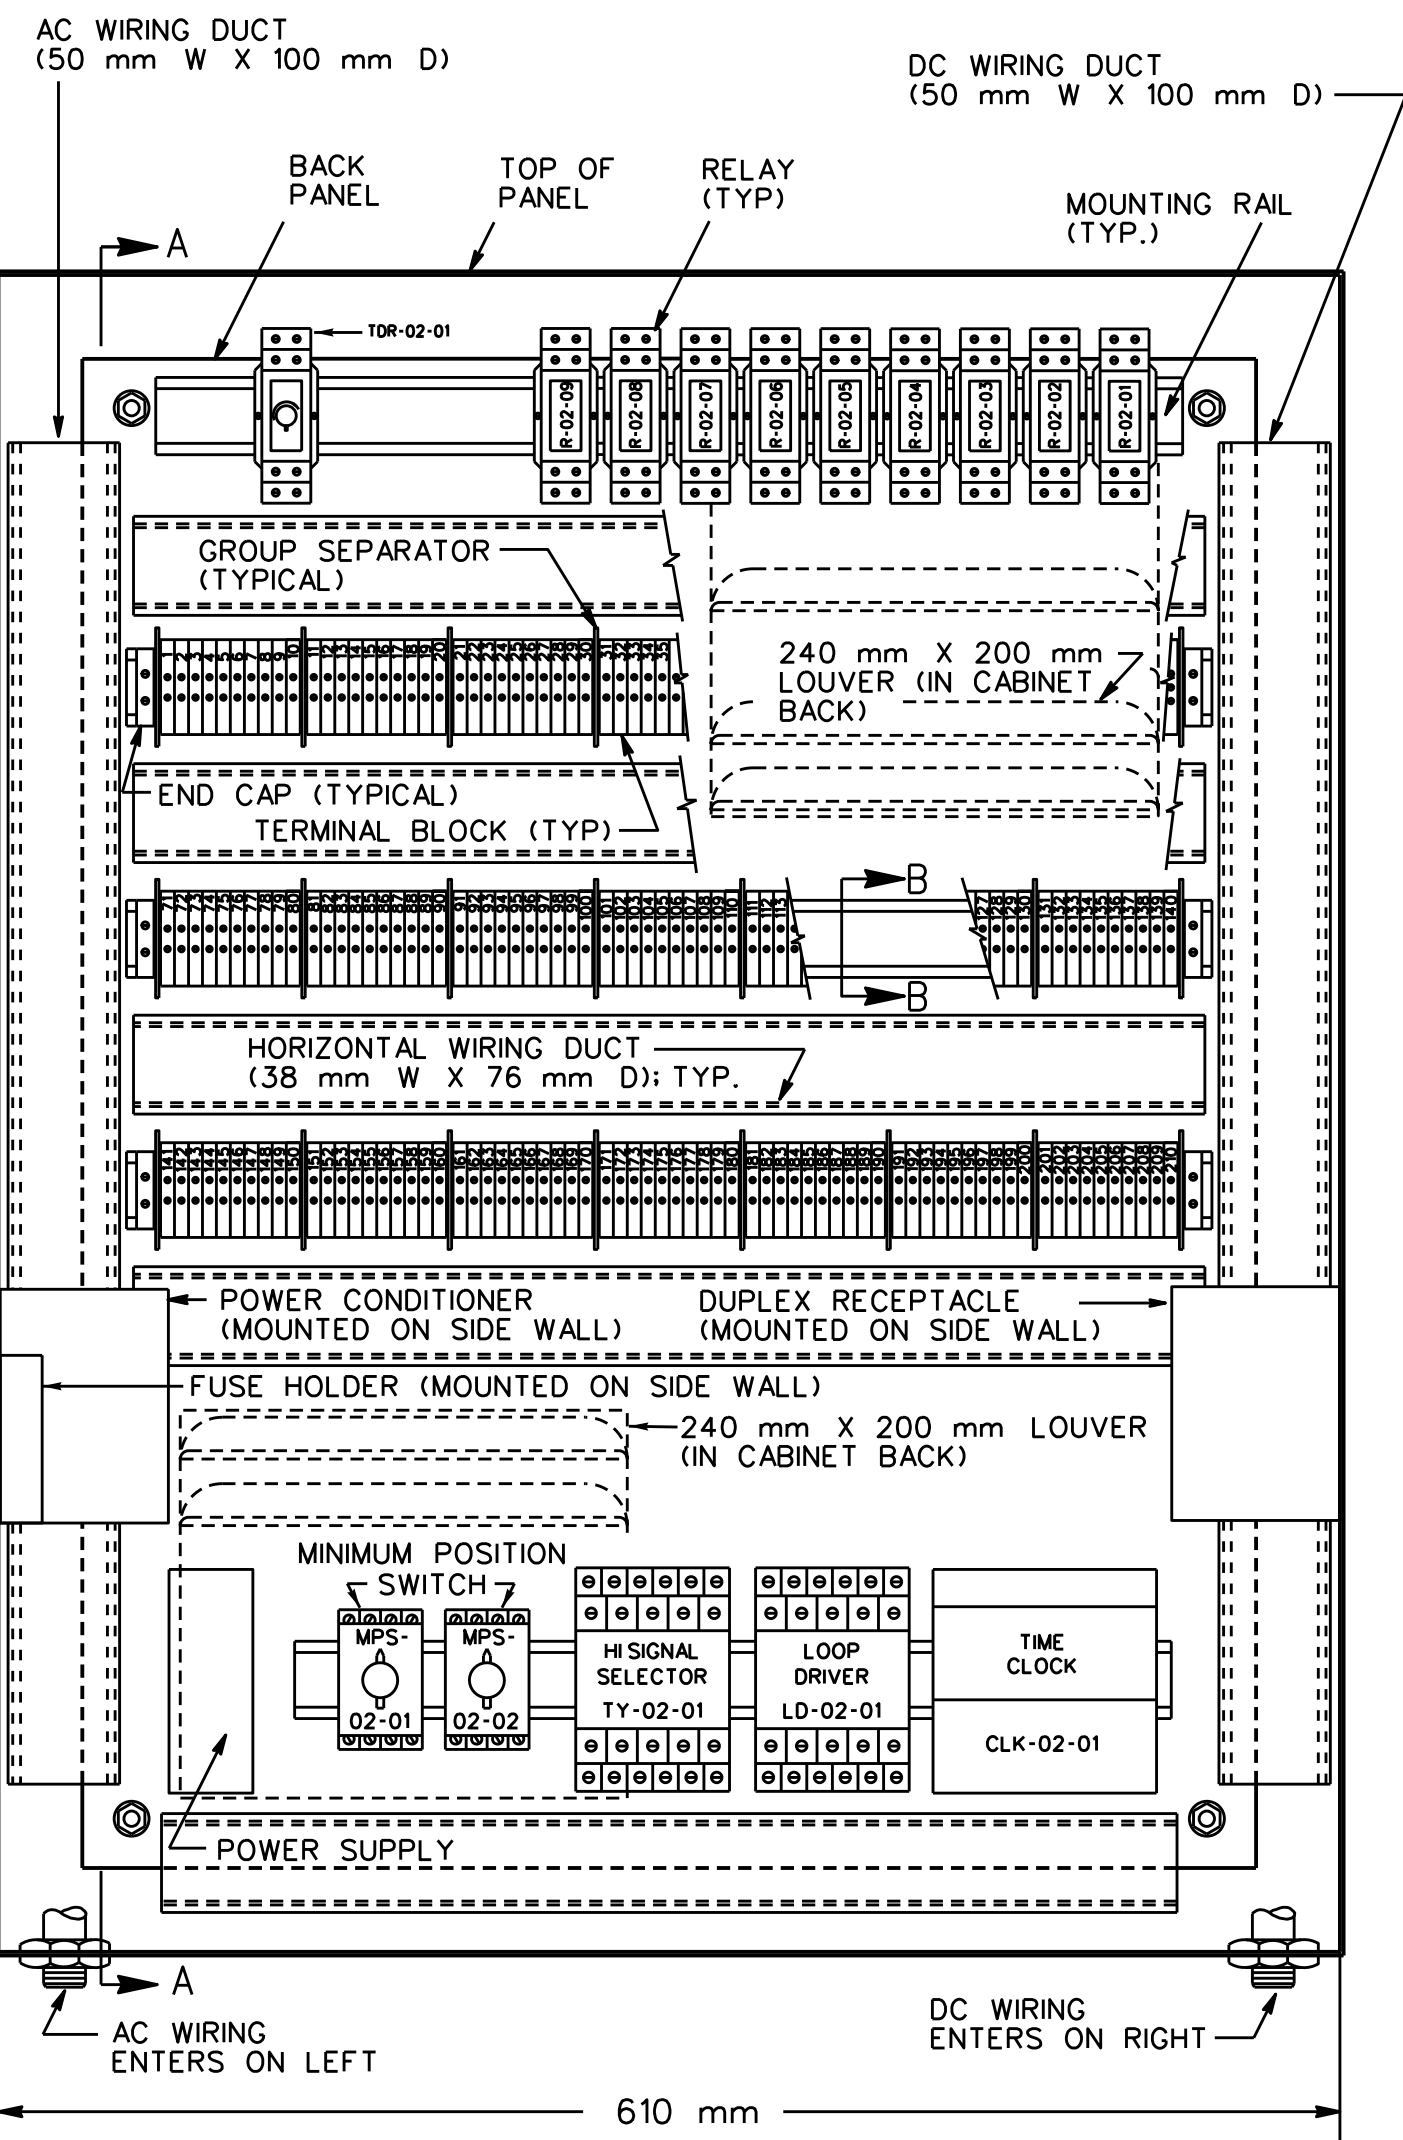


BACK PANEL LAYOUT FOR SYSTEM CONTROL PANEL

NOTES:


- CONTROL PANEL SHALL BE CAPABLE OF ACCEPTING A CONTROLLER WHICH PROTRUDES 260 mm FROM THE REAR OF THE INNER DOOR AND 41 mm FROM THE FRONT OF THE INNER DOOR.
- SEE SHEET E-3 FOR AC POWER SOURCE.

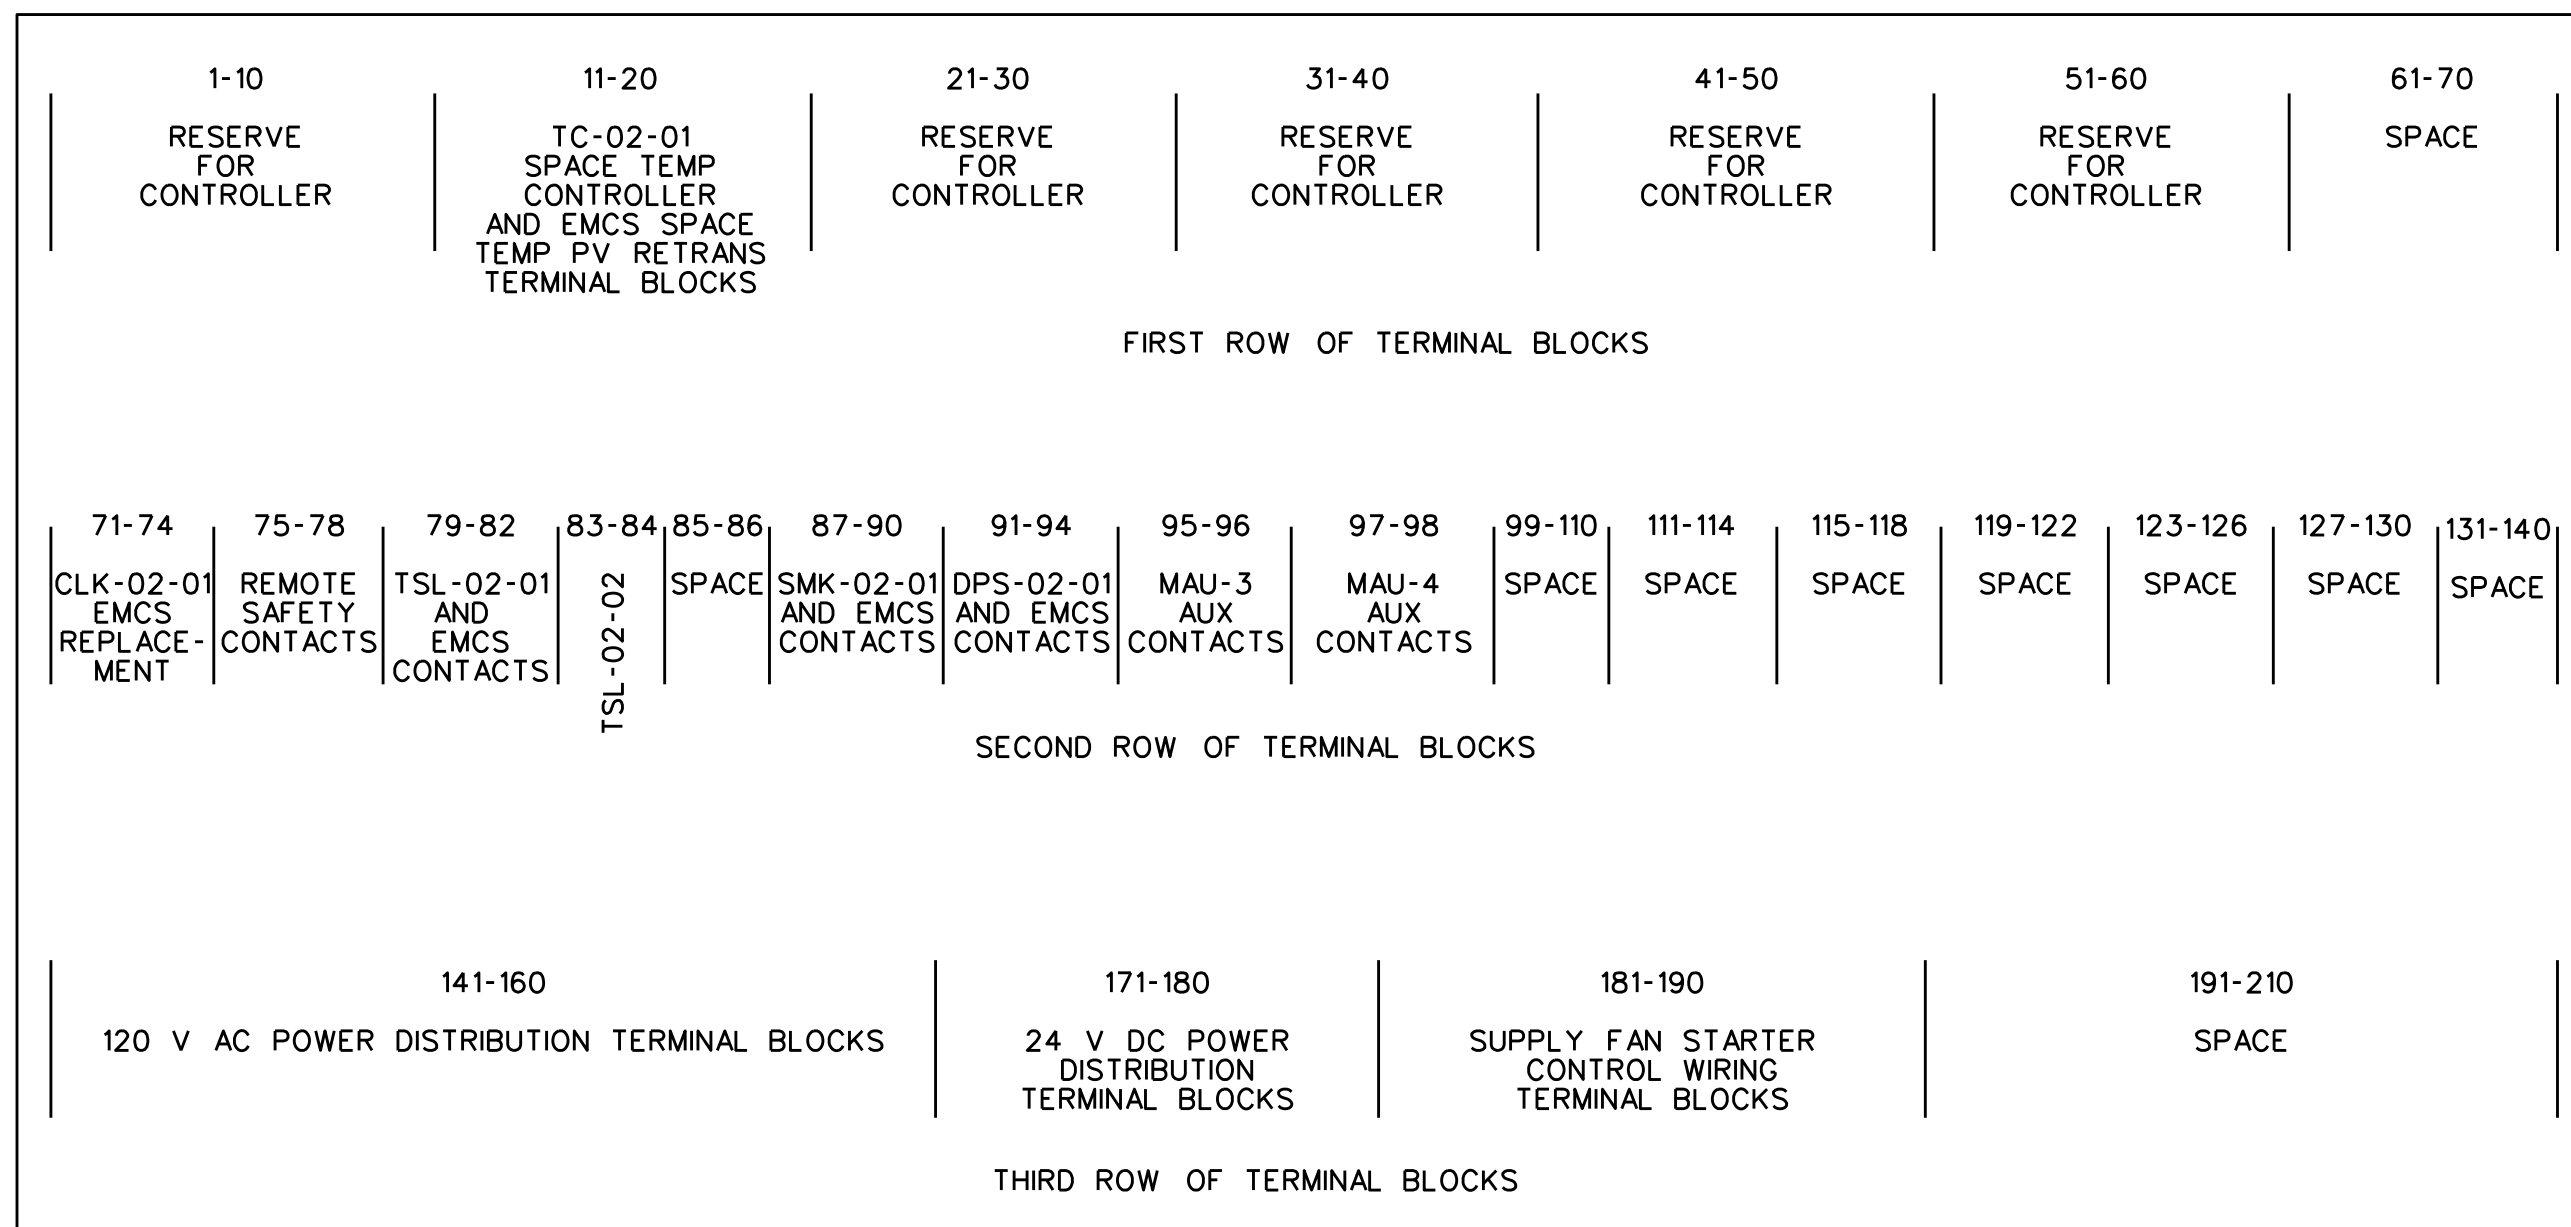

CONTROL PANEL TERMINAL BLOCK LAYOUT

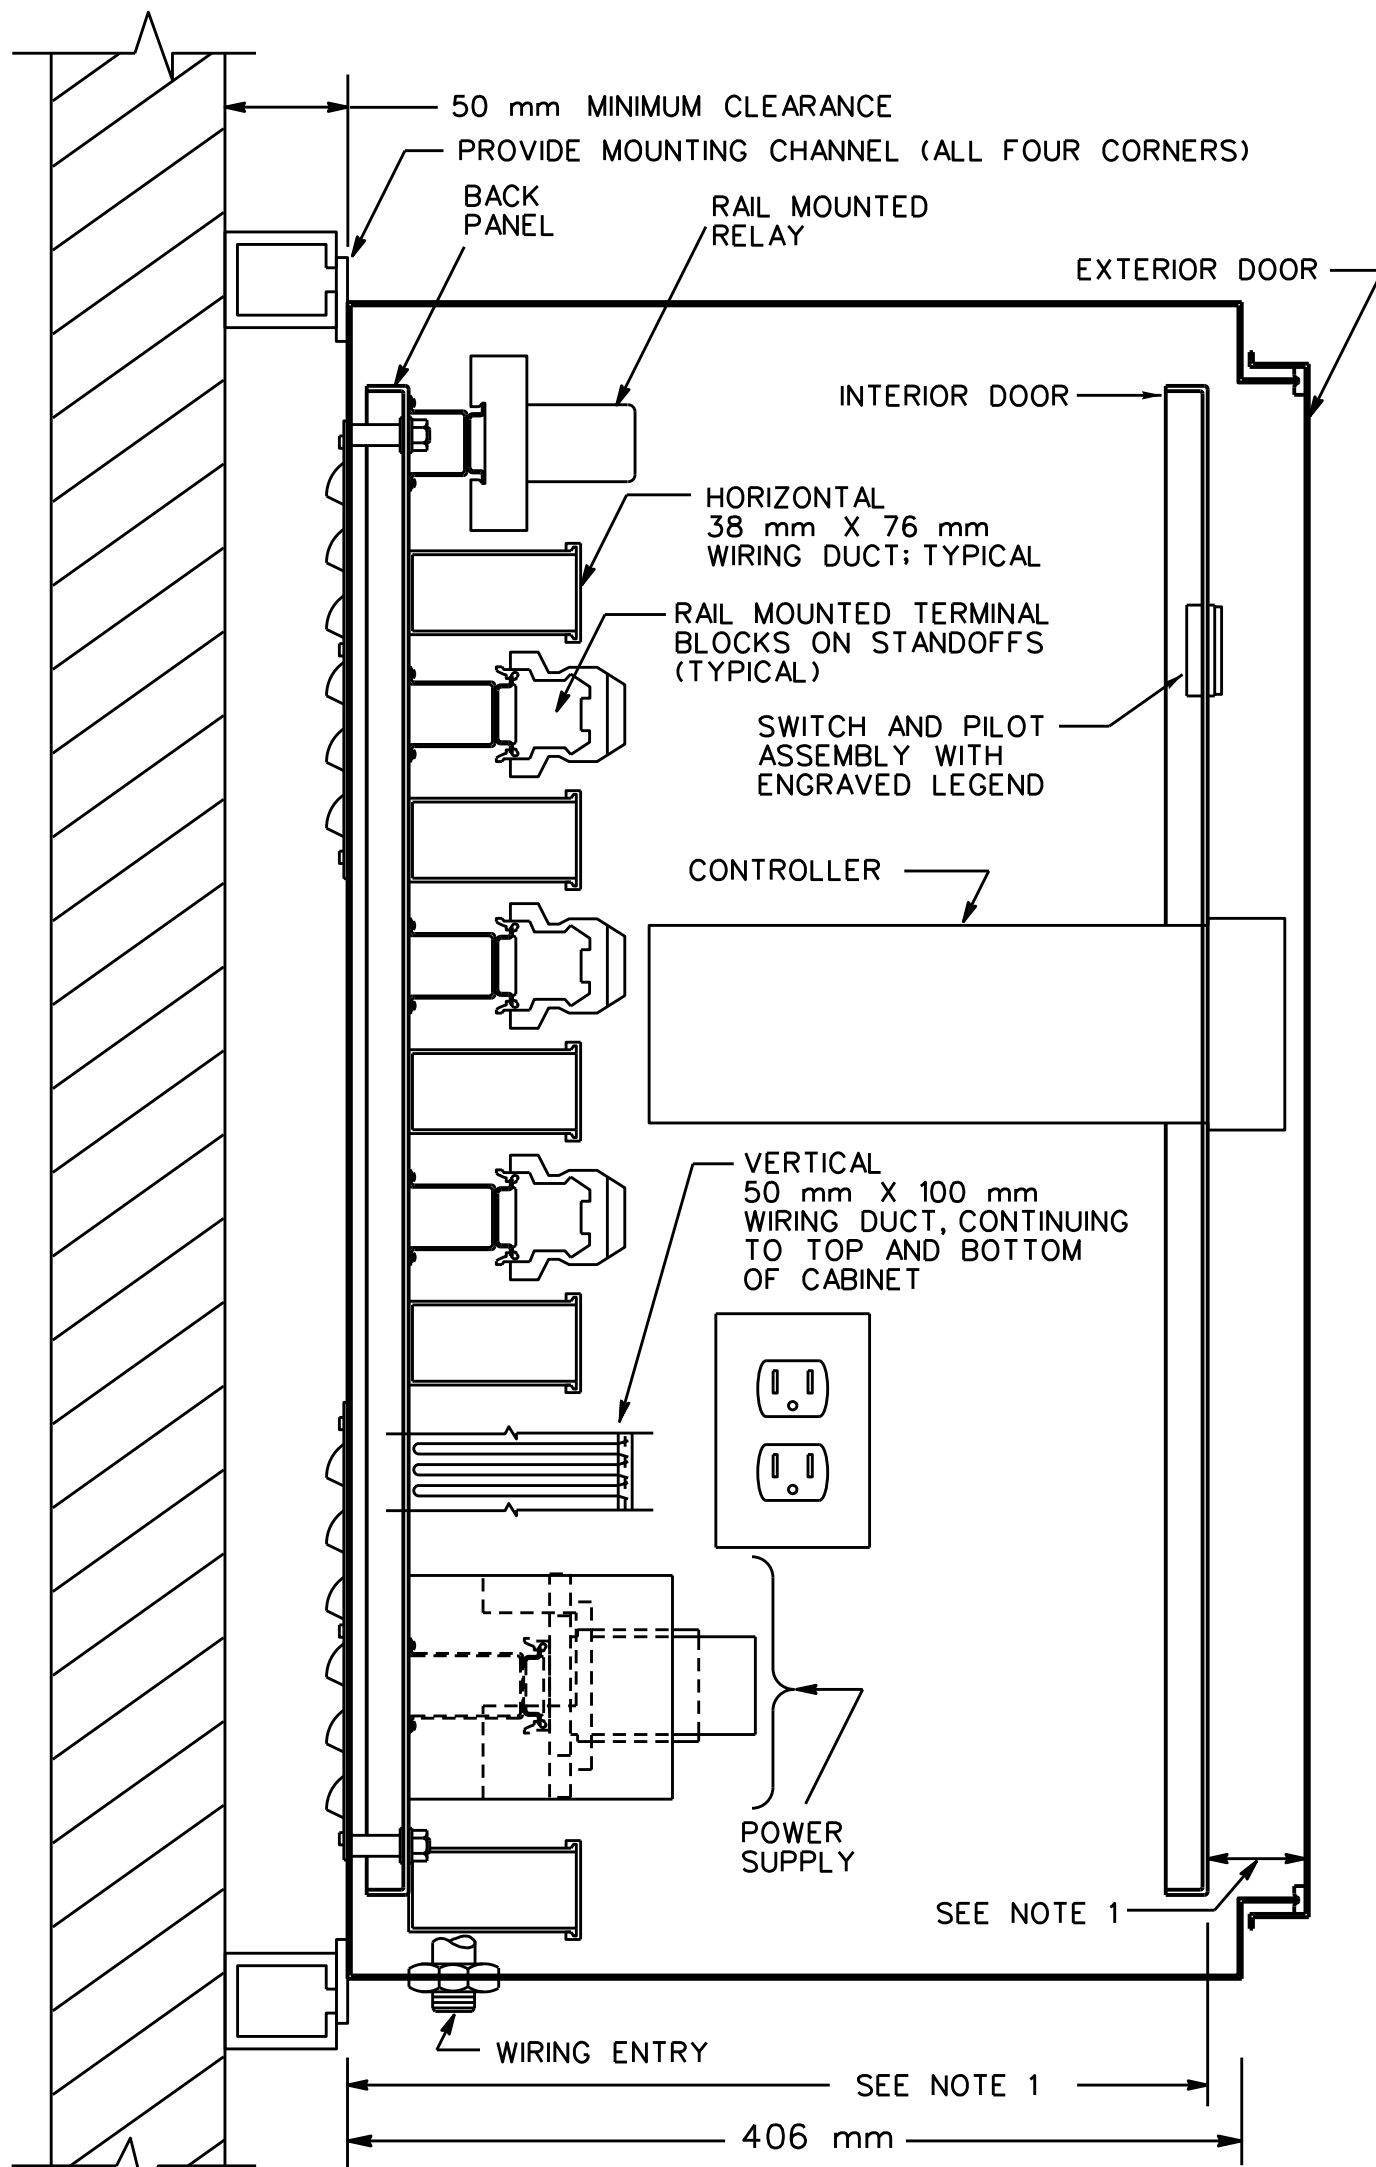

SECTION A-A

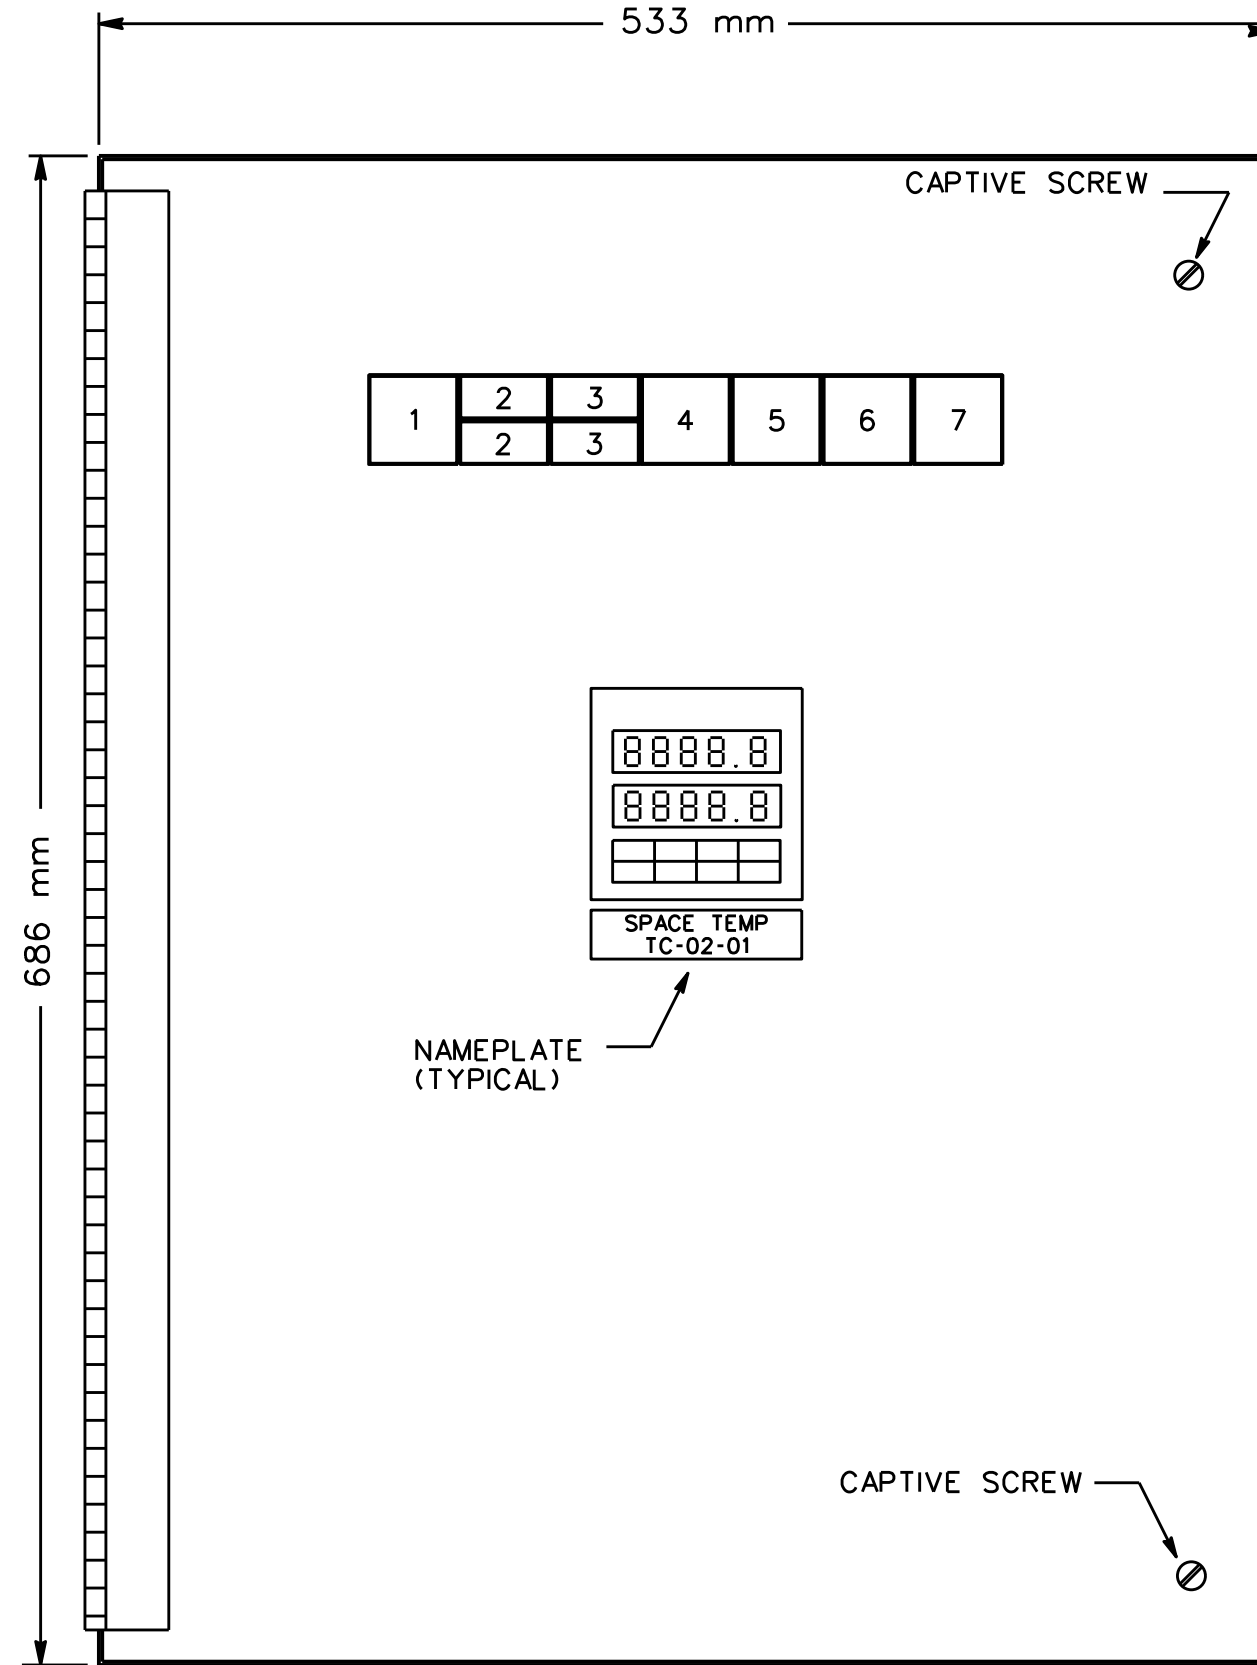


INTERIOR DOOR LAYOUT FOR SYSTEM CONTROL PANEL


SWITCH AND PILOT LIGHT LEGEND

POSITION LEGEND DEVICE TYPE IDENTIFIER


- | | | |
|------------------------|--|----------|
| 1 - RESET | NON-ILLUMINATED MOMENTARY CONTACT PUSH BUTTON SWITCH | HS-02-02 |
| 2 - AUTO/AUTO OVERRIDE | ILLUMINATED MAINTAINED CONTACT INTERLOCKED SWITCHES | HS-02-01 |
| 3 - SF ENABLE/OFF | ILLUMINATED MAINTAINED CONTACT INTERLOCKED SWITCHES | HS-02-03 |
| 4 - FILTER | PILOT LIGHT | PL-02-02 |
| 5 - VENT DELAY | PILOT LIGHT | PL-02-01 |
| 6 - LOW TEMP | PILOT LIGHT | PL-02-03 |
| 7 - SMOKE | PILOT LIGHT | PL-02-04 |

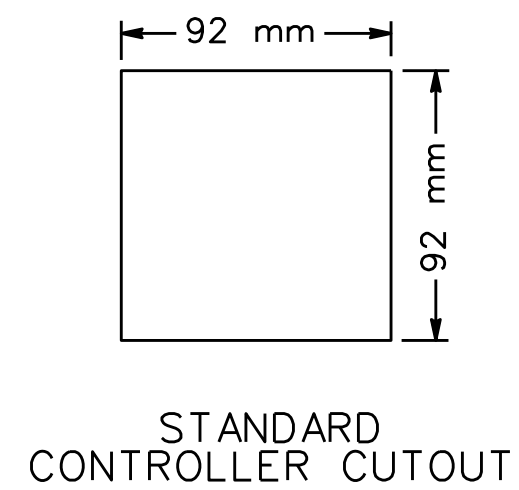

STANDARD CONTROLLER CUTOUT

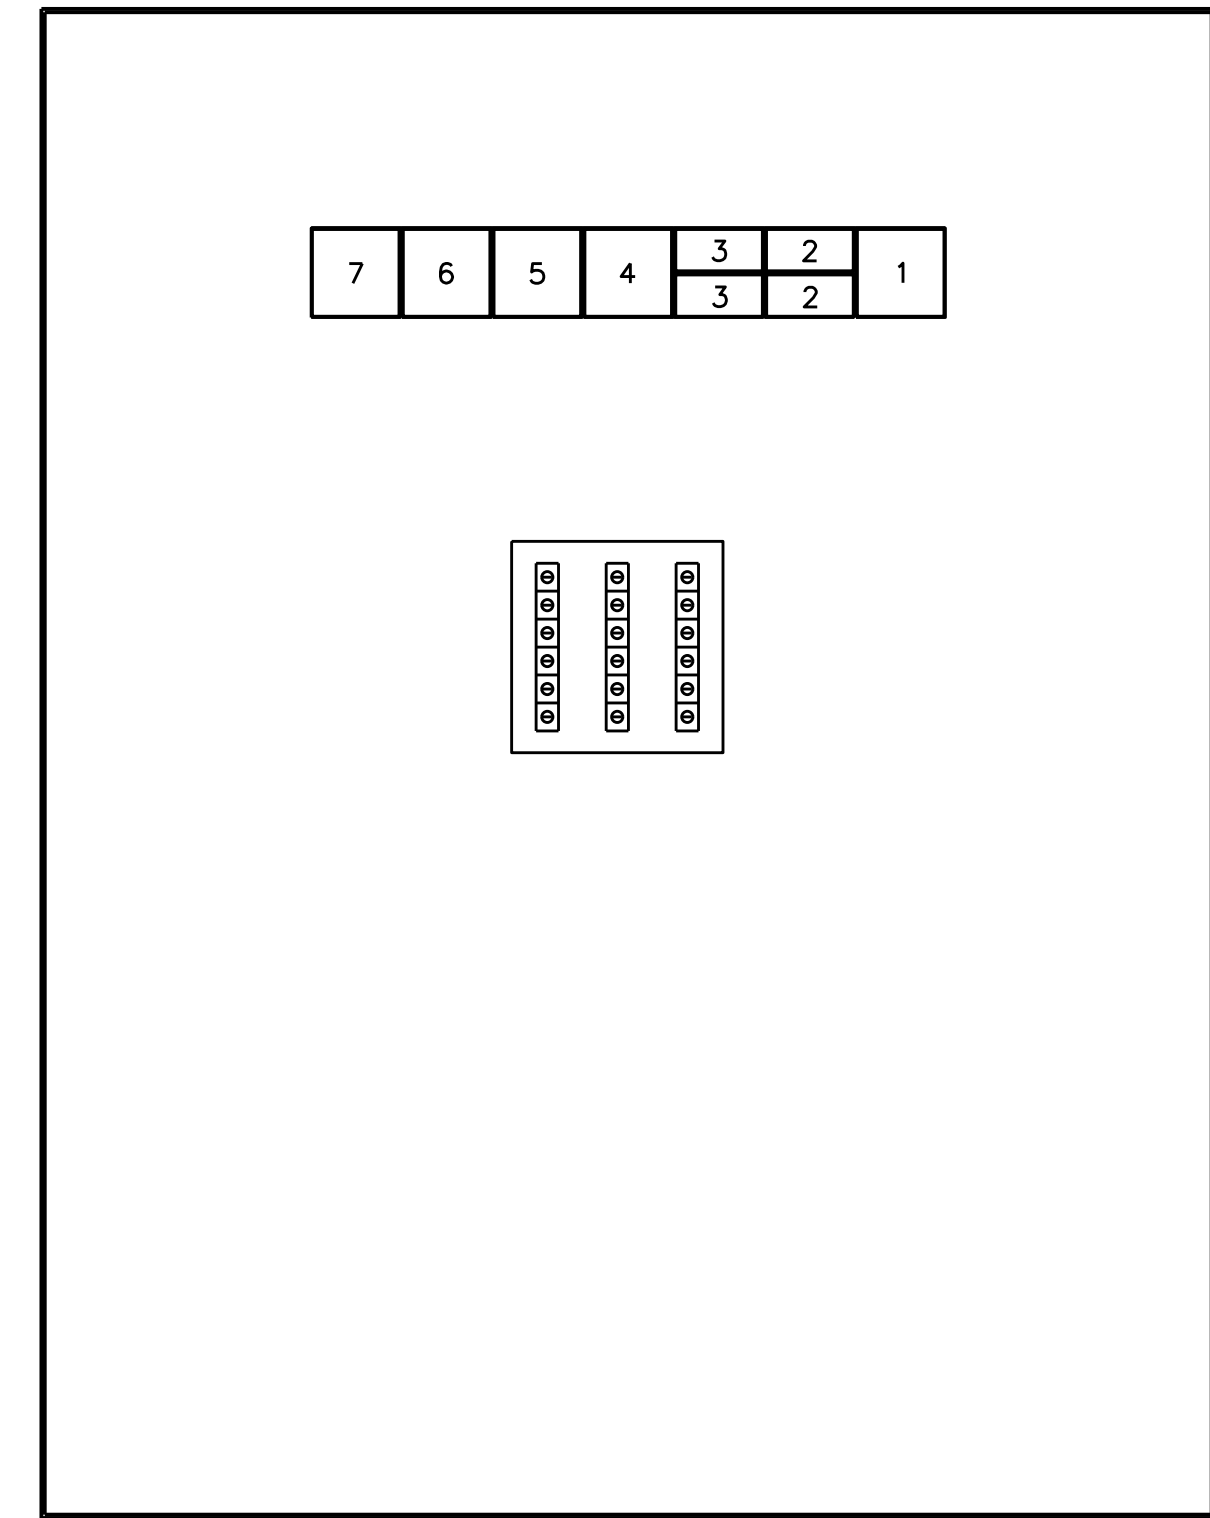

INTERIOR DOOR LAYOUT FOR SYSTEM CONTROL PANEL (REAR VIEW)

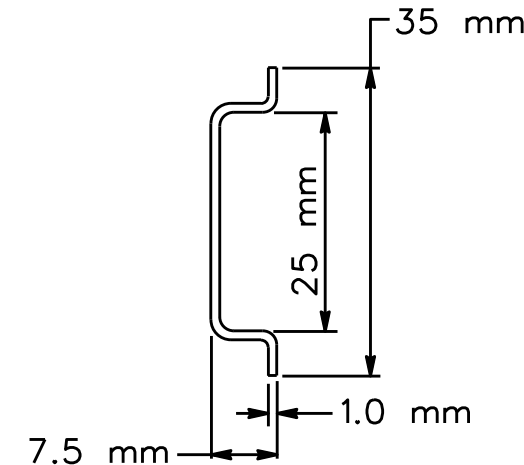

SECTION B-B (TYPICAL FOR ALL MOUNTING RAILS)




DATE: 14 JUL 97	REV.
CATEGORY CODE 721-11-11	
SOLICITATION NO: DAC21-97-B-005	
PLOT DATE: 14 JUL 97	
PLOT SCALE: 1:1	
U.S. ARMY ENGINEER DISTRICT CORPS OF ENGINEERS SAVANNAH, GEORGIA	

SYMBOL	DESCRIPTION	DATE	BY
30SEPO4	DGC		
AS BUILT			

RANGER BARRACKS COMPLEX FORT BENNING, GEORGIA	DINING FACILITY HVAC CONTROLS (AHU-2) CONTROL PANEL DETAILS
--	---

PLATE REFERENCE NUMBER: MC-6 SHEET 341
--

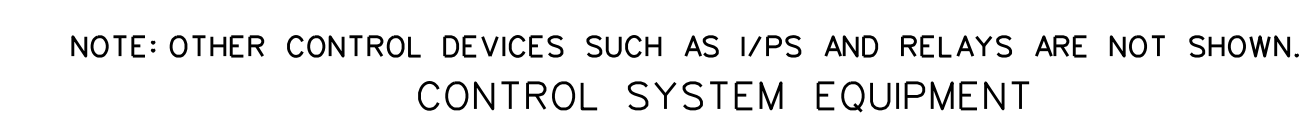

Filter:
A differential-pressure switch across the filter shall turn on the filter pilot light when the pressure drop across the filter reaches the setpoint.

Freeze Protection:
All Modes - A freezestat, located as shown, shall stop the supply fan, cause the outside air, return air, and relief air dampers to return to their normal position as shown, and shall turn on the low-temperature pilot light in the HVAC control panel if the temperature drops below the freeze-stat's setpoint as shown. Return to the normal mode of operation shall require manual reset at the freeze-stat and at the HVAC control panel.

Zone-Damper Control:
All Modes - A space thermostat for each zone shall gradually operate the zone-mixing damper to heat and cool its respective zone by mixing cold-deck air and hot-deck air to maintain the setpoint as shown. On a rise in space temperature, the hot-deck damper shall gradually close, and the cold-deck damper shall gradually open.

Emergency Fan Shutdown:
Activation of a duct smoke detector in the supply-air ductwork, or activation of a manual emergency fan shutdown switch shall cause the associated fan to shutdown in accordance with NFPA 90A. Activation of these devices shall operate a pilot light on the HVAC control panel. The panel shall require manual resetting after the detector and the manual switch are reset.

Exhaust fans EF-11, EF-13 & EF-14:
Exhaust fans EF-11, EF-13 and EF-14 shall be interlocked with ohu MZ-1 such that they are energized whenever MZ-1 is operating in occupied mode and ventilation-delay mode is off.

KEYED NOTES FOR MZ-1 CONTROL:

- ① ONLY ONE SMOKE DETECTOR IS REQUIRED. INSTALL IN THE DUCT TO ZONE 1.
- ② THE NOTATION OF ZX INDICATES A ZONE DEVICE, WHERE X IS THE ZONE NUMBER AS DEFINED BY THE UNIT SCHEDULE ON SHEET M-1.
- ③ THE VALUE SHOWN FOR Kv USES UNITS OF $m^3/hr @ 100 \text{ kPa } \Delta P$.

PLATE
REFERENCE
NUMBER:

MC-7

SHEET 342

Make-up Air Unit Sequence of Operation:

Each make-up air unit is interlocked with one or more exhaust fans. The interlock relationship is as follows:

Make-up Air Unit	Exhaust Fan(s) interlocked
MAU-1	EF-01
MAU-2	EF-02
MAU-3	EF-04, EF-06, EF-08
MAU-4	EF-05, EF-07, EF-09
MAU-5	EF-10

Supply Fan Start:




The exhaust fans are operated by the exhaust hood control panels located in the kitchen, servery, and carry-out areas. A MAU is started when any of its interlocked exhaust fans are energized. Likewise, the MAU does not stop until each of its interlocked exhaust fans is de-energized. When the supply fan is started, the outside air damper shall also open.

Heating function:

The gas-fired heating section shall modulate its output based on the discharge air temperature. This modulation shall be in accordance with the burner manufacturer's recommendation.




Exhaust Fan Sequence of Operation:

Exhaust fans EF-01, EF-02, EF-04, EF-05, EF-06, EF-07, EF-08, EF-09, and EF-10 shall each be connected to an exhaust hood control panel and the fire alarm control panel (FACP). The fans shall be turned on and off from the exhaust hood control panel for normal operation. If the FACP goes into an alarmed condition, each exhaust fan shall come under control of the FACP.

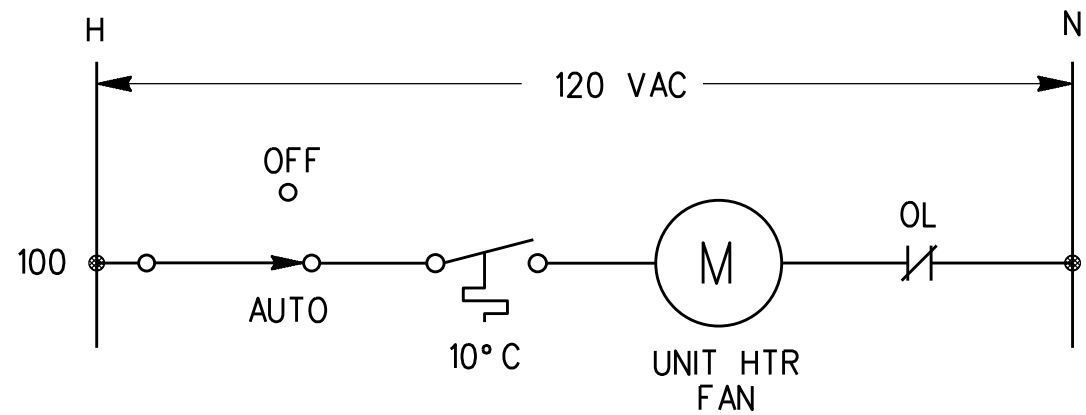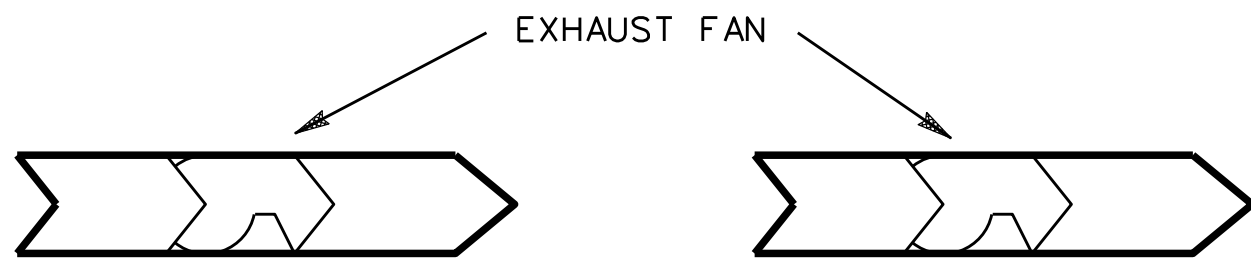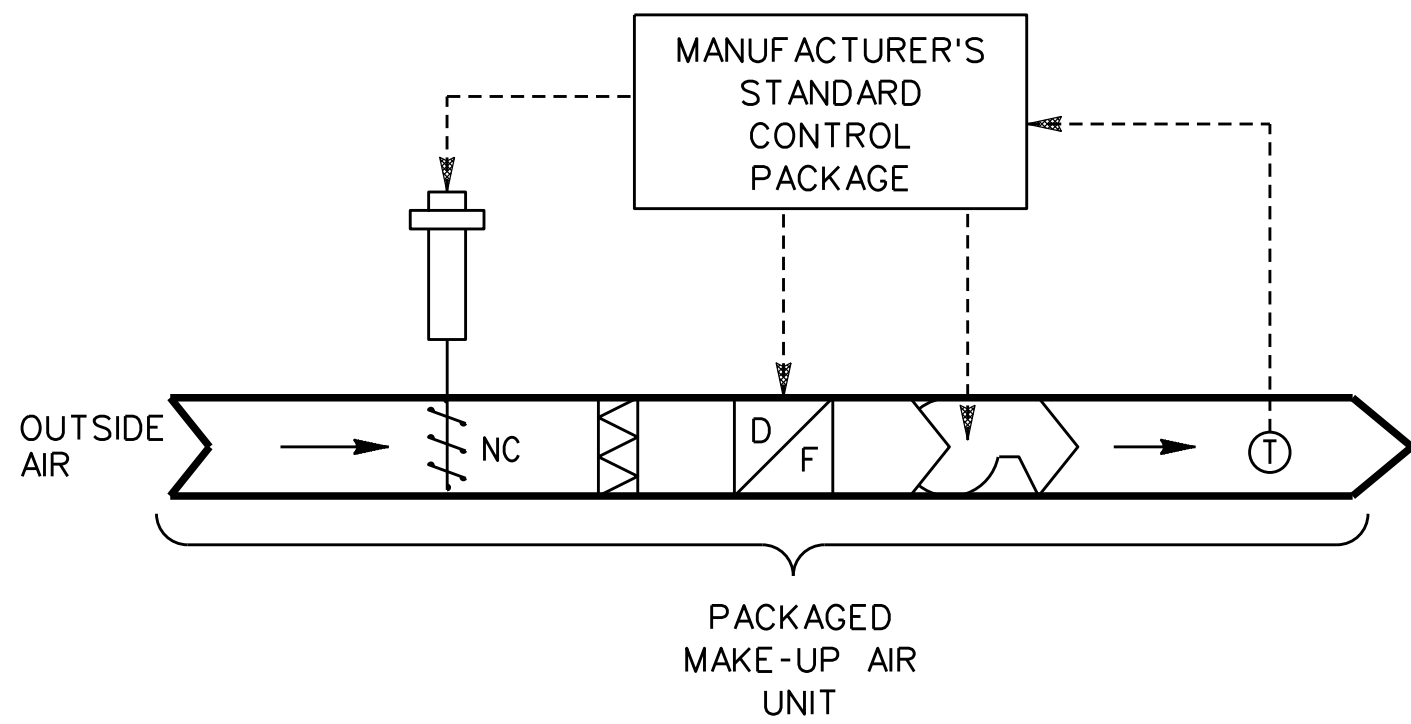

Unit-Heater (UH-1 & UH-2) Sequence of Operation:

A wall-mounted thermostat with an "AUTO-OFF" switch located as shown, shall cycle the fan to maintain its setpoint as shown when the switch is in the "AUTO" position. When the switch is in the "OFF" position, the fan shall be stopped.

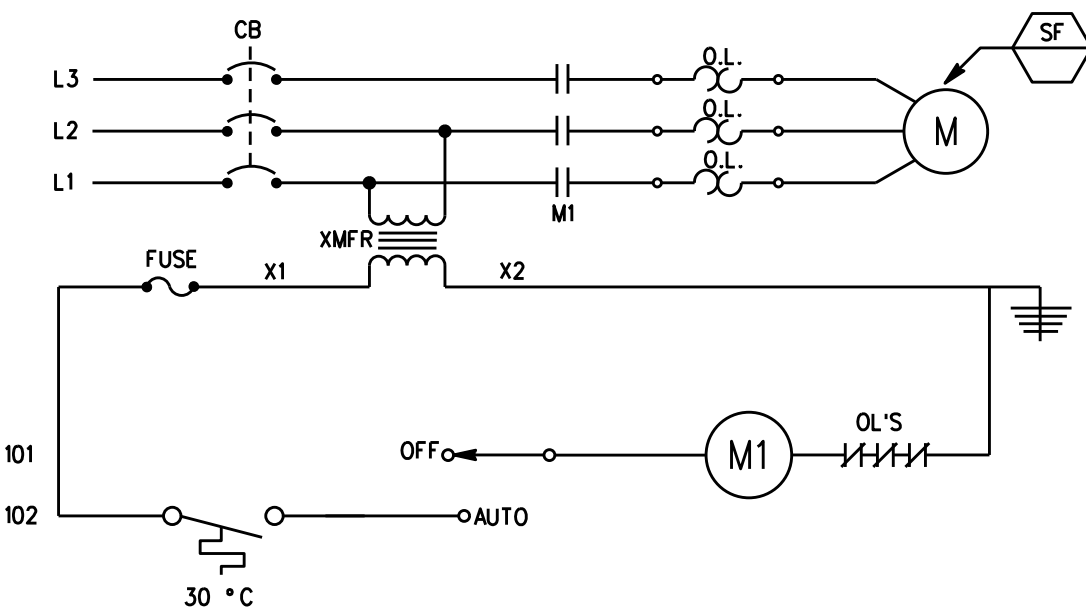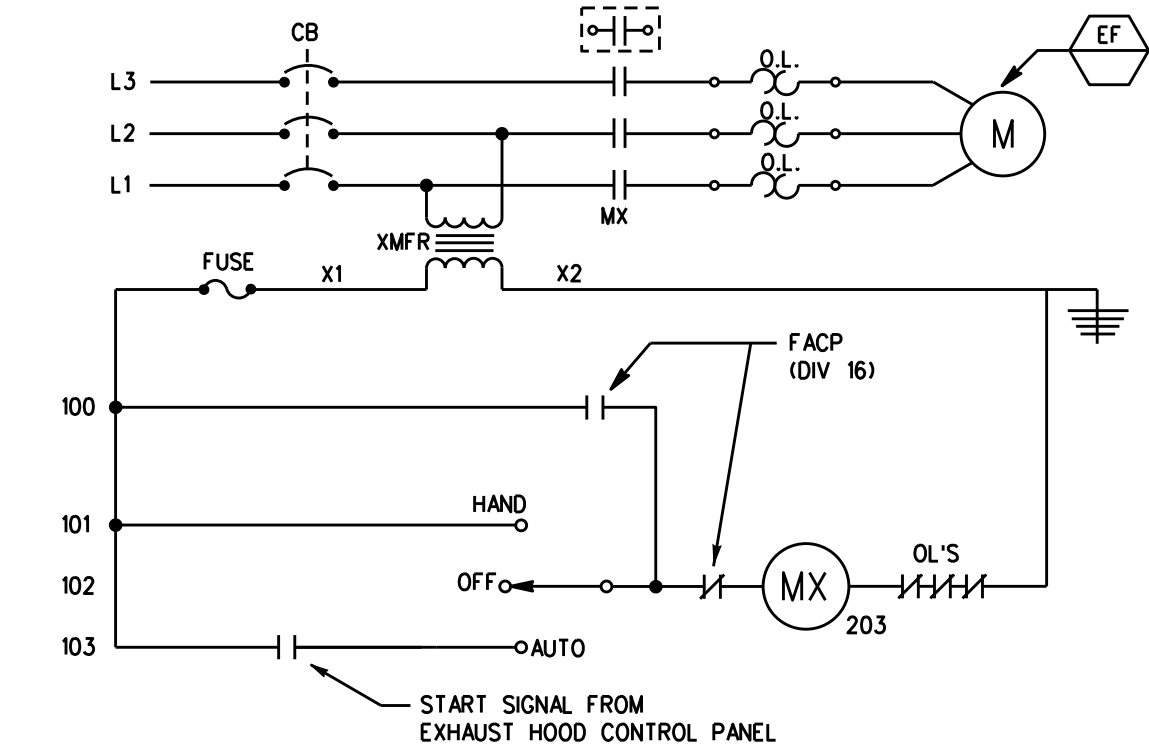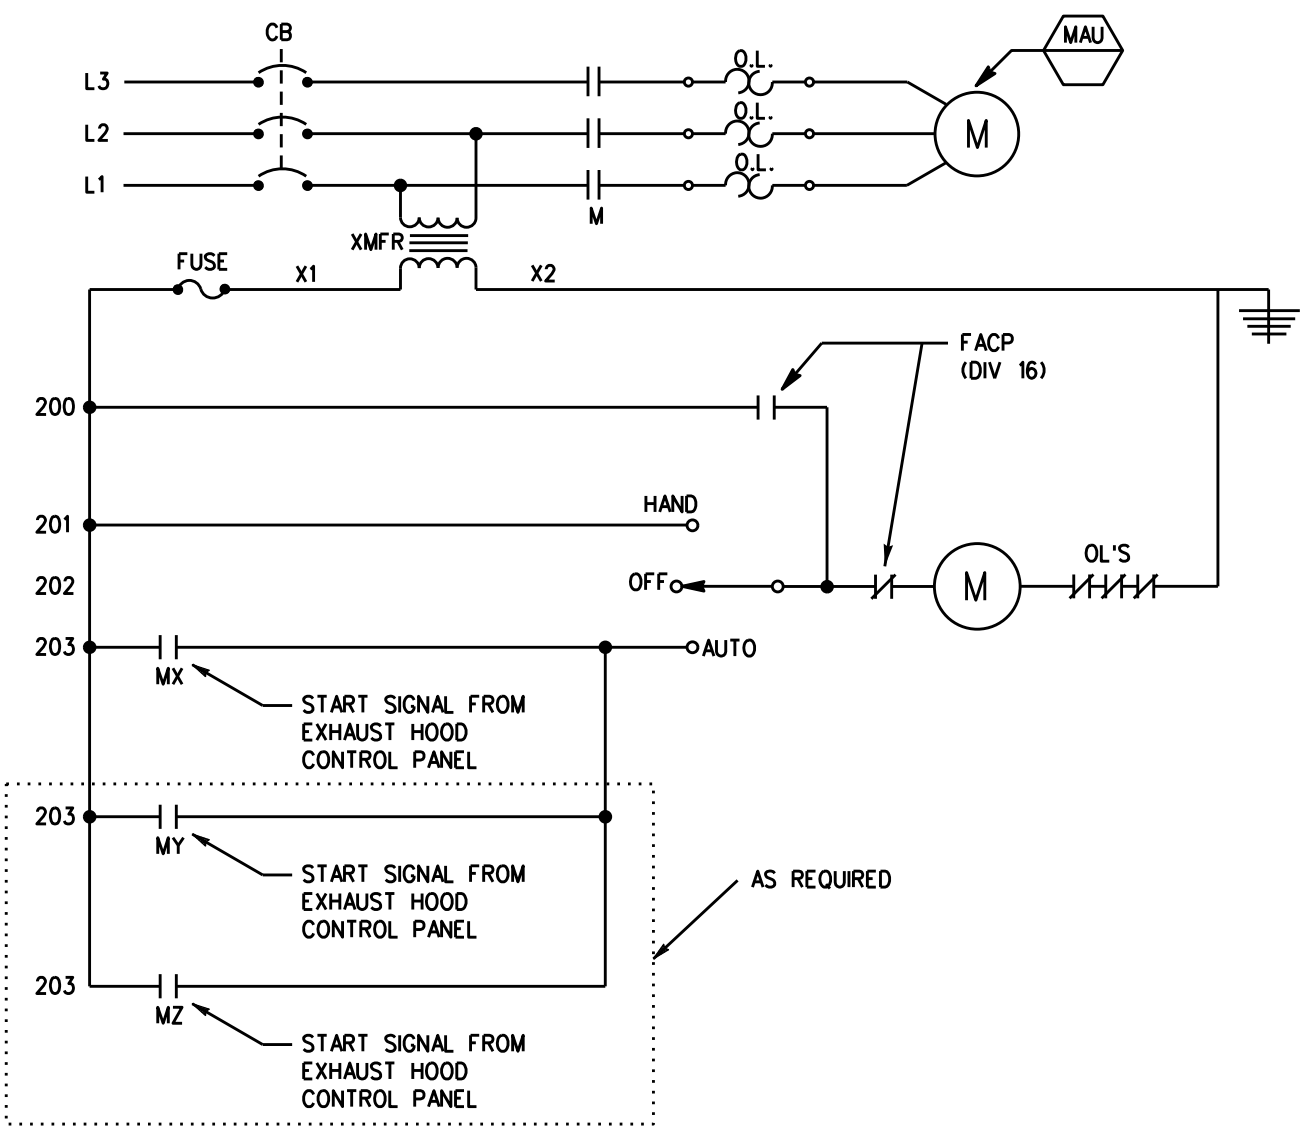


Supply Fan (SF-1 & SF-2) Sequence of Operation:

A wall-mounted thermostat with an "AUTO-OFF" switch located as shown, shall cycle the fan to maintain its setpoint as shown when the switch is in the "AUTO" position. When the switch is in the "OFF" position, the fan shall be stopped.

MAKE-UP AIR UNIT STARTER (TYP.)

EXHAUST FAN STARTER (TYP.)

ADJUSTABLE TO 3 HOURS PER SPEC.

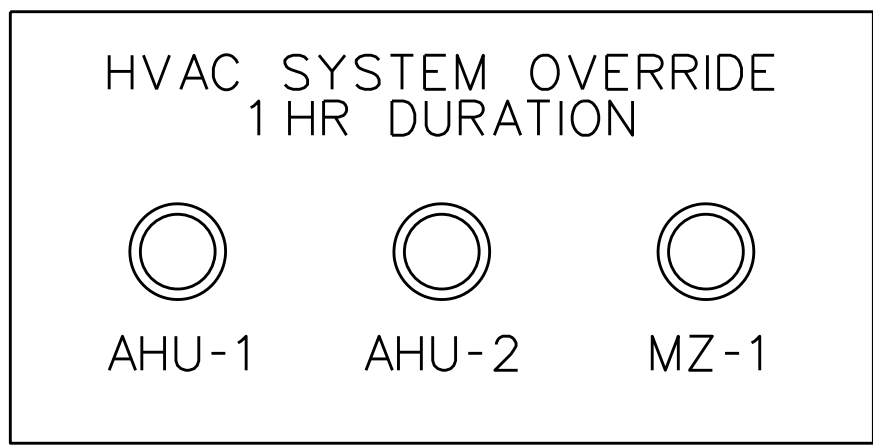


MOMENTARY CONTACT OVERRIDE SWITCHES; LOCATE ON WALL IN RM 132. (SEE SHEET M-4)

NO.	ITEM	TYPE
1	AHU-1 EMCS START OCCUPIED CONTACT (LADDER DIAGRAM LINE 1)	DO
2	AHU-1 EMCS START VENT DELAY CONTACT (LADDER DIAGRAM LINE 8)	DO
3	SPARE	
4	AHU-1 MIXED AIR FILTER ALARM (LADDER DIAGRAM LINE 10, DPS-01-01)	DI
5	AHU-1 LOW TEMPERATURE ALARM (LADDER DIAGRAM LINE 11, R-01-08)	DI
6	AHU-1 SMOKE ALARM (LADDER DIAGRAM LINE 13, R-01-09)	DI
7	SPARE	
8	AHU-1 SPACE TEMPERATURE (PV RETRANSMISSION, TC-01-01)	AI
9	SPARE	
10	SPARE	
11	AHU-2 EMCS START OCCUPIED CONTACT (LADDER DIAGRAM LINE 1)	DO
12	AHU-2 EMCS START VENT DELAY CONTACT (LADDER DIAGRAM LINE 8)	DO
13	SPARE	
14	AHU-2 MIXED AIR FILTER ALARM (LADDER DIAGRAM LINE 10, DPS-02-01)	DI
15	AHU-2 LOW TEMPERATURE ALARM (LADDER DIAGRAM LINE 11, R-02-07)	DI
16	AHU-2 SMOKE ALARM (LADDER DIAGRAM LINE 13, R-02-08)	DI
17	SPARE	
18	AHU-2 SPACE TEMPERATURE (PV RETRANSMISSION, TC-02-01)	AI
19	SPARE	
20	SPARE	

NO.	ITEM	TYPE
21	MZ-1 EMCS START OCCUPIED CONTACT (LADDER DIAGRAM LINE 1)	DO
22	MZ-1 EMCS START VENT DELAY CONTACT (LADDER DIAGRAM LINE 7)	DO
23	SPARE	
24	MZ-1 MIXED AIR FILTER ALARM (LADDER DIAGRAM LINE 9, DPS-03-01)	DI
25	MZ-1 LOW TEMPERATURE ALARM (LADDER DIAGRAM LINE 10, R-03-07)	DI
26	MZ-1 SMOKE ALARM (LADDER DIAGRAM LINE 12, R-03-08)	DI
27	SPARE	
28	SPARE	
29	MZ-1 COLD DECK TEMPERATURE (PV RETRANSMISSION, TC-03-01)	AI
30	MZ-1 HOT DECK TEMPERATURE (PV RETRANSMISSION, TC-03-02)	AI
31	DINING RM. SPACE TEMP (TT-03-03)	AI
32	SPARE	
33	HYDRONICS - START HEATING MODE CONTACT (LADDER DIAGRAM LINE 1)	DO
34	HYDRONICS - START COOLING MODE CONTACT (LADDER DIAGRAM LINE 5)	DO
35	SPARE	
36	HYDRONICS - HW SUPPLY TEMPERATURE (TT-04-02)	AI
37	HYDRONICS - HW RETURN TEMPERATURE (TT-04-03)	AI
38	HYDRONICS - CHW SUPPLY TEMPERATURE (TT-04-04)	AI
39	HYDRONICS - CHW RETURN TEMPERATURE (TT-04-05)	AI
40	SPARE	

NOTES:

1. EMCS CONNECTIONS UNDER THIS CONTRACT TO CONSIST OF WIRING EMCS "POINTS" FROM CONTROL PANELS TO THE DATA TERMINAL CABINET (DTC) AND PROVIDING A 27 mm CONDUIT WITH PULL FROM THE "FUTURE FID" LOCATION (SEE M-7) TO THE TELEPHONE BACKBOARD IN THE COMMUNICATIONS ROOM.

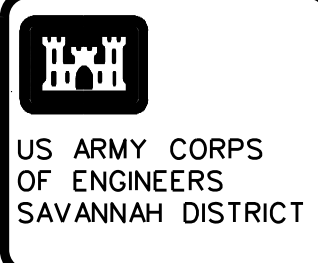

REV.	DATE	DESCRIPTION
1	14 JUL 97	U.S. ARMY ENGINEER DISTRICT CORPS OF ENGINEERS SAVANNAH, GEORGIA

SYMBOL	DESCRIPTION
30SEP04 DGC	REVISAS BUILT

RANGER BARRACKS COMPLEX FORT BENNING, GEORGIA DINING FACILITY	MISC. HVAC CONTROLS
---	---------------------

PLATE REFERENCE NUMBER:
MC-9
SHEET 344

DESIGNED BY:	
SUBMITTED BY:	
CHIEF,	
RECOMMENDED:	

DATE:	14JUL97	REV.
CATEGORY CODE	721-11-11	
SOLICITATION NO:	DACA21-97-B-0055	
PLOT DATE:	\$\$\$DATE\$\$\$	
PLOT SCALE:	:	

U.S. ARMY ENGINEER DISTRICT
CORPS OF ENGINEERS
SAVANNAH, GEORGIA

[illegible]

RANGER BARRACKS COMPLEX
FORT BENNING, GEORGIA

DINING FACILITY
PLUMBING

PLATE
REFERENCE
NUMBER:

MP-1
ET 345

SYMBOL	DESCRIPTION	SYMBOL	DESCRIPTION	SYMBOL	DESCRIPTION
— — —	COLD WATER SUPPLY		GATE VALVE	AFF	ABOVE FINISHED FLOOR
— 45 —	HOT WATER (45° C)		CHECK VALVE	AD	AREA DRAIN
— 60 —	HOT WATER (60° C)		GLOBE VALVE	C.I.	CAST IRON
— SS —	SANITARY SEWER		BALANCING VALVE	CO	CLEAN OUT
-----	SANITARY SEWER VENT		FLEXIBLE CONNECTION	CONN	CONNECT
— GW —	GREASE LAIDEN SANITARY SEWER		3-WAY CONTROL VALVE	DTL	DETAIL
— WPS —	WASTE PULPING SUPPLY		2-WAY CONTROL VALVE	DF	DRINKING FOUNTAIN
— WPR —	WASTE PULPING RETURN		UNION CONNECTION	EFF	EFFICIENCY
— G —	GAS PIPING		FLANGE CONNECTION	EWT	ENTERING WATER TEMP
	PITCH DN IN DIR OF ARROW		THERMOMETER	FCO	FLOOR CLEAN OUT
	ELBOW TURNING UP		PRESSURE GAUGE	FD	FLOOR DRAIN
	ELBOW TURNING DOWN		DIRECTION OF FLOW	HB	HOSE BIBB
			Y STRAINER WITH BLOW-OFF VALVE	INV	INVERT
			PRESSURE RELIEF VALVE	LWT	LEAVING WATER TEMP
			PRESSURE REGULATING/REDUCING VALVE	LAV	LAVATORY
			MANUAL AIR VENT	P	PLUMBING FIXTURE
			VACUUM RELIEF VALVE	PD	PRESSURE DROP
		WH	WALL HYDRANT (FROST PROOF)	VTR	VENT THRU ROOF
		HB	HOSE BIBB	WH	WATER HEATER
		NC	NORMALLY CLOSED	WCO	WALL CLEAN OUT
		NO	NORMALLY OPEN	WC	WATER CLOSET
				WHA	WATER HAMMER ARRESTOR

DOMESTIC WATER HEATER SCHEDULE 					
ITEM	HEAT SOURCE	STORAGE L	TEMPERATURE RISE (°C)	MIN. RECOVERY RATE	REMARKS
WH-1	NAT. GAS	3250	55°C	6000 L/h	FORCED DRAFT

DOMESTIC HOT WATER PUMP SCHEDULE									
SYMBOL	SERVICE	L/s	TOTAL HEAD	FLUID TEMP	MAXIMUM WATTS	SERVICE (MIN) EFFICIENCY	TYPE	LOCATION	REMARKS
HWCP-1	45°C WATER	0.5	57.5 kPa	54°C	200	20%	IN-LINE		
HWCP-2	60°C WATER	0.5	57.5 kPa	54°C	200	20%	IN-LINE		

SUMP PUMP SCHEDULE 						
ITEM	WATTS	L/s	kPa	TYPE	LOCATION	REMARKS
SP-1	200	0.8	60	PACKAGED SYSTEM		
SP-2	200	0.8	60	PACKAGED SYSTEM		
SP-3	200	0.8	60	PACKAGED SYSTEM		

LIFE

PLUMBING FIXTURE SCHEDULE						
SYMBOL	DESCRIPTION	COLD WATER	HOT WATER	VENT	WASTE	REMARKS
P-1B	WATER CLOSET	25	—	50	100	①
P-2A	WATER CLOSET	25	—	50	100	HANDICAPPED ①
P-3	URINAL	20	—	32	50	①
P-5B	LAVATORY	15	15	32	32	HANDICAPPED ① ②
P-8A	SERVICE SINK	15	15	40	80	
P-15	ELECTRIC WATER COOLER	15	—	32	32	
WH	WALL HYDRANT	20	—	—	—	

KEYED NOTES:


- ① HARDWARE TO BE CHROME OR STAINLESS STEEL.
② BOWL TO BE SELF-RIMMING. SEE ARCH. FOR LOCATION IN COUNTER.

GENERAL NOTES:

1. SEE GENERAL NOTES ON SHEET M-2

KEYED NOTES:

- SEE SHEET W-5 FOR CONTINUATION OF SEWER AND WATER LINES, AND SHEET MS-3 FOR CONTINUATION OF GAS LINE.
- GREASE TRAP. SEE DETAIL 4, SHEET MP-11.
- PIPING ABOVE CEILING TO BE HUNG ON TRAPEZE HANGERS.
- 65mm DCW; 32mm-45°C.
- 25mm-45°C; 50mm DCW.
- SEE RISER R-11, SHEET MP-10 FOR WASTE PULPING SYSTEM SCHEMATIC.
- 150mm VENT LINE. RUN LINE TO BUILDING IN GROUND.

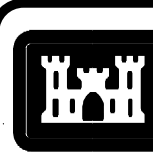

US ARMY CORPS
OF ENGINEERS
SAVANNAH DISTRICT

DATE: 14 JUL 97
REV. 1
CATEGORY CODE
721-H-11
SOLICITATION NO.
DA21-97-B-0055
PLOT DATE: 30 JUL 97
PLOT SCALE: 1:100

U.S. ARMY ENGINEER DISTRICT
CORPS OF ENGINEERS
SAVANNAH, GEORGIA


--	--	
RANGER BARRACKS COMPLEX
FORT BENNING, GEORGIA

DINING FACILITY
PLUMBING PLAN

PLATE
REFERENCE
NUMBER:


MP-2
SHEET 346

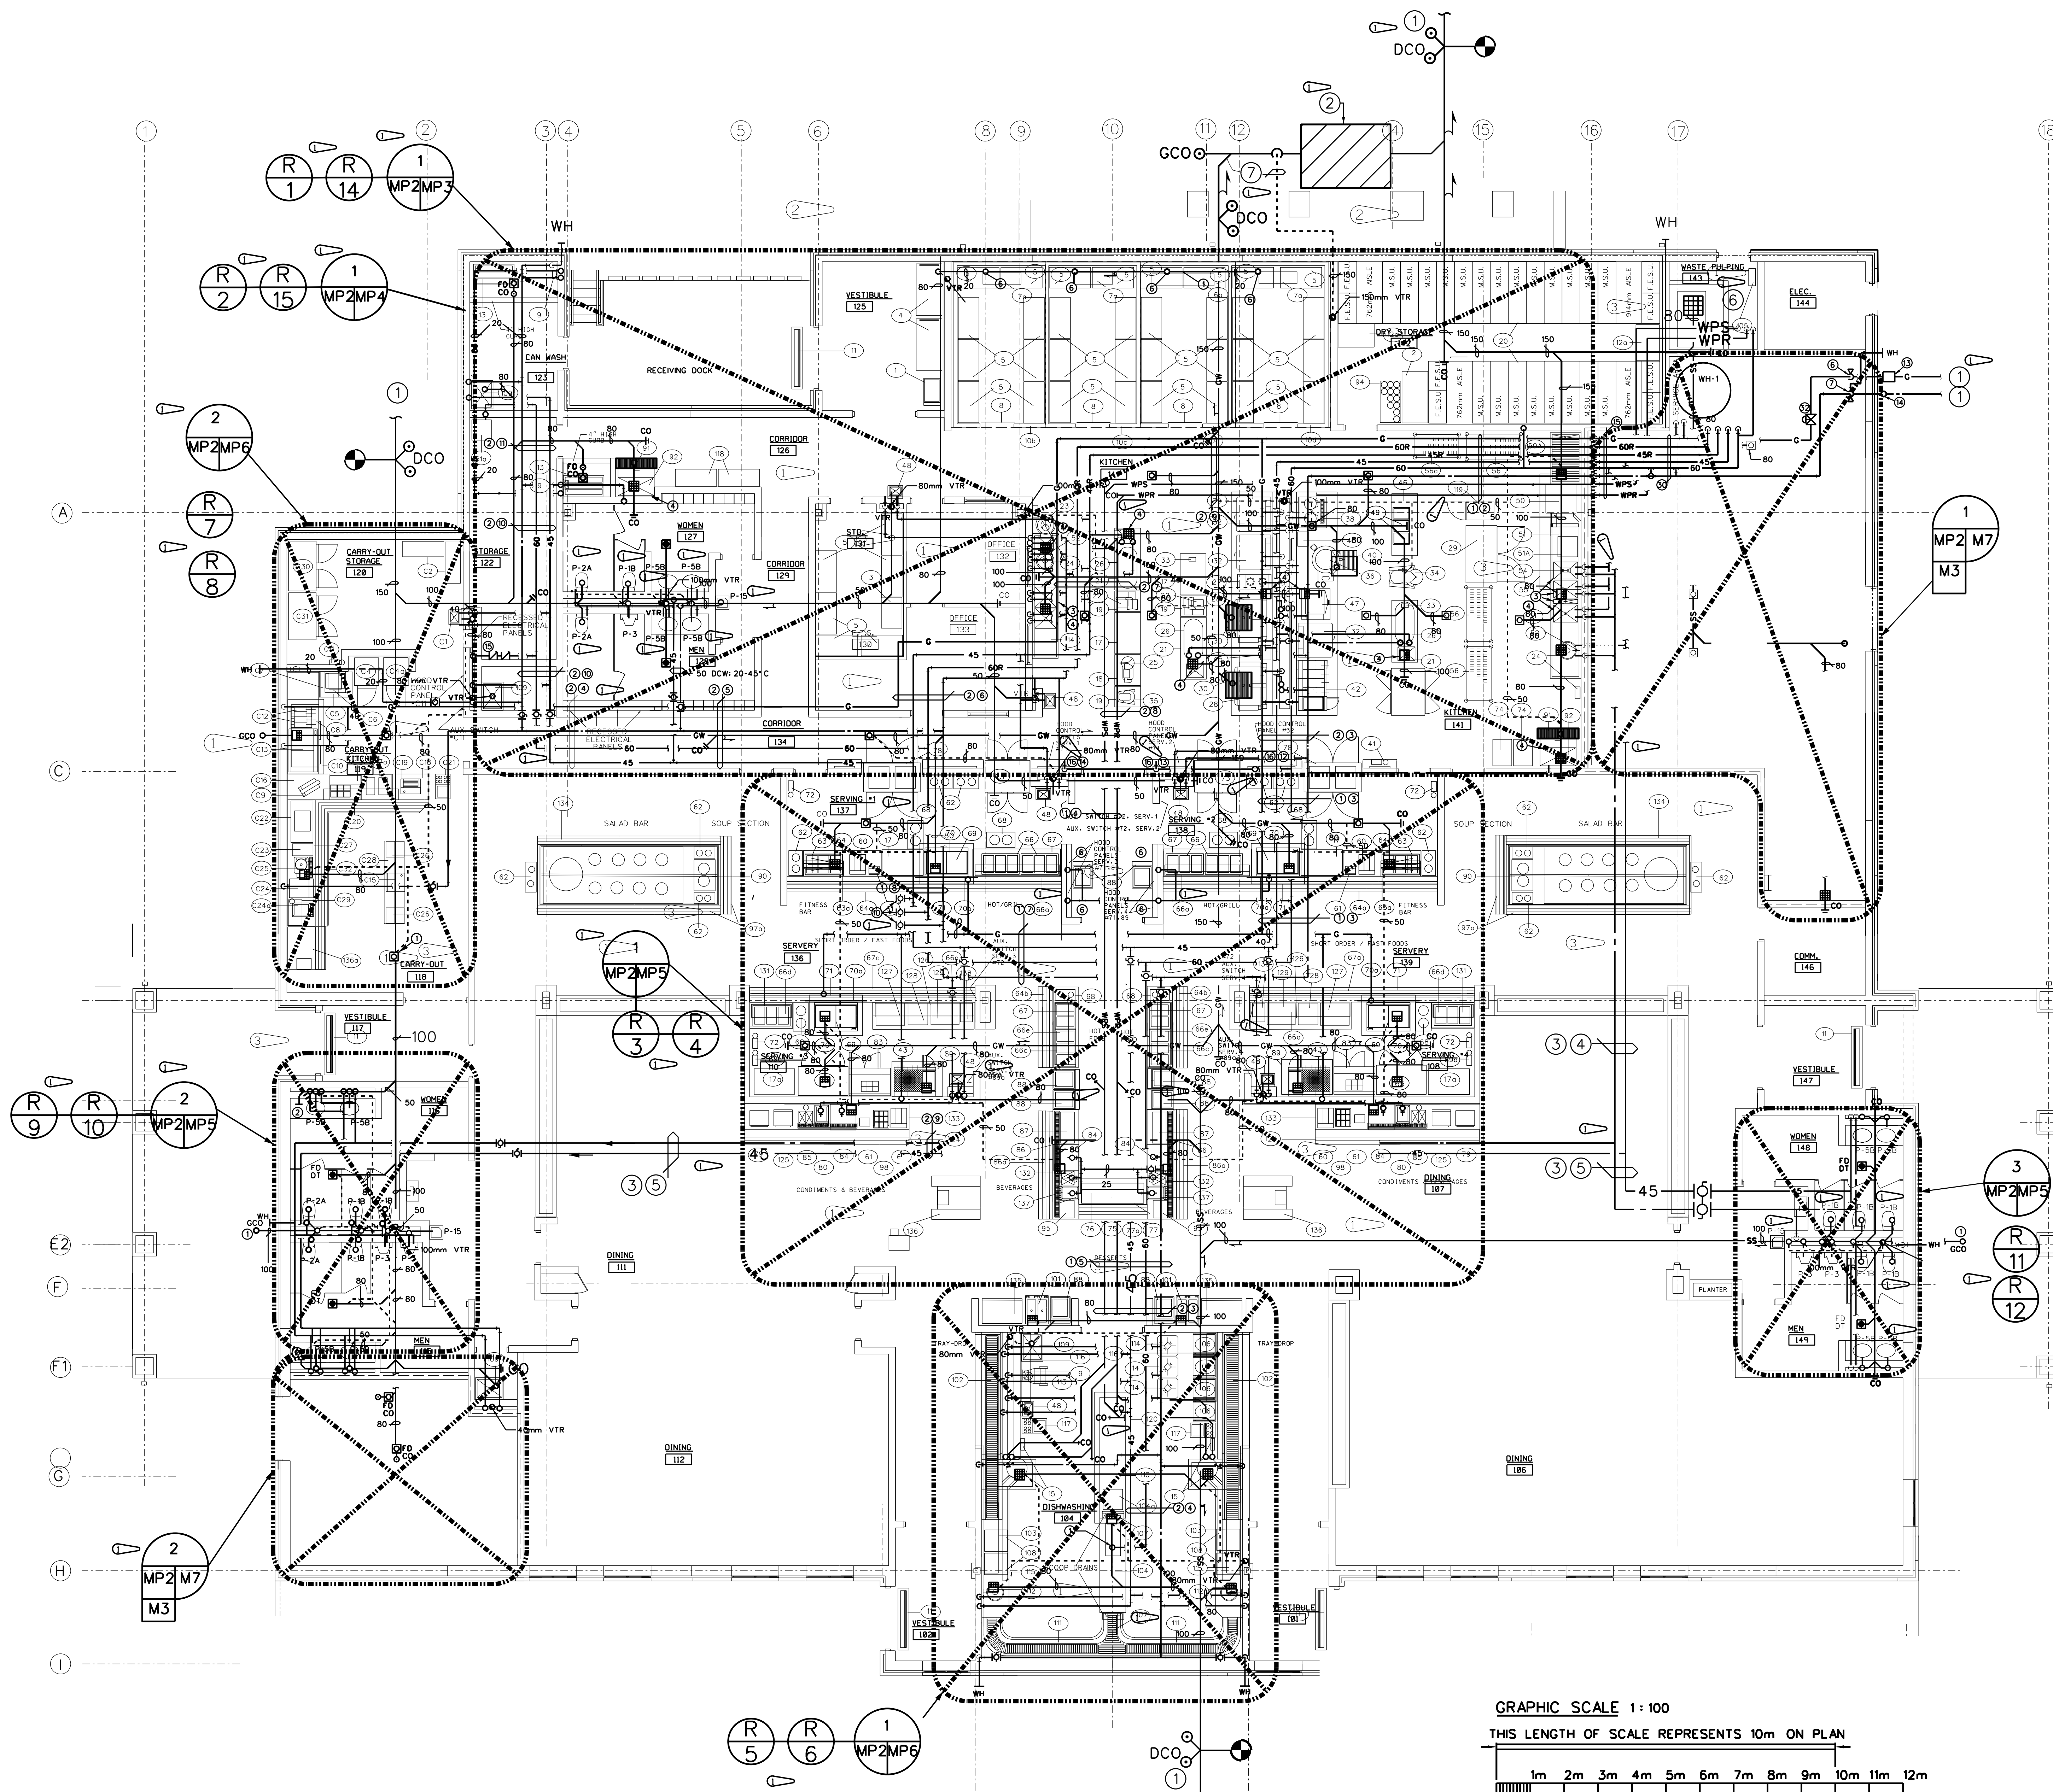

DINING HALL: PLUMBING PLAN
SCALE: 1:100

GRAPHIC SCALE 1:100


THIS LENGTH OF SCALE REPRESENTS 10m ON PLAN

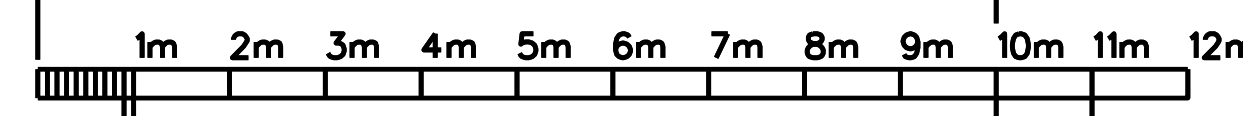

THIS LENGTH OF
SCALE REPRESENTS
100mm ON PLAN

THIS LENGTH OF
SCALE REPRESENTS
1m ON PLAN

ALL DIMENSIONS ARE MILLIMETERS (mm) UNLESS OTHERWISE NOTED.

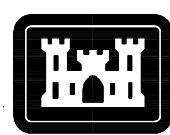

US ARMY CORPS
OF ENGINEERS
SAVANNAH DISTRICT

DATE: 14 JUL 97
REV. 1
CATEGORY CODE
721-1-11
SOLICITATION NO.
DACA21-97-B-0055
PLOT DATE: 15 DEC 95
PLOT SCALE:
CONTRACT NO: DACA21-98-C-0022

U.S. ARMY ENGINEER DISTRICT
CORPS OF ENGINEERS
SAVANNAH, GEORGIA


30 SEP 04 DDC
17 AUG 98 SWM
30 JUL 97 SWM
DATE BY


AS BUILT
REVISED IN ACCORDANCE WITH MODIFICATION 98-22-H
GENERAL REVISIONS
SYMBOL DESCRIPTION

RANGER BARRACKS COMPLEX
FORT BENNING, GEORGIA
DINING FACILITY
ENLARGED PLUMBING PLANS

PLATE
REFERENCE
NUMBER:
MP-3
SHEET 347

RECORD DRAWING

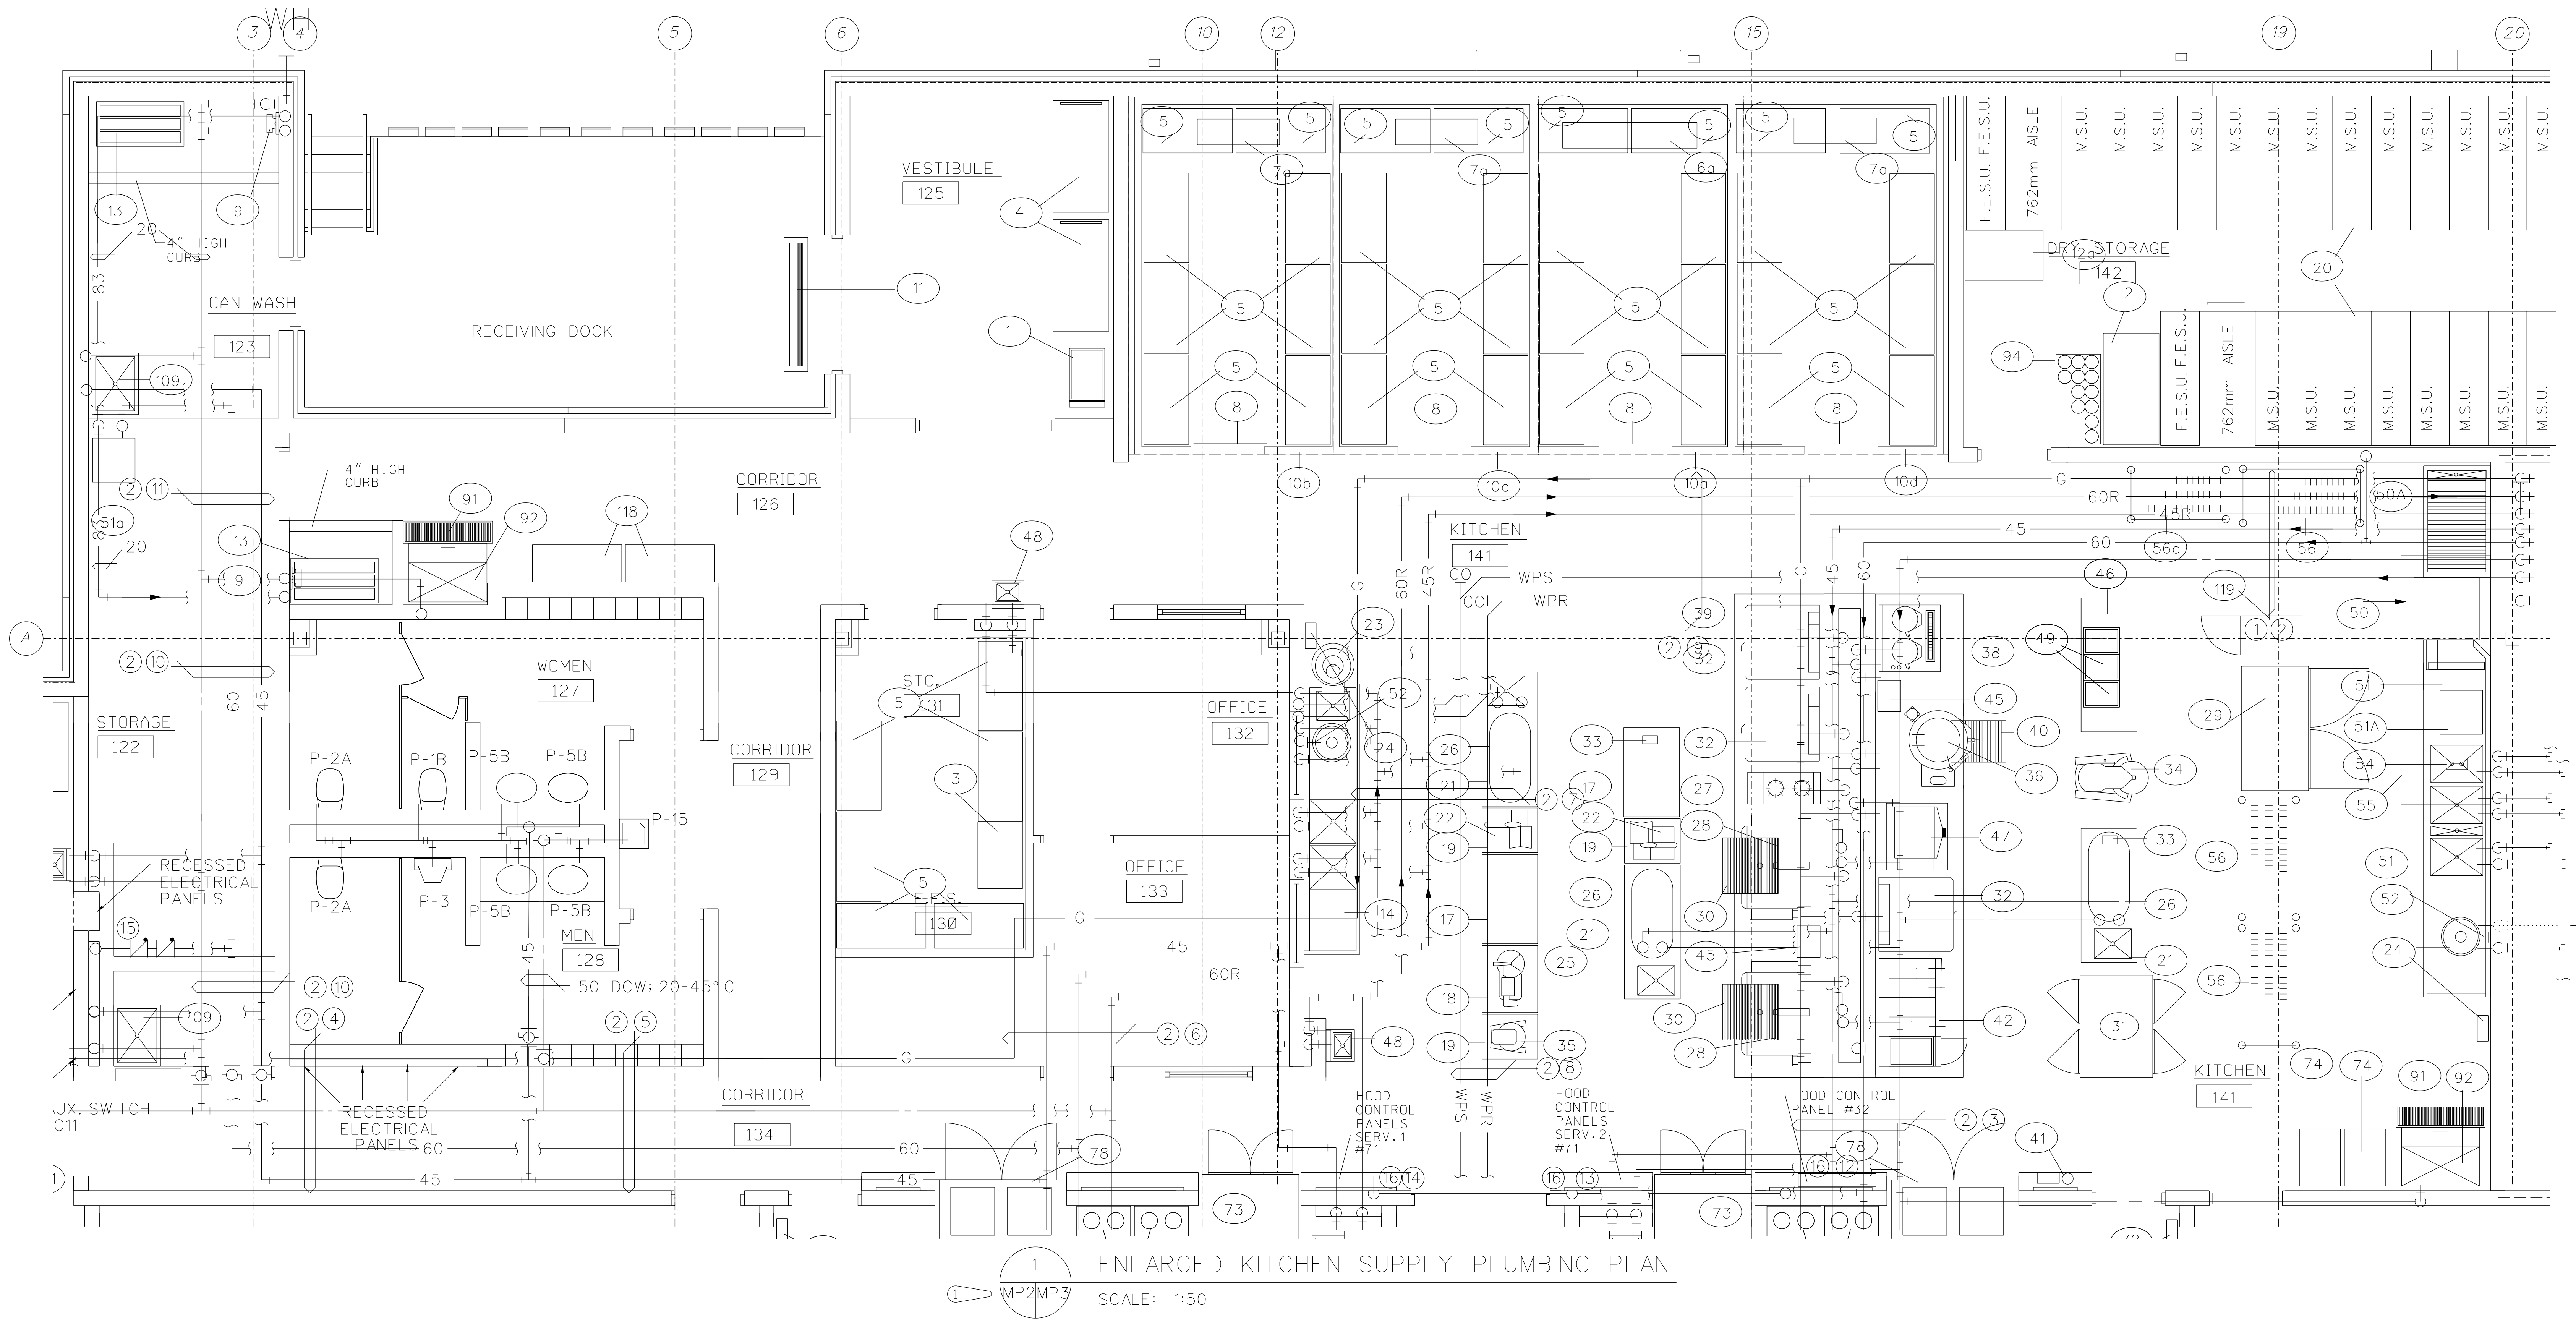

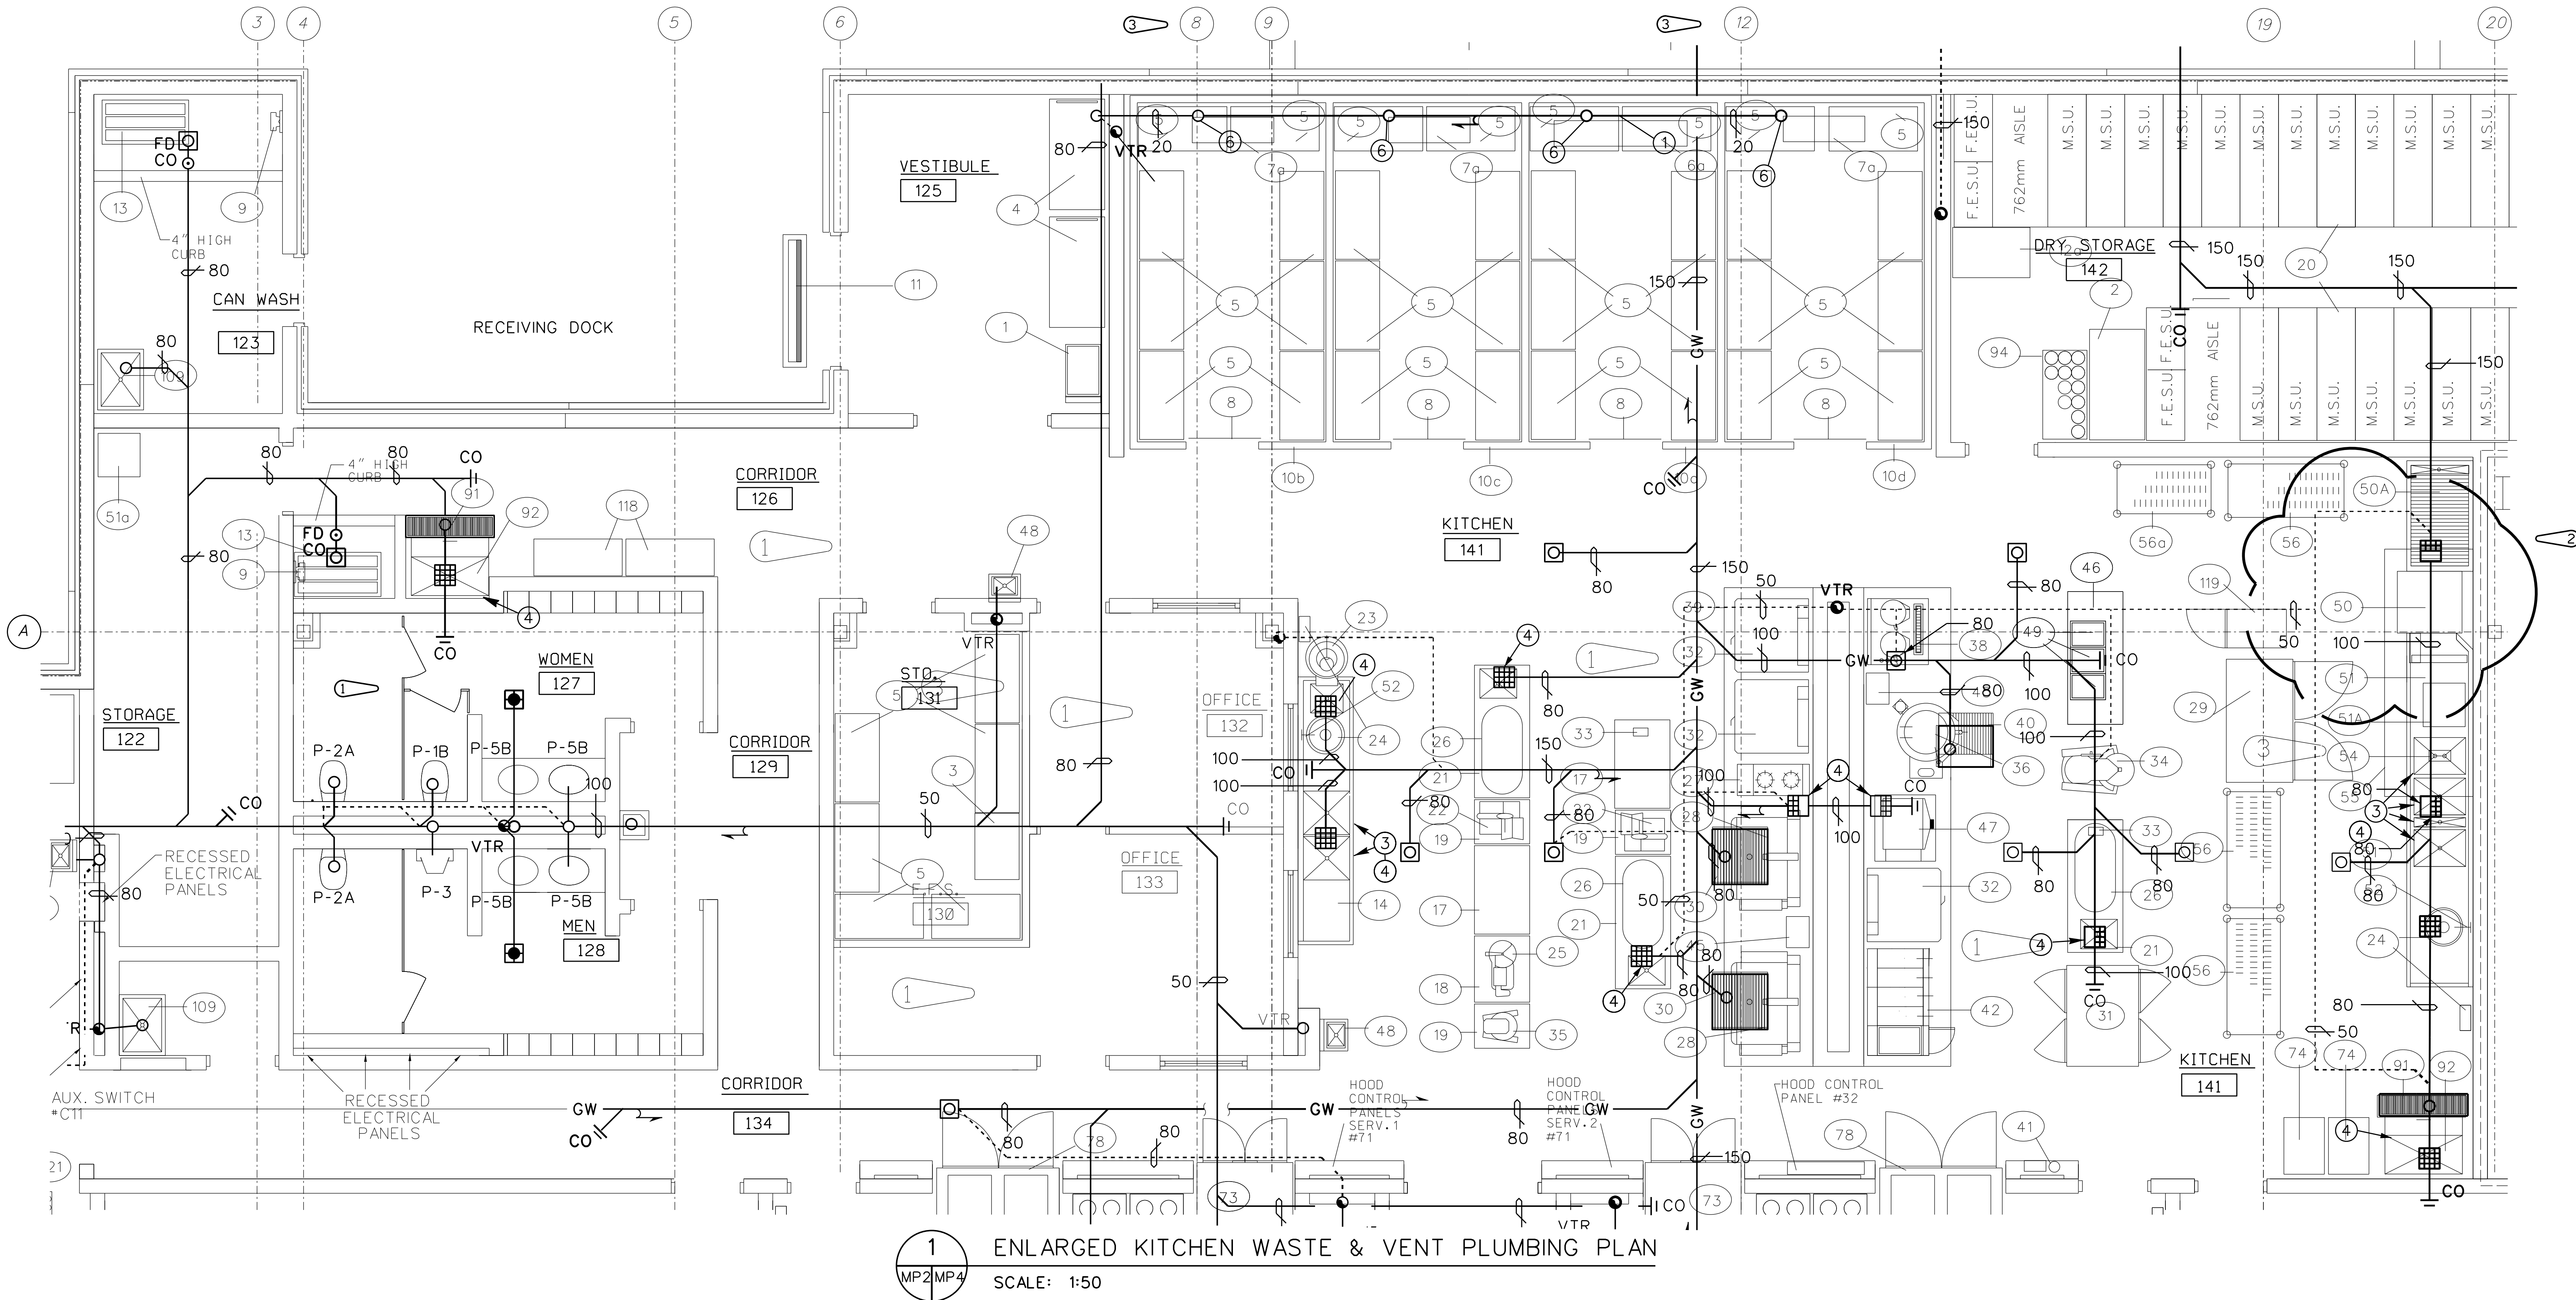

1 ENLARGED KITCHEN WASTE & VENT PLUMBING PLAN
SCALE: 1:50

GENERAL NOTES:


1. SEE GENERAL NOTES ON SHEET M-2
2. ALL FLOOR SINKS AND FLOOR DRAINS IN THE KITCHEN SHALL HAVE SCREWED CONNECTIONS OR GASKETING MATERIAL CAPABLE OF WITHSTANDING TEMPERATURES OF 120°C MINIMUM.

KEYED NOTES FOR KITCHEN
WASTE & VENT PLUMBING:

1. INSTALL HEAT TAPE ON PIPING FROM 300mm UPSTREAM OF THE FREEZER TO 300mm DOWNSTREAM OF THE FREEZER.
2. RUN DRAINS TO FLOOR SINKS INDIVIDUALLY. DO NOT COMBINE PIPING.
3. EACH BASIN SHALL DRAIN TO THE FLOOR SINK INDEPENDENTLY.
4. USE COPPER TUBING FROM EQUIPMENT TO FLOOR SINK. TUBING SHALL BE FULL SIZE OF OPENING PROVIDED ON EQUIPMENT WITH 20mm THE MINIMUM SIZE ALLOWABLE. TERMINATE LINE 25mm ABOVE THE FLOOR SINK.
5. RUN CONDENSATE DRAIN LINE TO 25mm ABOVE FLOOR DRAIN BELOW.
6. CONDENSATE DRAIN LINE FROM REFRIGERATOR/FREEZER UNIT.

GRAPHIC SCALE 1:50


THIS LENGTH OF SCALE REPRESENTS 5m ON PLAN

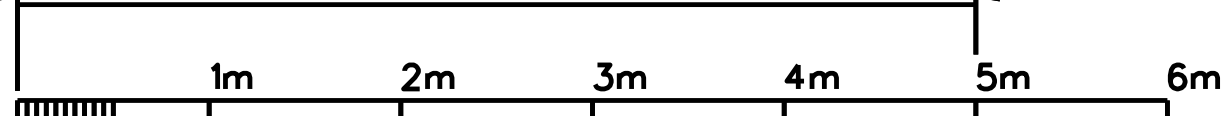


THIS LENGTH OF
SCALE REPRESENTS
50mm ON PLAN

THIS LENGTH OF
SCALE REPRESENTS
1m ON PLAN


ALL DIMENSIONS ARE MILLIMETERS (mm) UNLESS OTHERWISE NOTED.

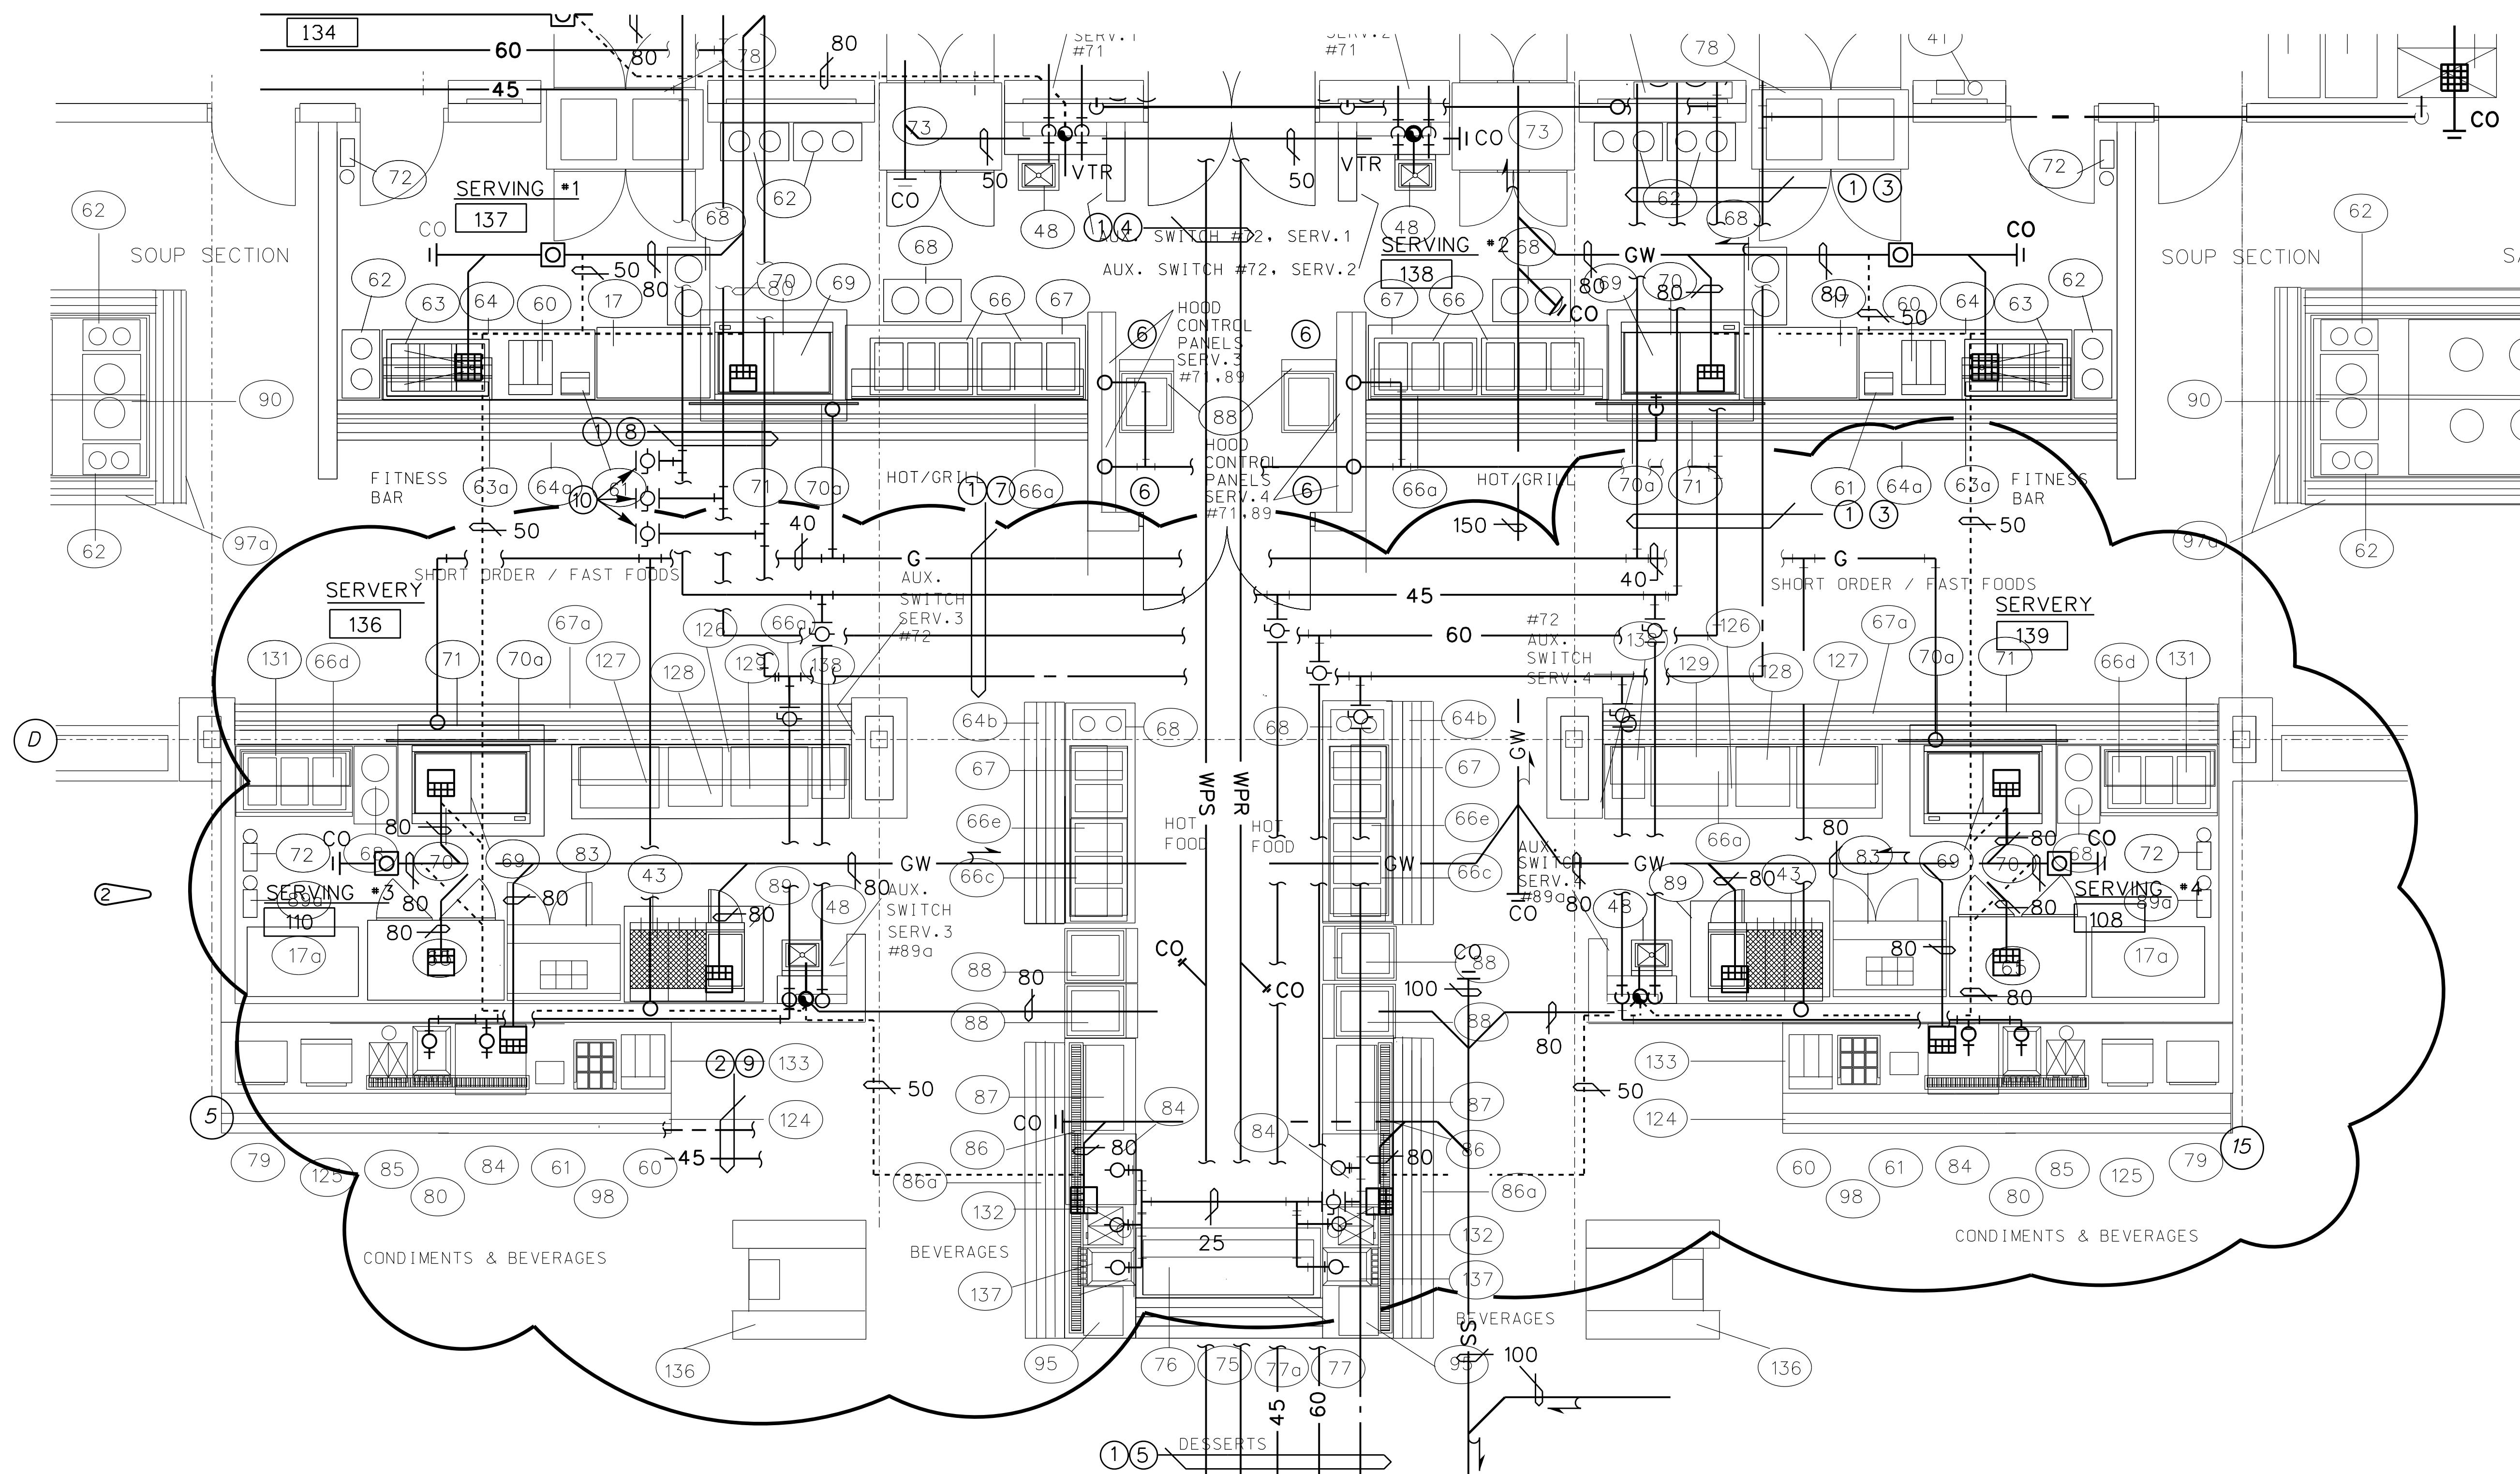

1 ENLARGED SERVERY PLUMBING PLAN
SCALE: 1:50

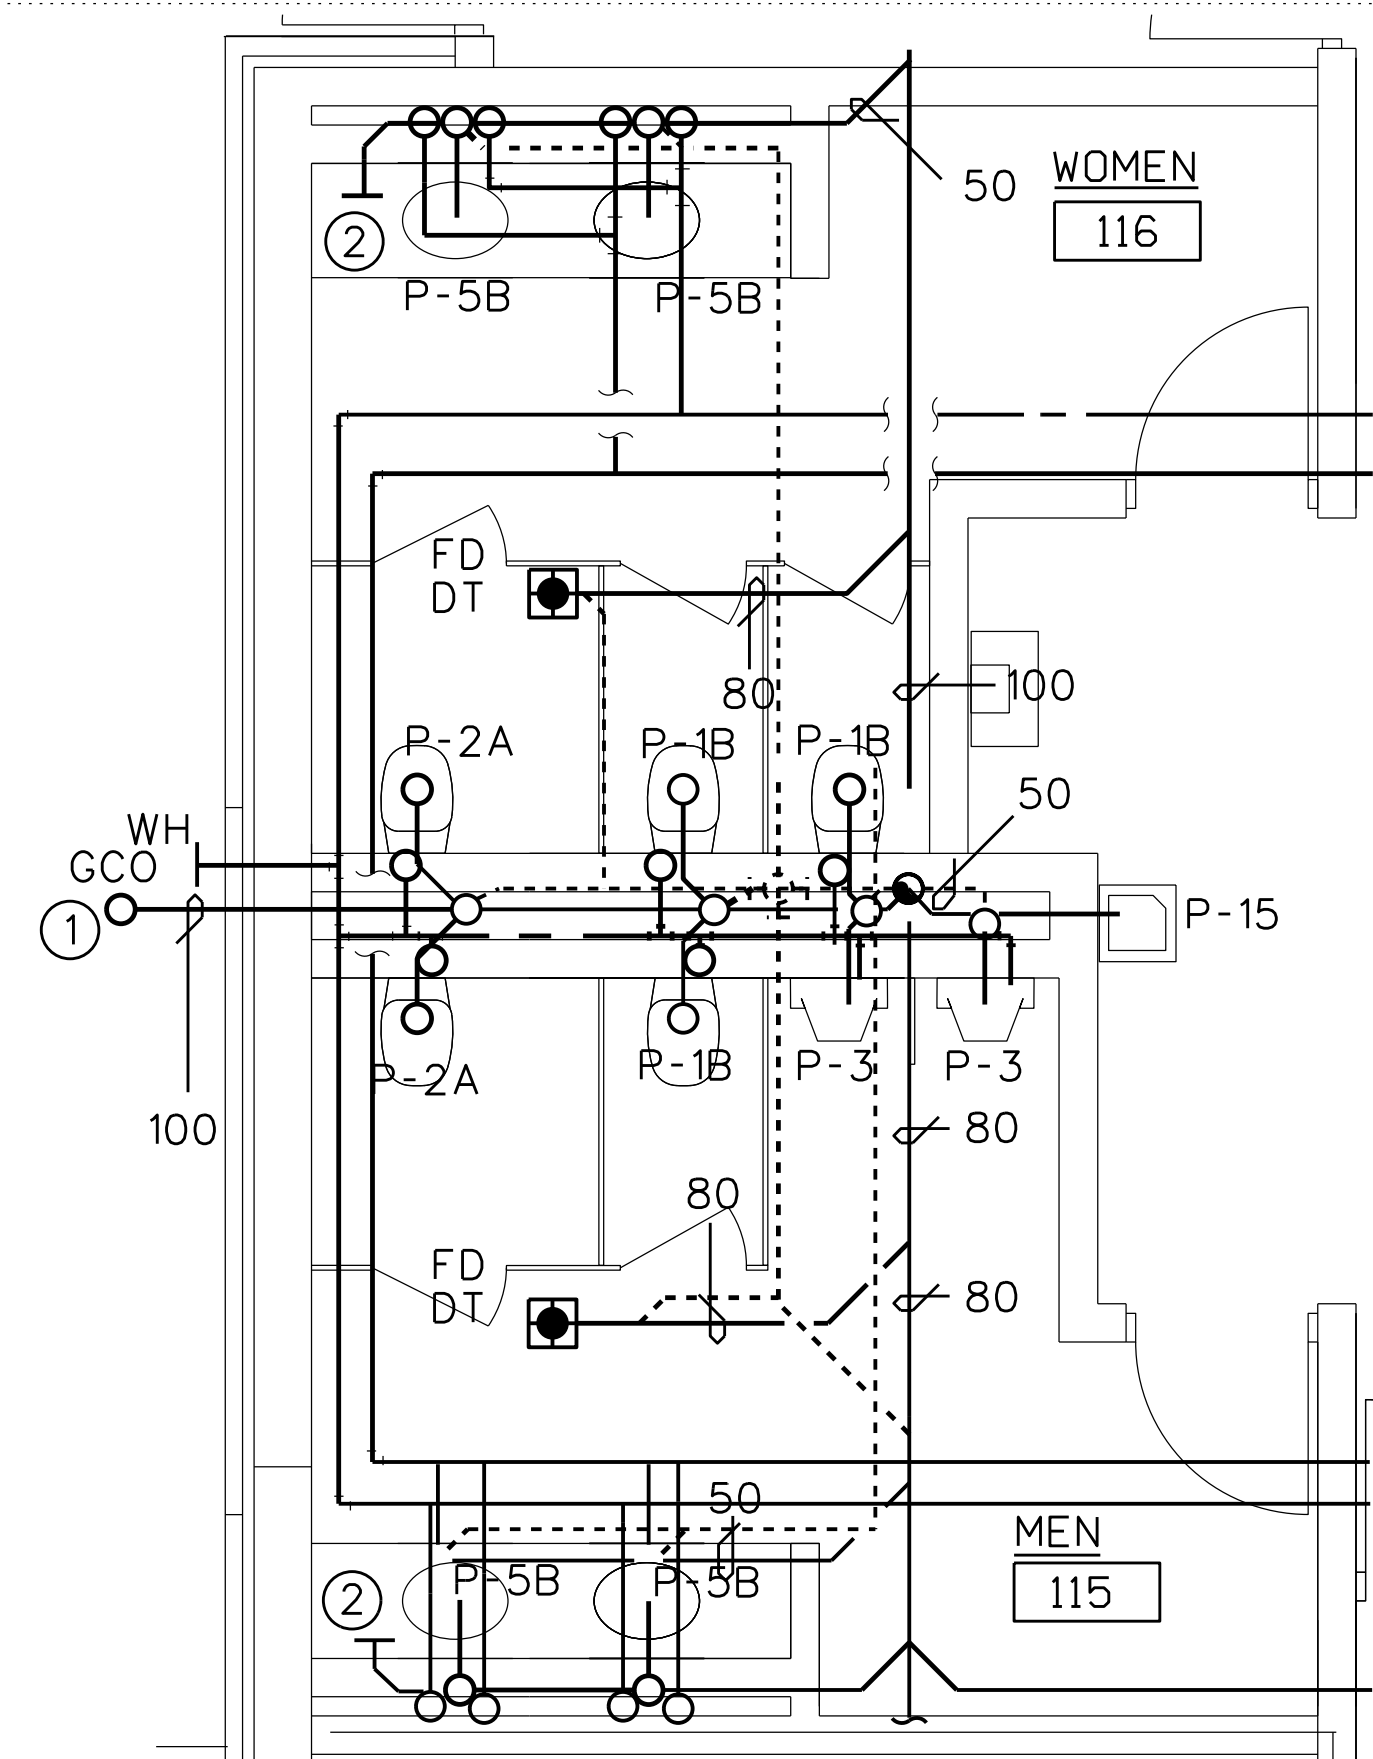

2 TOILET AREA PLUMBING PLAN
SCALE: 1:50

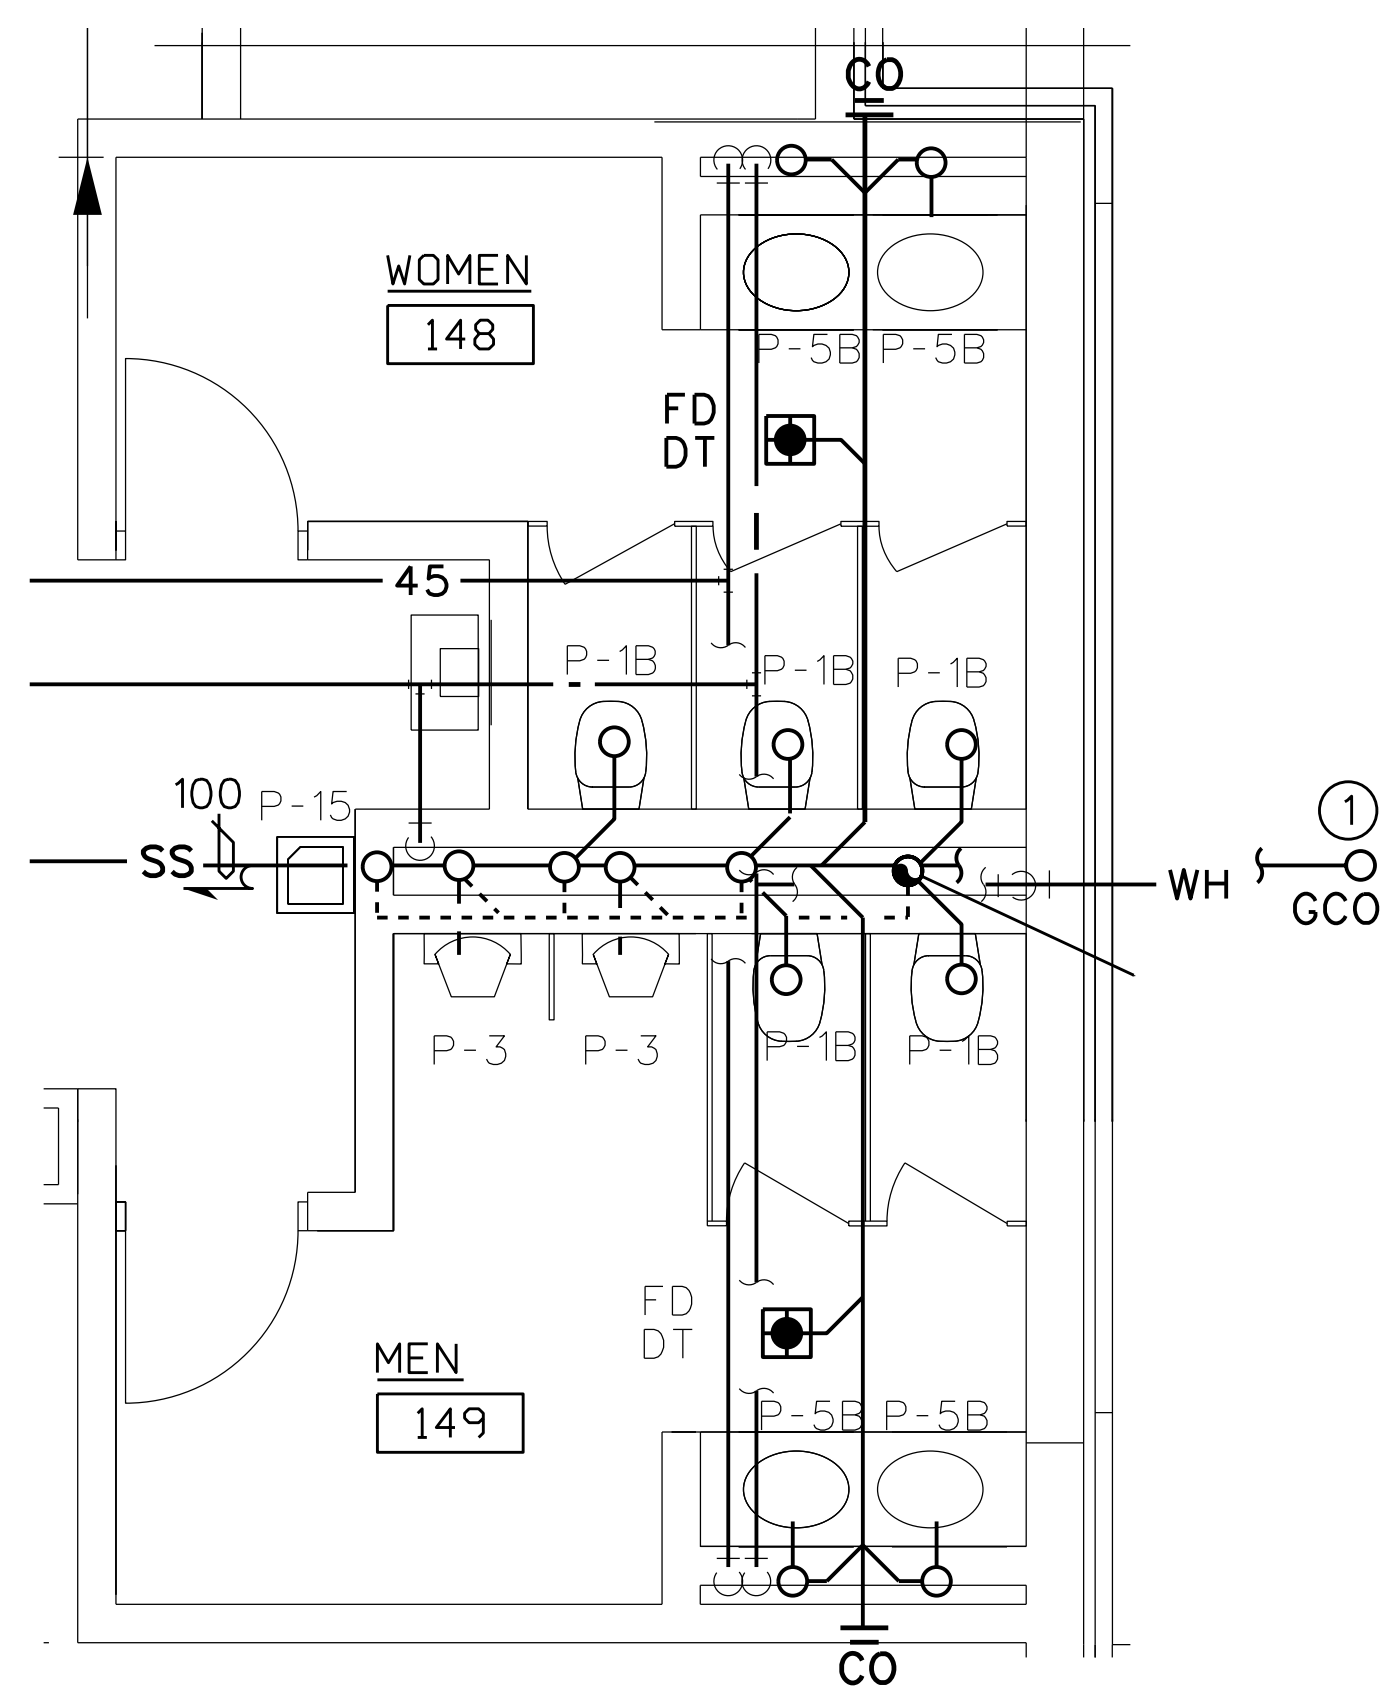

3 TOILET AREA PLUMBING PLAN
SCALE: 1:50

GENERAL NOTES:

1. SEE GENERAL NOTES ON SHEET M-2

KEYED NOTES FOR TOILET AREA PLUMBING:


- 1 GRADE CLEANOUT. USE METALLIC CAP.
- 2 WALL CLEANOUT. INSTALL UNDER COUNTER.

SERVERY PLUMBING NOTES:

1. SEE GENERAL NOTES ON SHEET M-2
2. ALL FLOOR SINKS AND FLOOR DRAINS IN THE SERVERY SHALL HAVE SCREWED CONNECTIONS OR GASKETING MATERIAL CAPABLE OF WITHSTANDING TEMPERATURES OF 120° C MINIMUM.

KEYED NOTES FOR SERVERY PLUMBING:

- 1 PIPING IN CRAWL SPACE TO BE HUNG ON TRAPEZE HANGERS.
- 2 PIPING ABOVE CEILING TO BE HUNG ON TRAPEZE HANGERS.
- 3 65mm DCW; 40mm-60° C; 50mm-45° C; 50mm GAS.
- 4 80mm WPS; 80mm WPR.
- 5 80mm WPS; 80mm WPR; 32mm-45° C; 25mm-60° C; 40mm DCW.
- 6 WATER LINES FROM HOOD CONTROL PANEL SHALL BE INSULATED SAME AS DOMESTIC HOT WATER LINES PER SPECIFICATION SECTION 15250.
- 7 50mm DCW; 32mm-60° C; 40mm-45° C; 40mm GAS.
- 8 50mm DCW; 25mm-45° C.
- 9 INSTALL VERTICAL DROP IN LINE WITH A FULL PORT BALL VALVE AND HOSE CONNECTION FOR BUILDING DRAIN.

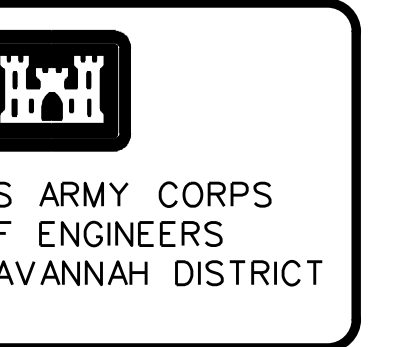



DATE: 14 JUL 97	REV.
CATEGORY CODE 721-H-11	
SOLICITATION NO. DCA21-97-B-0055	
PLOT DATE: 30 JUL 97	
PLOT SCALE: 1:50	

AS BUILT	30 SEP 04	DCG
REVISED IN ACCORDANCE WITH MODIFICATION 98-22-H	17 AUG 98	SWM
GENERAL REVISIONS:	30 JUL 97	SWM
SYMBOL	DATE	BY

RANGER BARRACKS COMPLEX FORT BENNING, GEORGIA DINING FACILITY ENLARGED PLUMBING PLANS
--

PLATE REFERENCE NUMBER: MP-5 SHEET 349
--

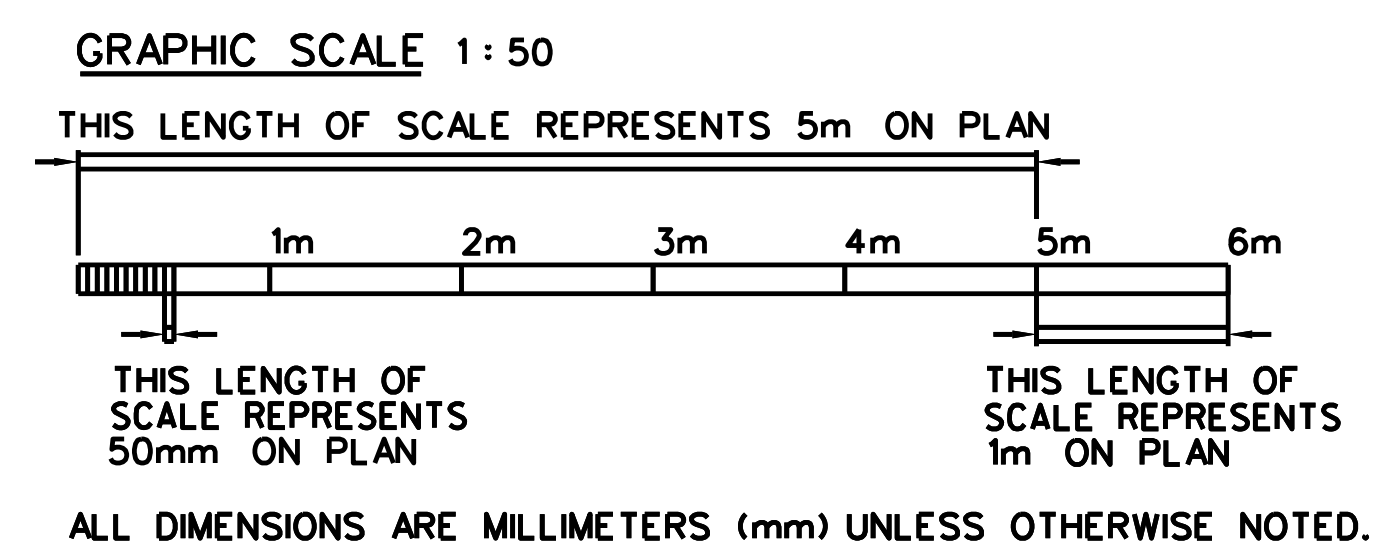

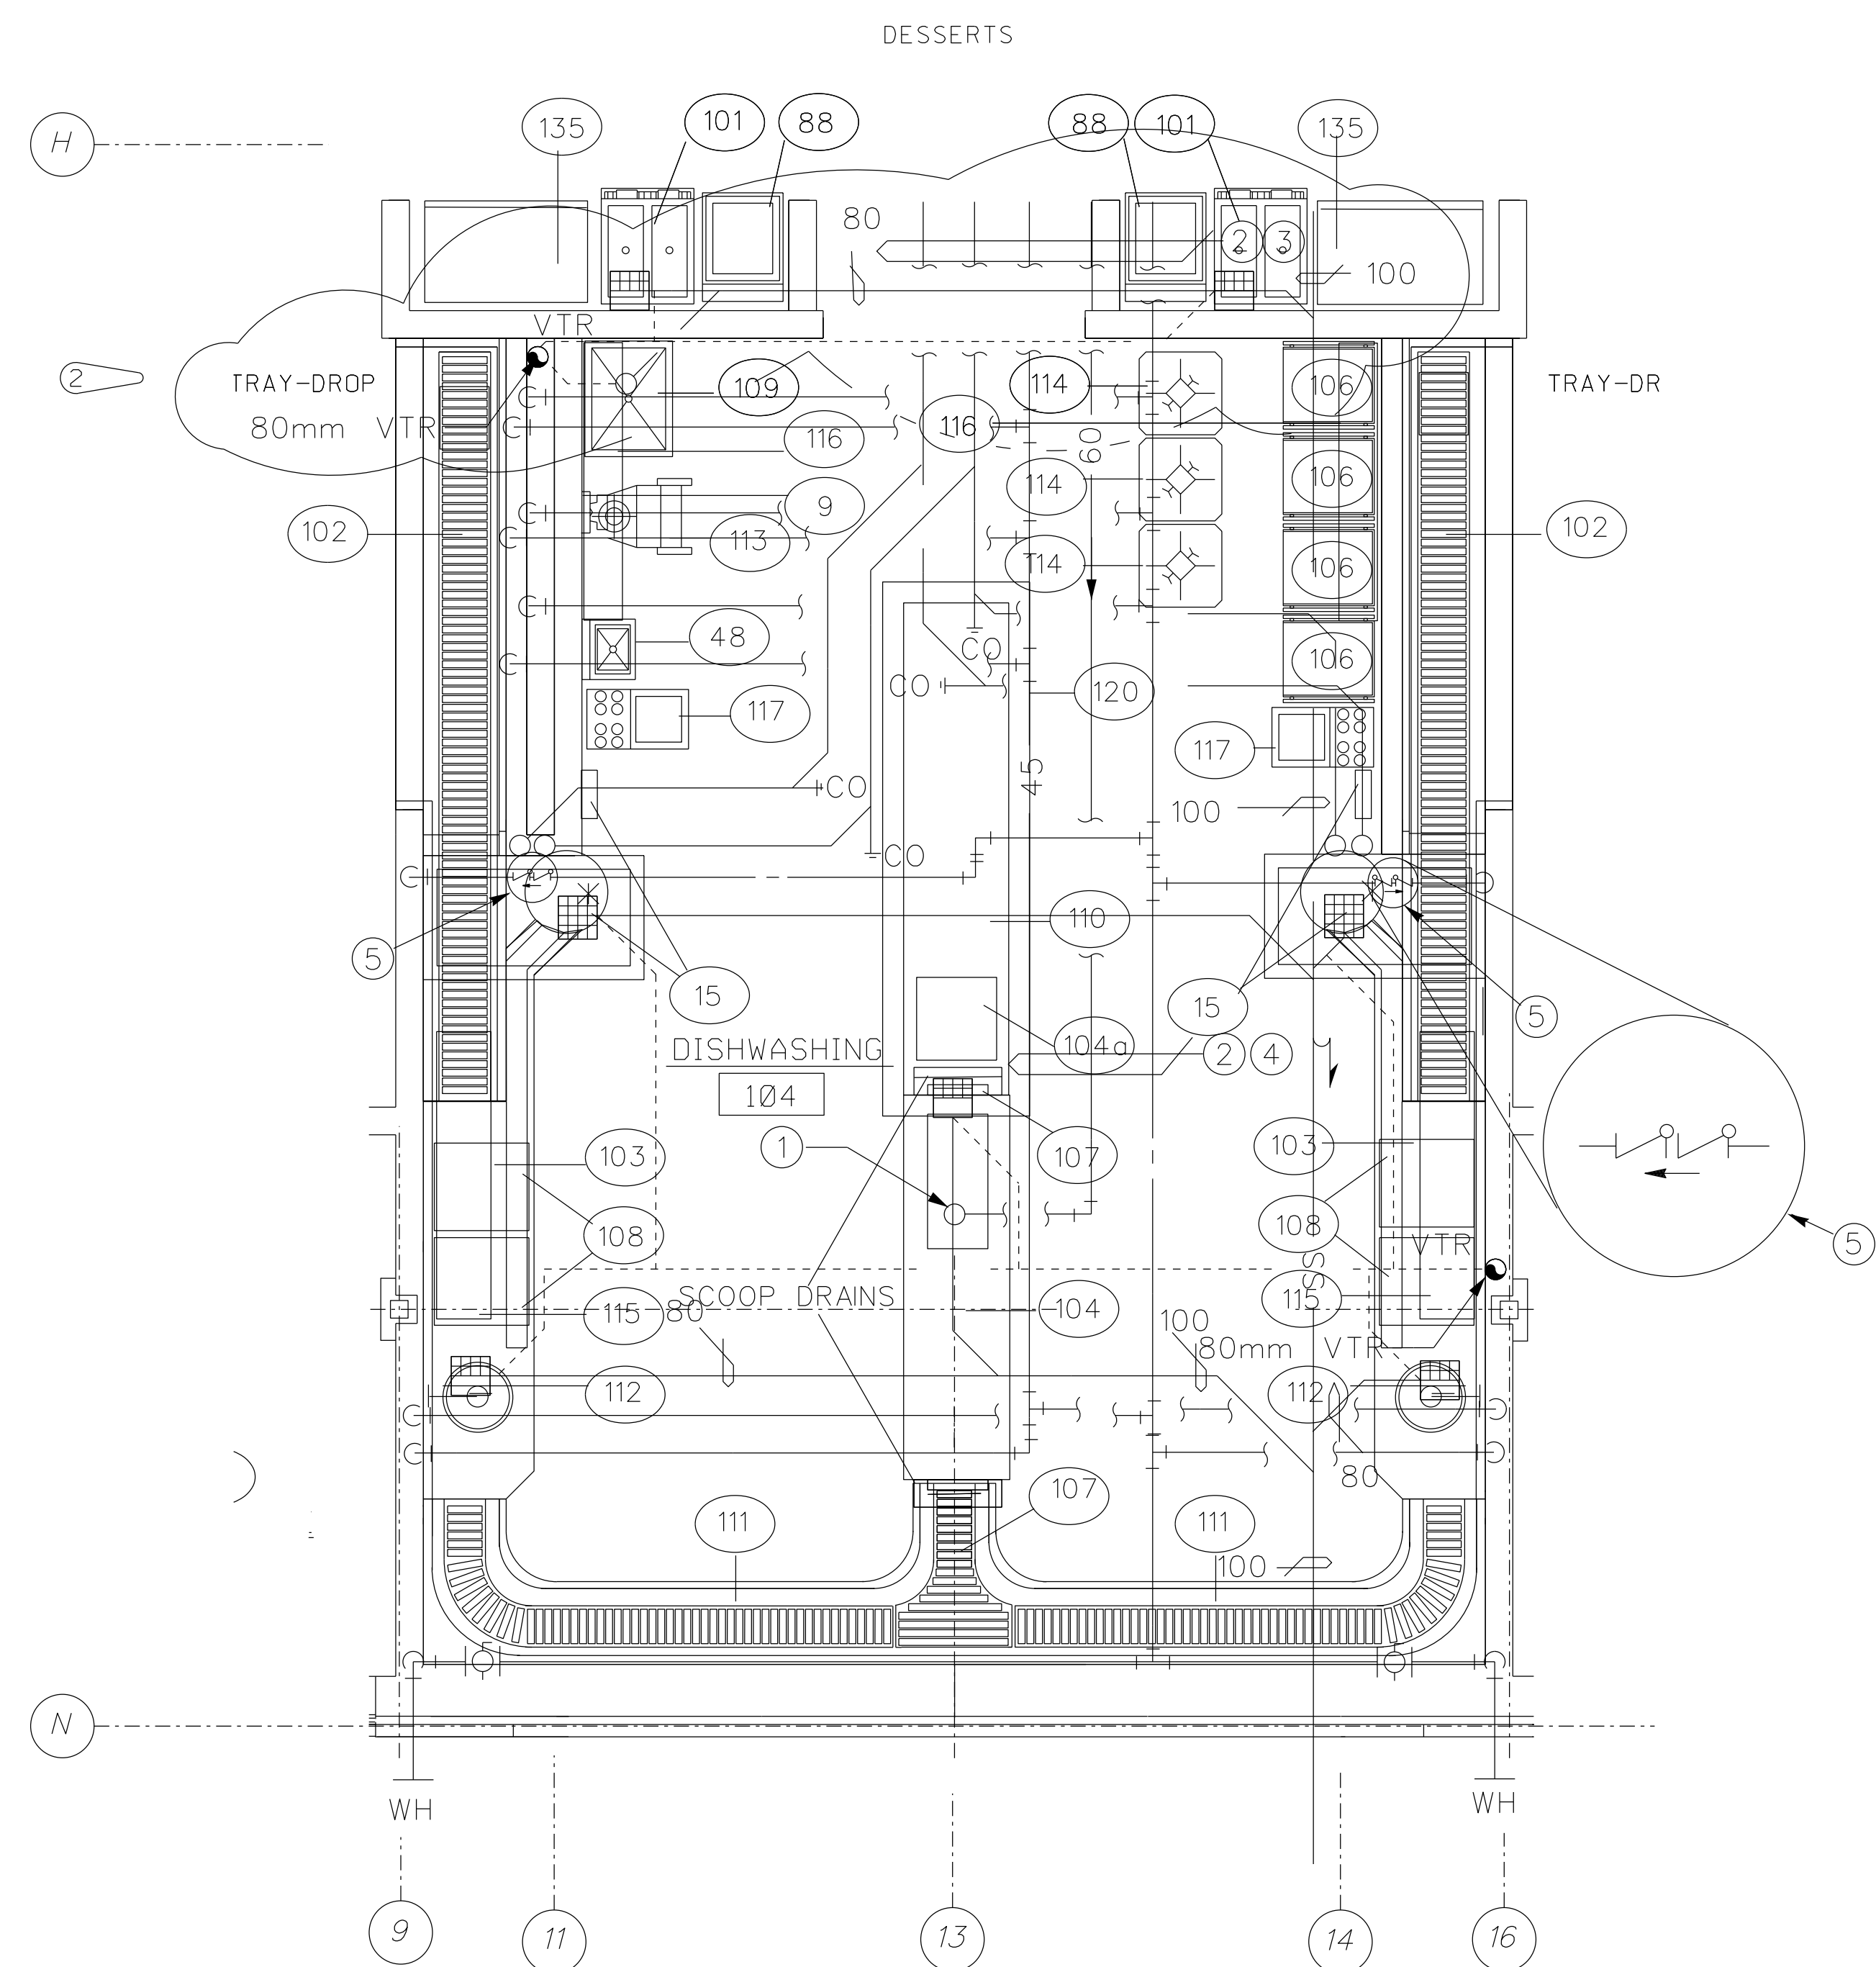


1 DISHWASHING AREA PLUMBING PLAN
MP2 MP6 SCALE: 1:50

GENERAL NOTES:

1. SEE GENERAL NOTES ON SHEET M-2
2. ALL FLOOR SINKS AND FLOOR DRAINS IN THE DISHWASHING AREA SHALL HAVE SCREWED CONNECTIONS OR GASKETING MATERIAL CAPABLE OF WITHSTANDING TEMPERATURES OF 120°C MINIMUM.

KEYED NOTES FOR DISHWASHING AREA PLUMBING:

- ① COORDINATE PIPE PENETRATION OF FLOOR WITH DISHWASHER MANUFACTURER REQUIREMENTS.
- ② PIPING IN CRAWL SPACE TO BE HUNG ON TRAPEZE HANGERS.
- ③ 80mm WPS: 80mm WPR: 32mm-45° C: 25mm-60° C: 40mm DCW.
- ④ 25mm-60° C: 25mm-45° C: 32mm DCW.
- ⑤ DOUBLE CHECK BACKFLOW ASSEMBLY.

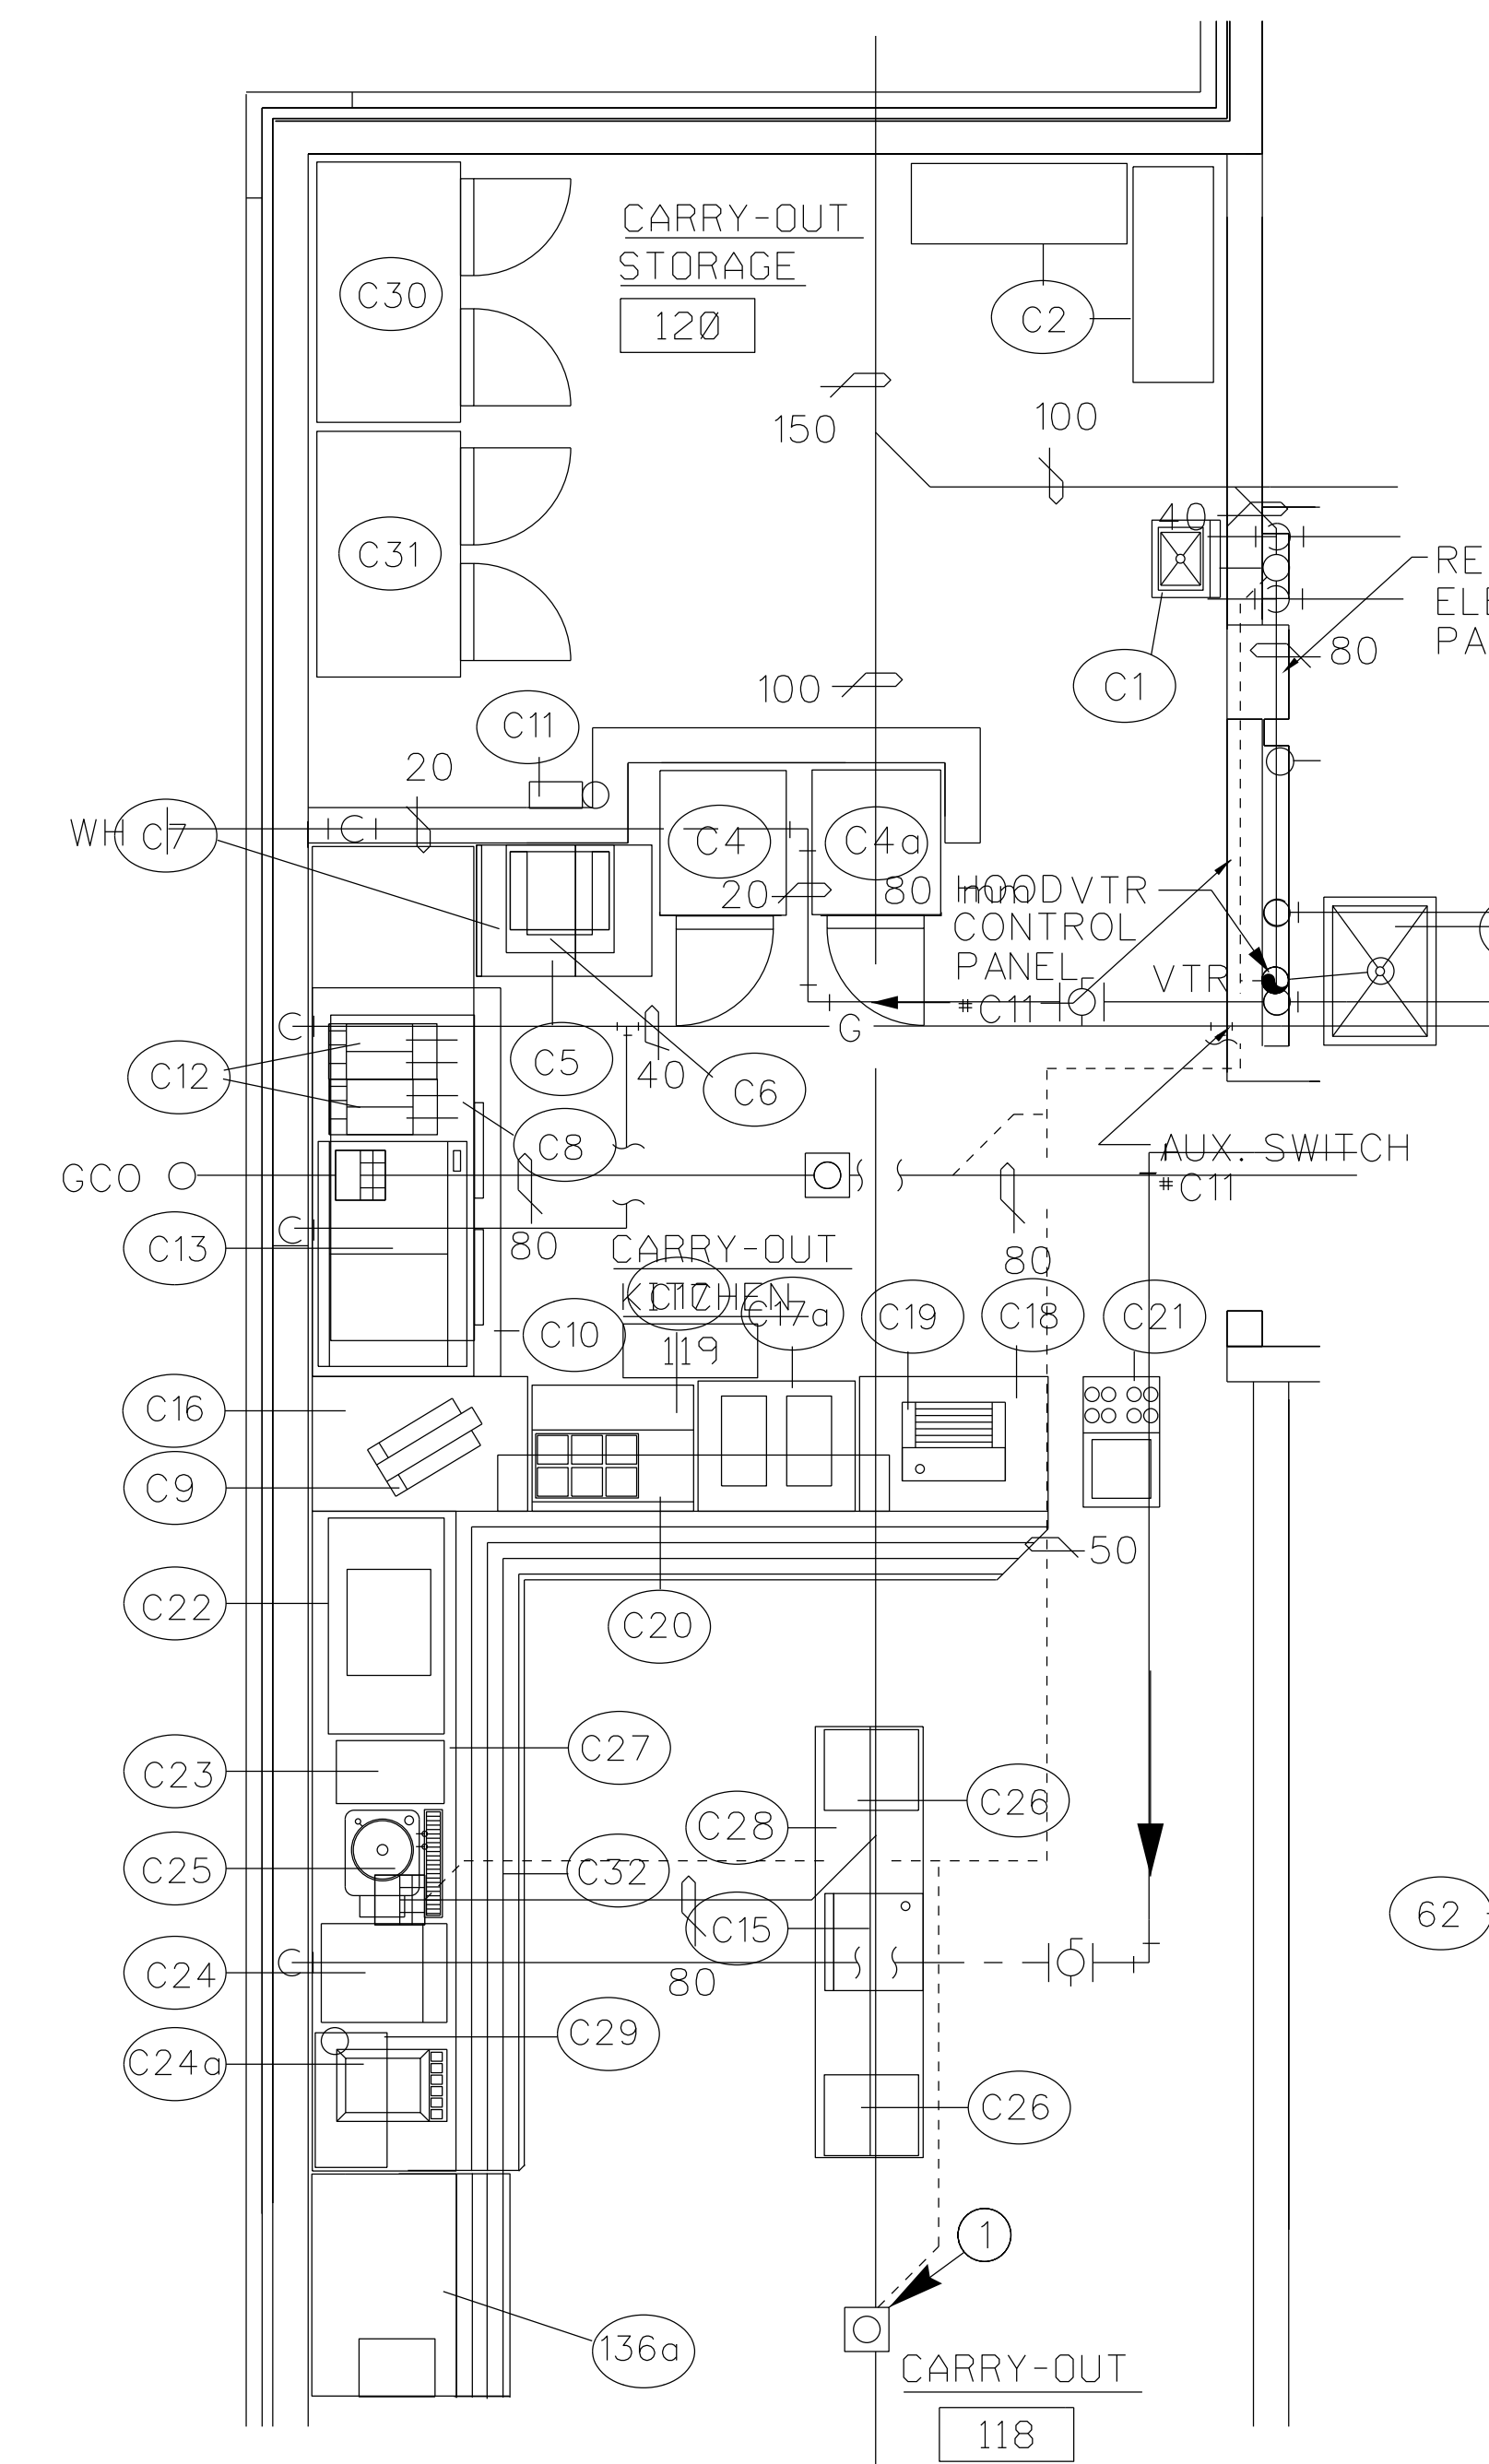


2 CARRY-OUT AREA PLUMBING PLAN
MP2MP6 SCALE: 1:50


GENERAL NOTES:

1. SEE GENERAL NOTES ON SHEET M-2
2. ALL FLOOR SINKS AND FLOOR DRAINS IN THE CARRY OUT AREA SHALL HAVE SCREWED CONNECTIONS OR GASKETING MATERIAL CAPABLE OF WITHSTANDING TEMPERATURES OF 120° C MINIMUM.

KEYED NOTES FOR CARRY OUT AREA PLUMBING:

- ① 80mm FLOOR DRAIN

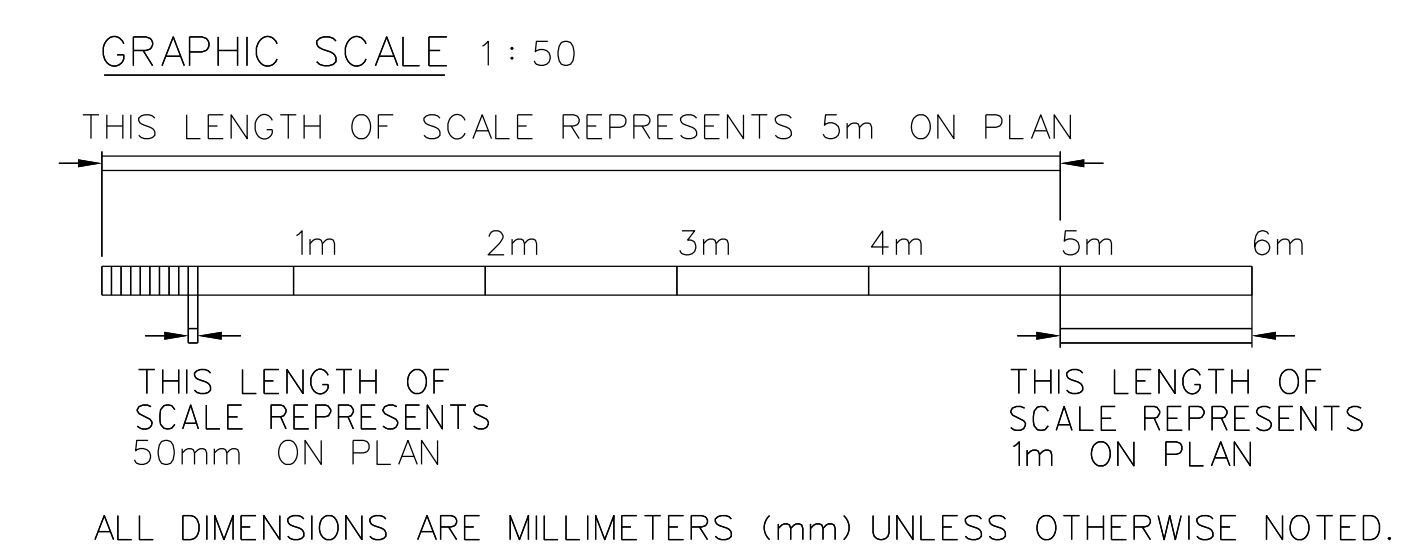


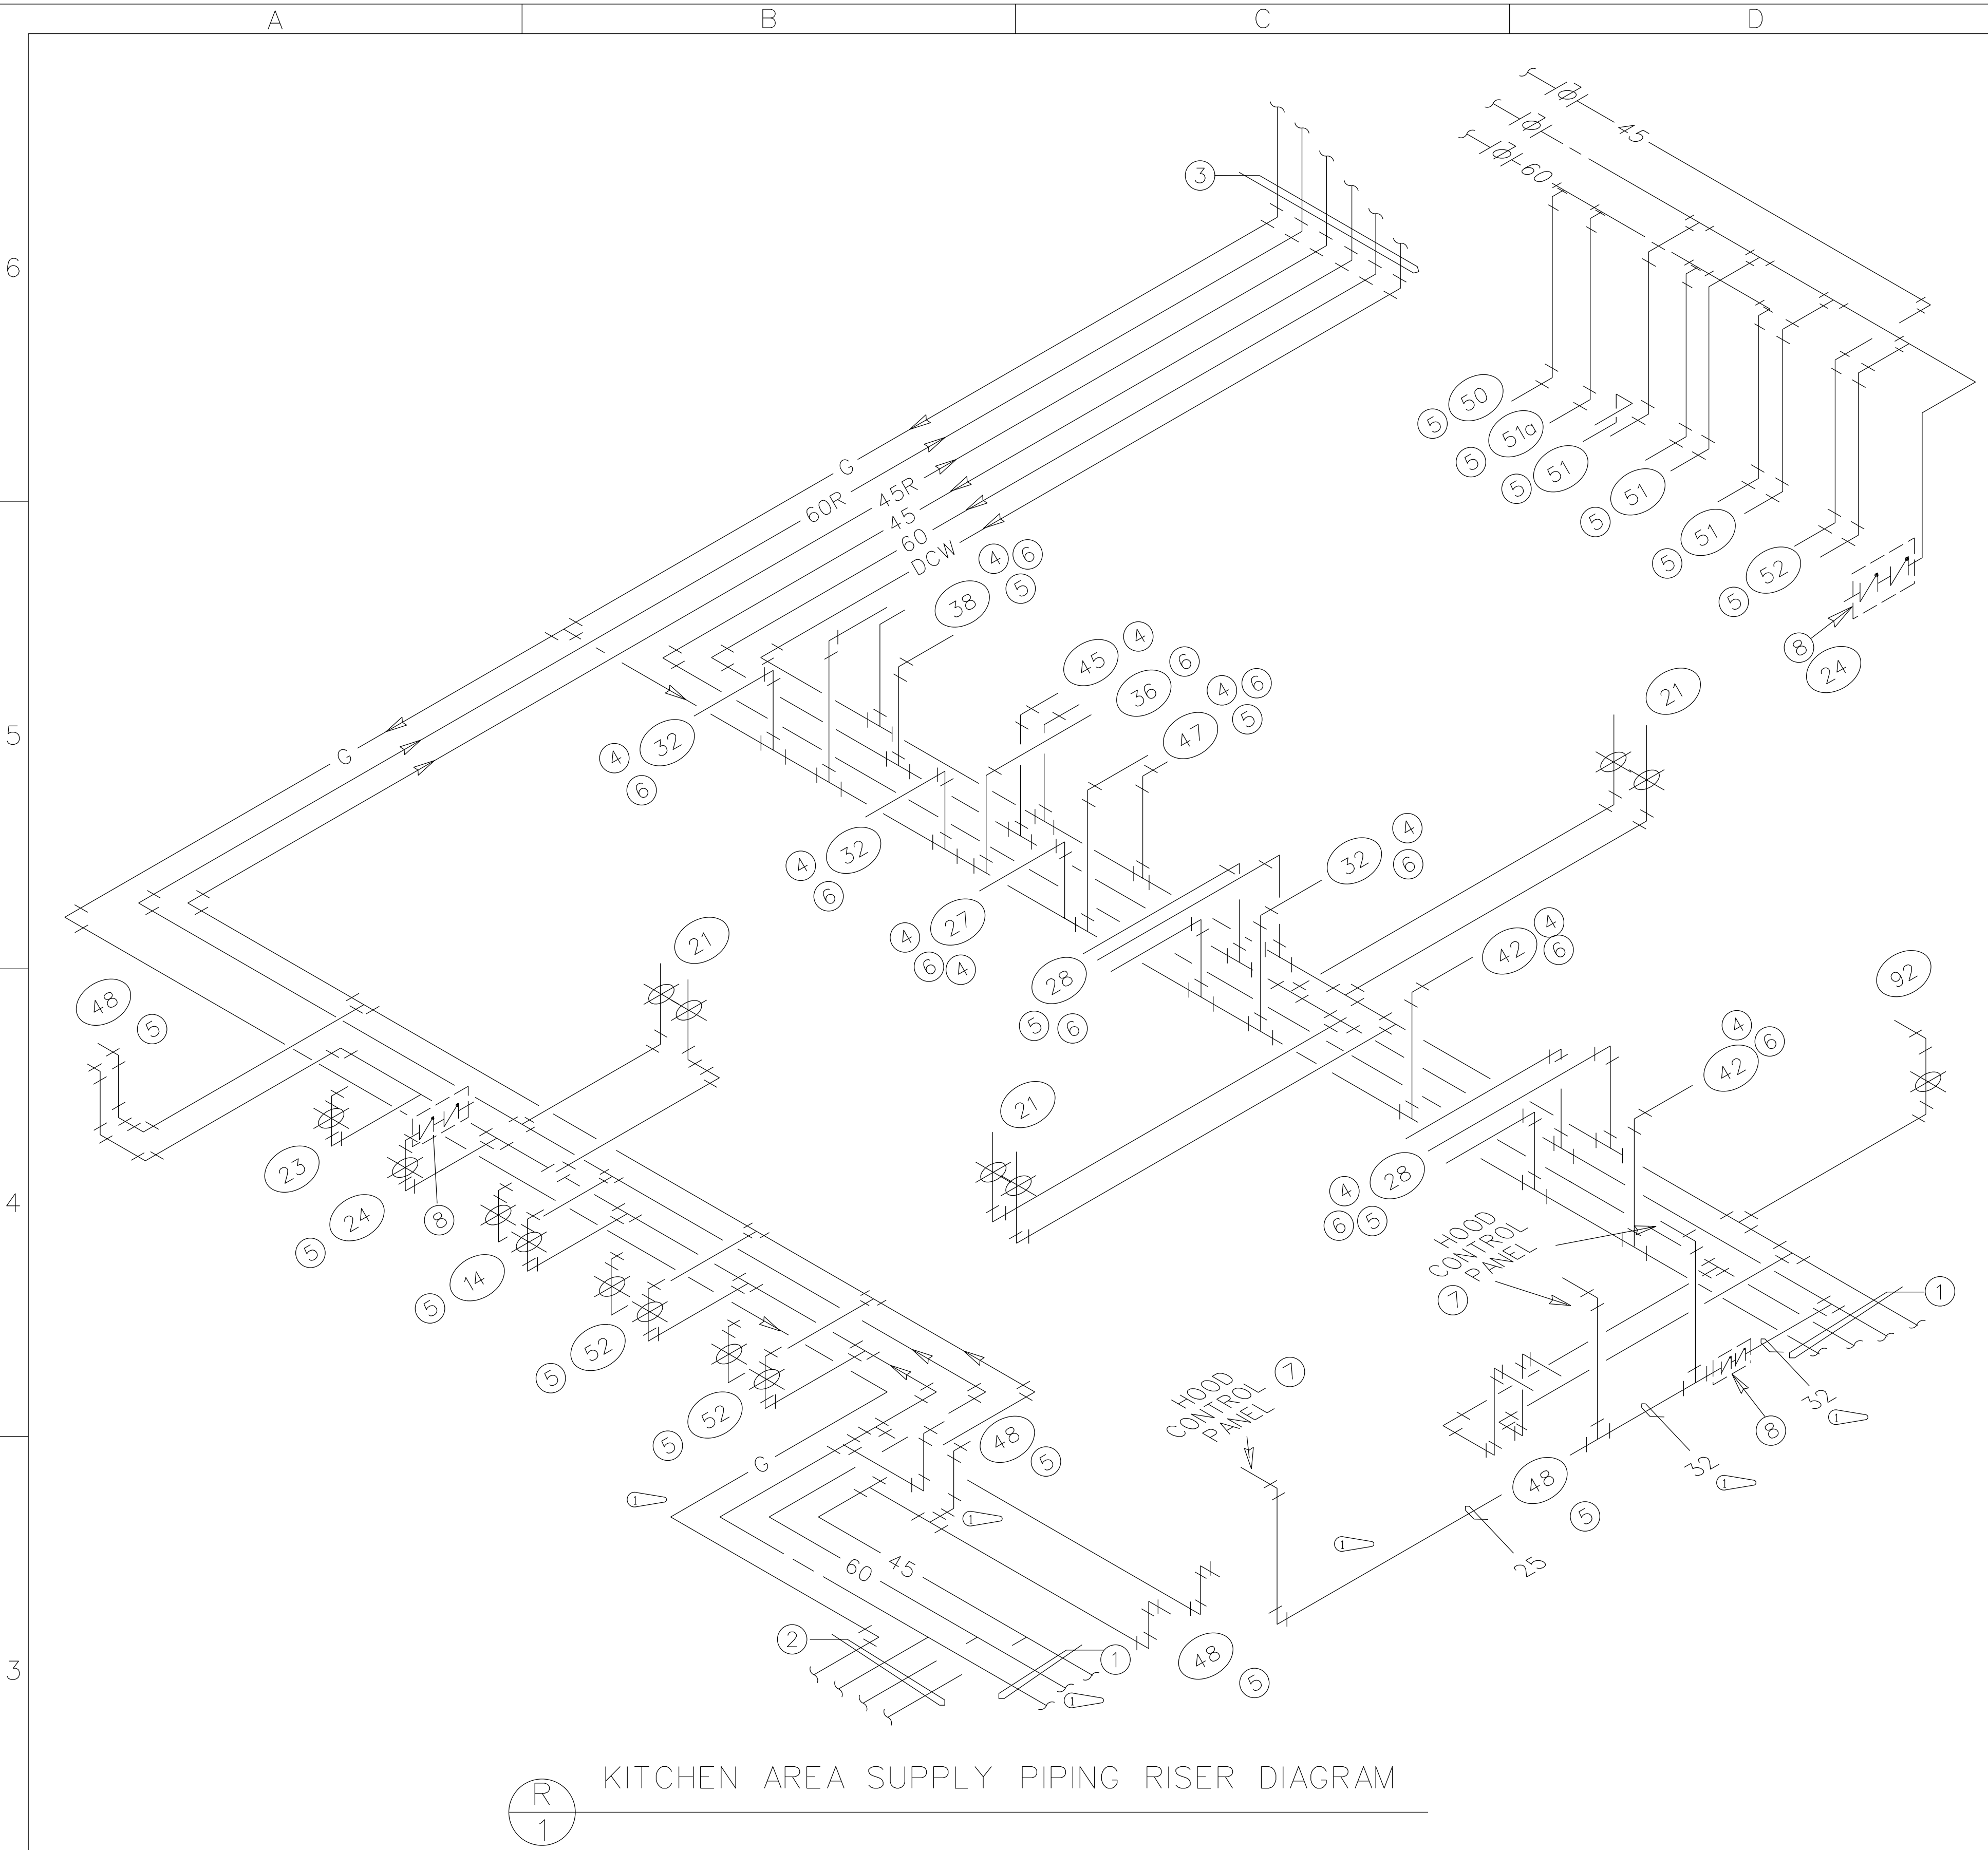

R 1 KITCHEN AREA SUPPLY PIPING RISER DIAGRAM

KEYED NOTES FOR KITCHEN SUPPLY RISER:

- ① PIPES CONTINUE TO SERVRY. SEE RISER R-3, SHEET MP-7A FOR CONTINUATION.
- ② SEE SHEET MP-2 FOR CONTINUATION.
- ③ PIPES CONTINUE UP CHASE TO MECHANICAL ROOM.
- ④ SEE DETAIL 3, SHEET MP-12 FOR GAS CONNECTION TO EQUIPMENT.
- ⑤ SEE DETAIL 5, SHEET MP-12 FOR WATER CONNECTIONS TO EQUIPMENT
- ⑥ PIPING TO EQUIPMENT RUNS IN CHASE.
- ⑦ 60°C WATER TO EXHAUST HOOD CONTROL PANEL. RUN WASHDOWN PIPING AS PER MANUFACTURER'S INSTRUCTIONS.
- ⑧ INSTALL A DOUBLE CHECK BACKFLOW ASSEMBLY.

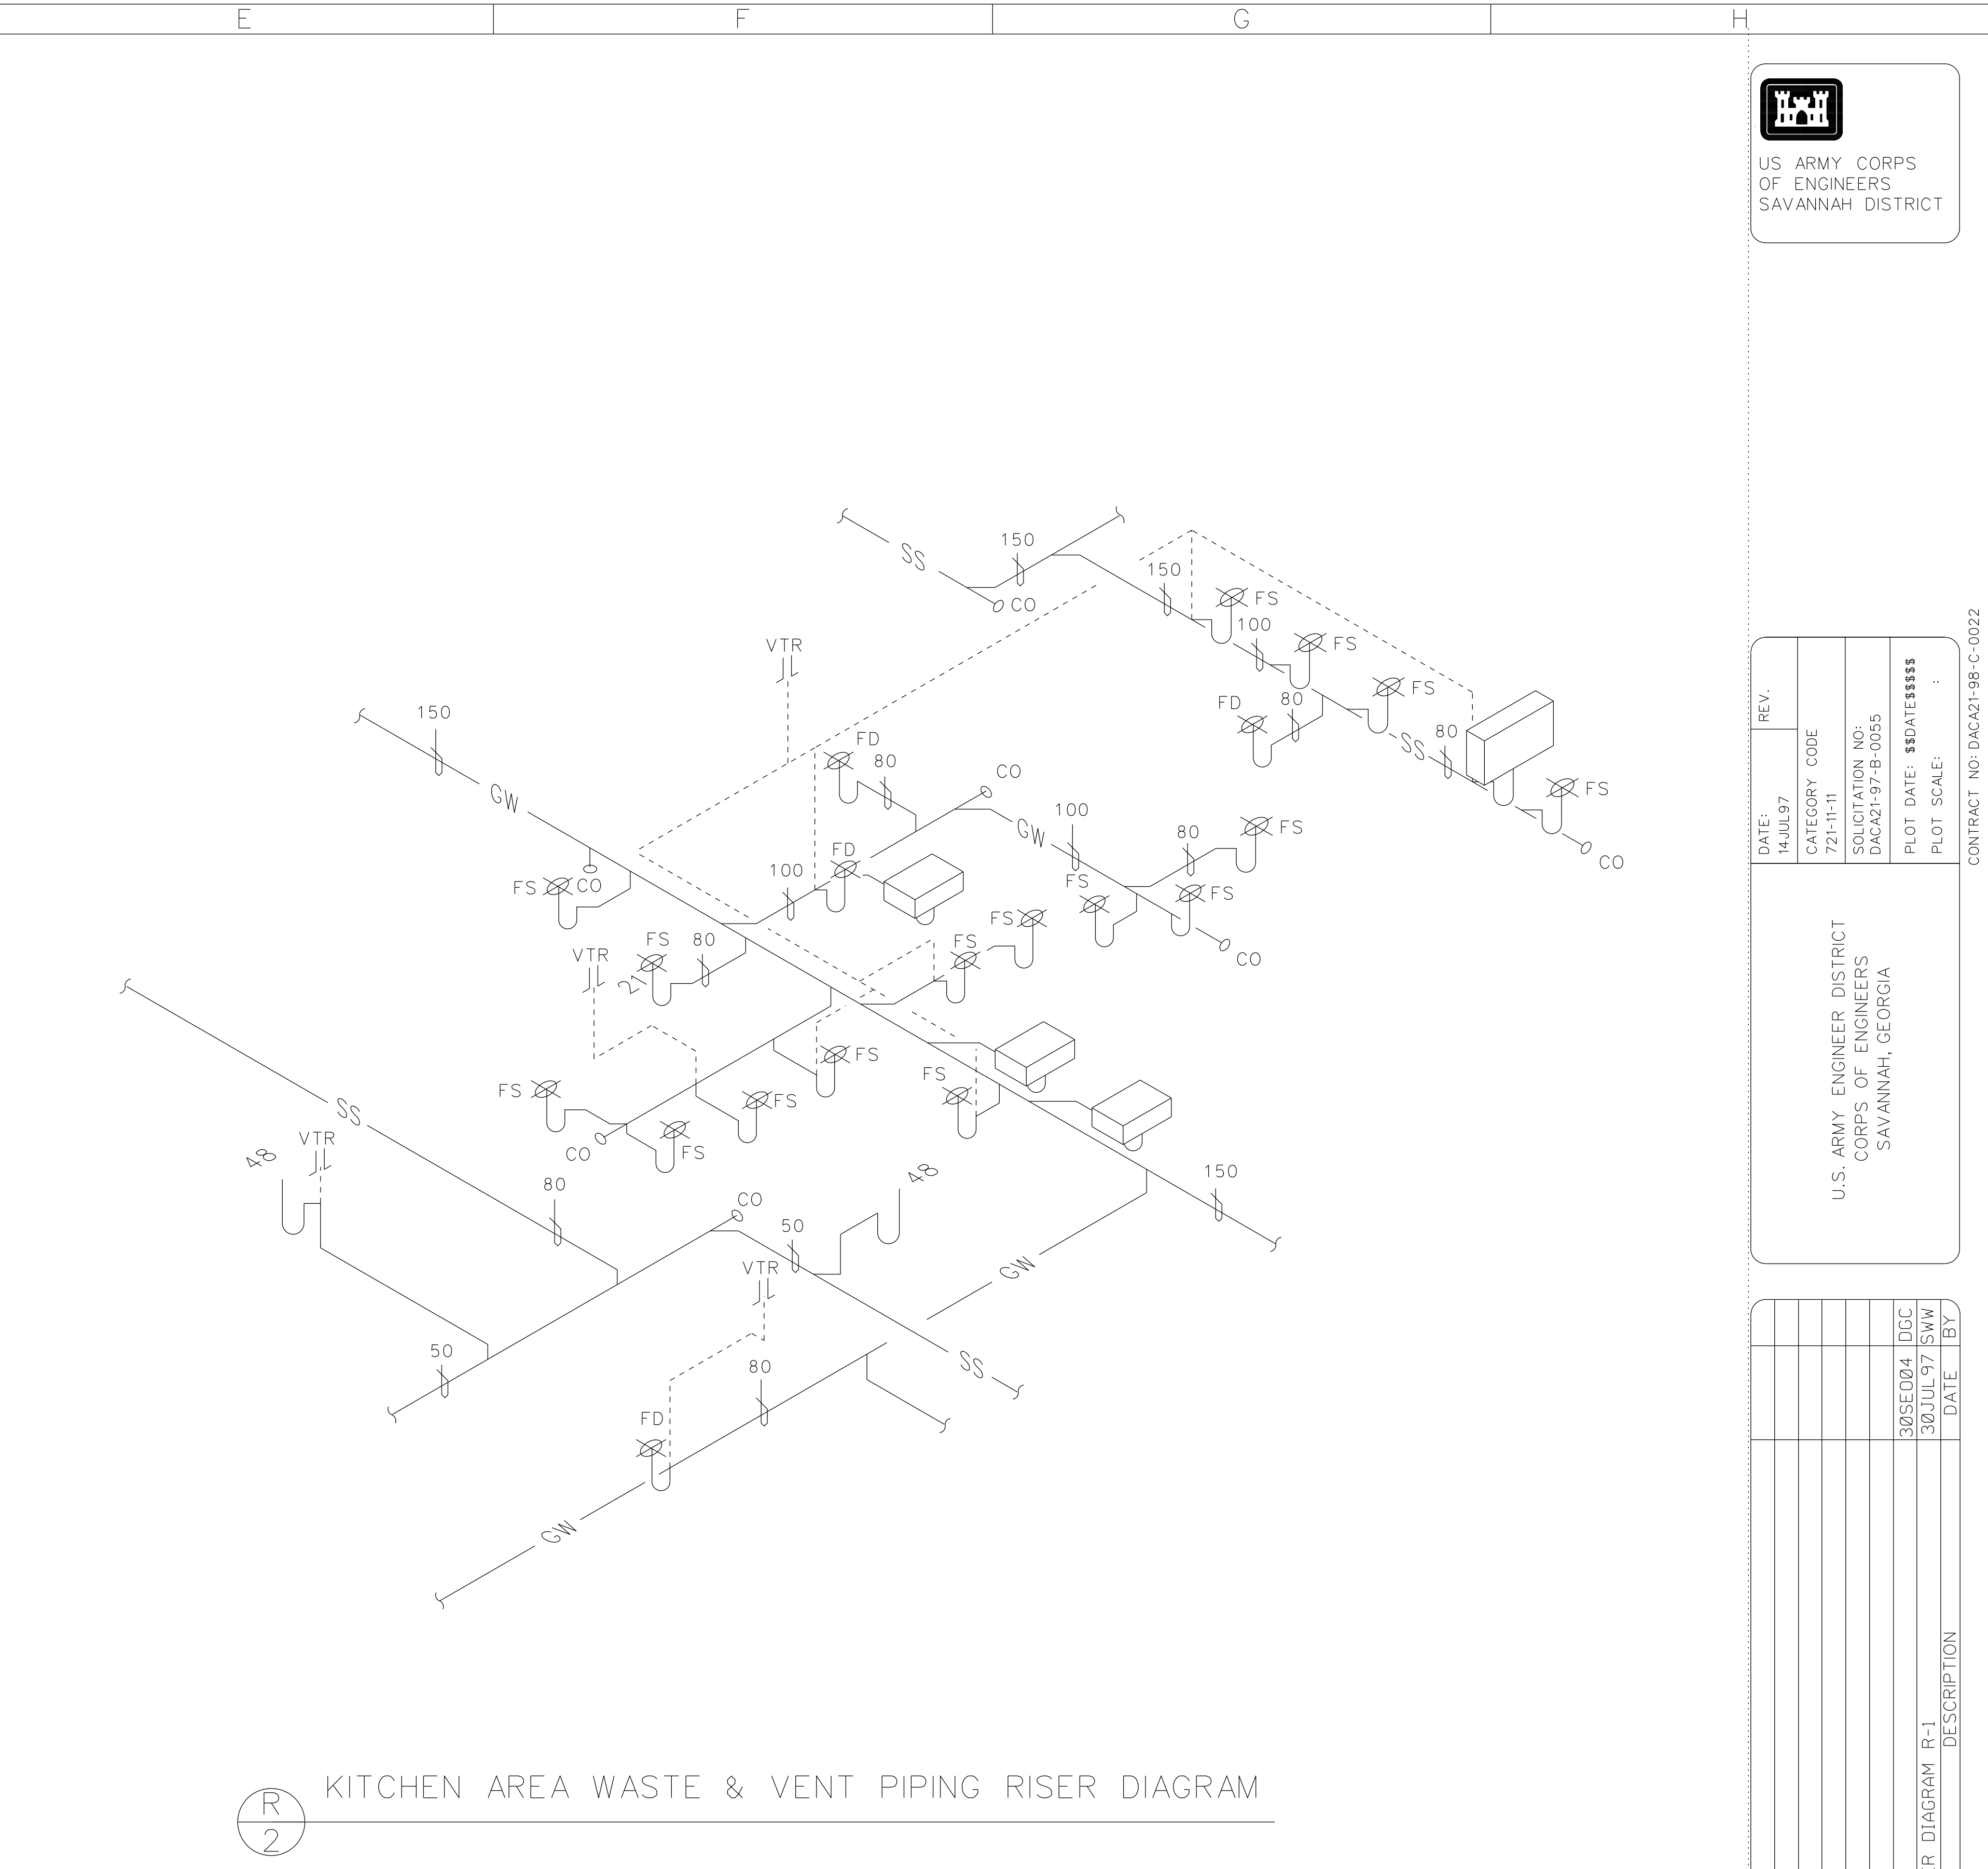

R 2 KITCHEN AREA WASTE & VENT PIPING RISER DIAGRAM



US ARMY CORPS
OF ENGINEERS
SAVANNAH DISTRICT

DATE: 14 JUL 97	REV.	CATEGORY CODE 721-1-11
SOLICITATION NO: DACA21-97-B-0055		
PLOT DATE: 150 DATE: 150		
PLOT SCALE:		

CONTRACT NO: DACA21-98-C-0022

U.S. ARMY ENGINEER DISTRICT CORPS OF ENGINEERS SAVANNAH, GEORGIA
--


AS BUILT REVISE RISER DIAGRAM R-1	DATE 30 JUL 97	BY SWW
DESCRIPTION		

RANGER BARRACKS COMPLEX FORT BENNING, GEORGIA	DINING FACILITY
PLUMBING RISER DIAGRAMS	

PLATE
REFERENCE
NUMBER:
MP-7
SHEET 351

RECORD DRAWING

DO NOT SCALE
SYTIME 11/11/97

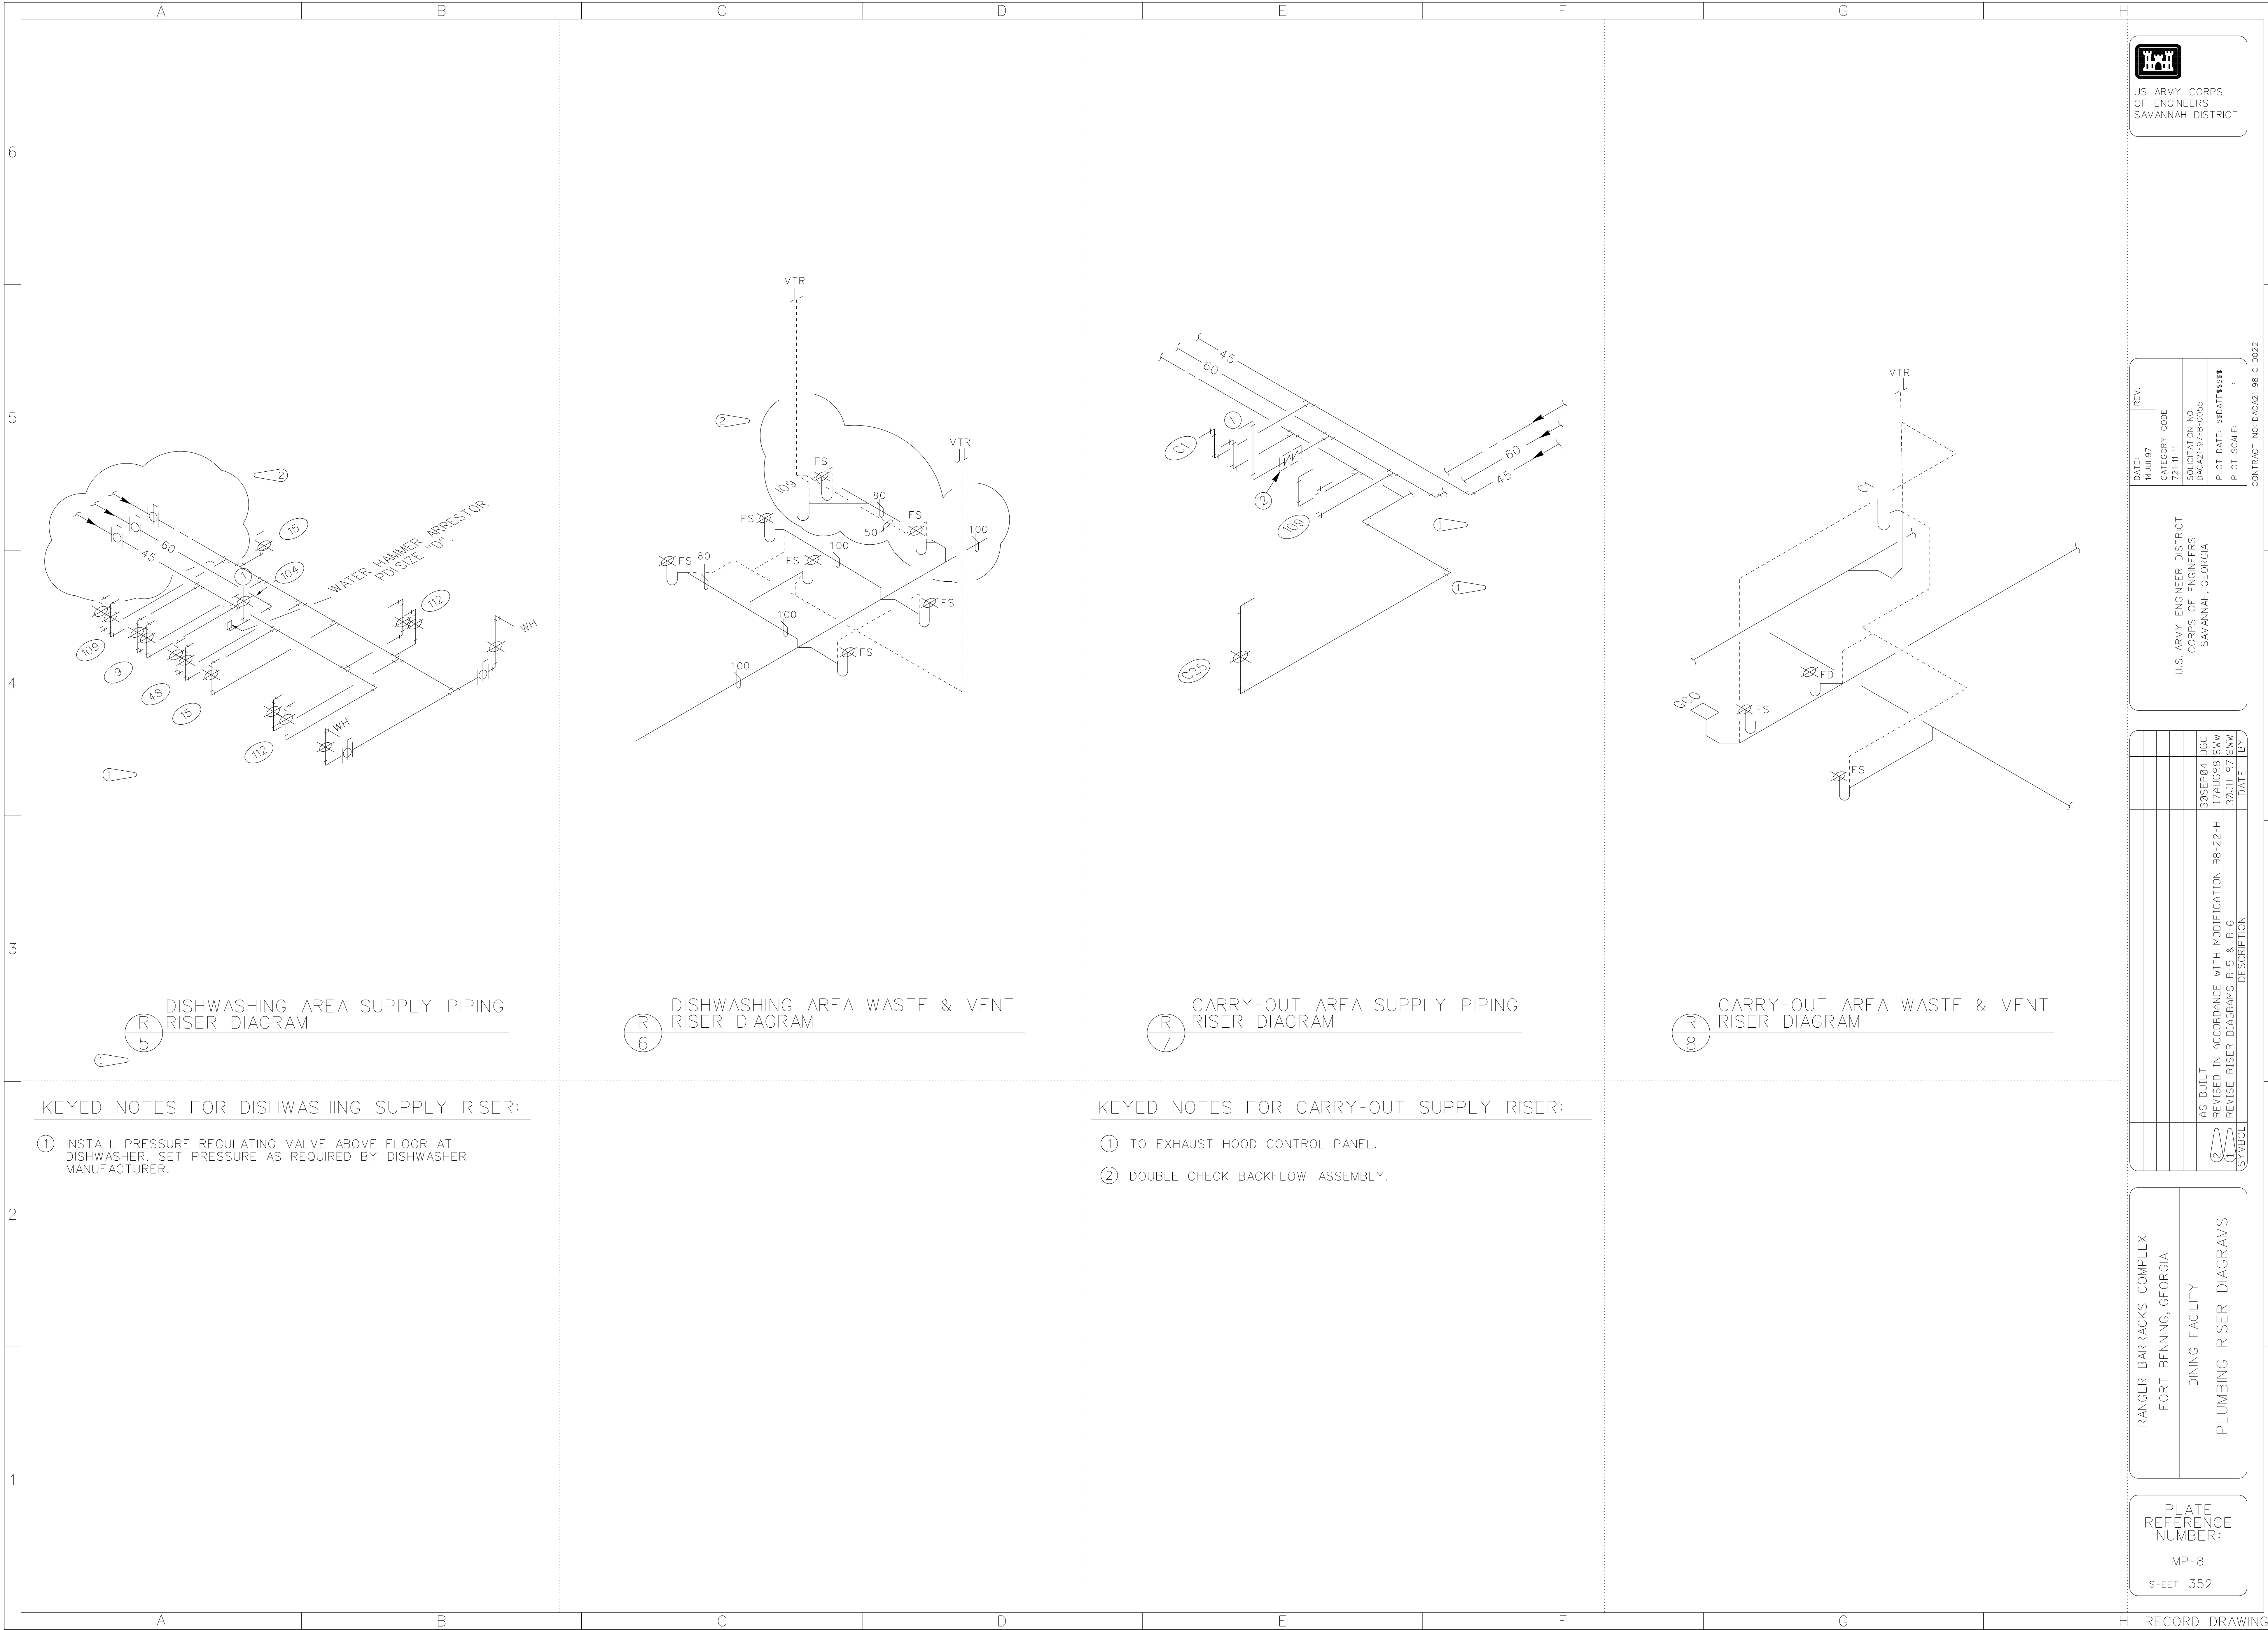

US ARMY CORPS
OF ENGINEERS
SAVANNAH DISTRICT

DATE: 14 JUL 97	REV.
CATEGORY CODE 721-11-11	
SOLICITATION NO: DAC21-97-B-0055	
PLOT DATE: 150 DATE 11/11/97	
PLOT SCALE: 1"	

CONTRACT NO: DAC21-98-C-0022

U.S. ARMY ENGINEER DISTRICT
CORPS OF ENGINEERS
SAVANNAH, GEORGIA

NO.	DESCRIPTION	DATE	BY
1	AS BUILT	30 SEP 04	DGC
2	REVISED IN ACCORDANCE WITH MODIFICATION 98-22-H	17 AUG 98	SWW
3	REVISE RISER DIAGRAMS R-5 & R-6	30 JUL 97	SWW

RANGER BARRACKS COMPLEX
FORT BENNING, GEORGIA

DINING FACILITY


PLUMBING RISER DIAGRAMS

PLATE
REFERENCE
NUMBER:

MP-8

SHEET 352

RECORD DRAWING

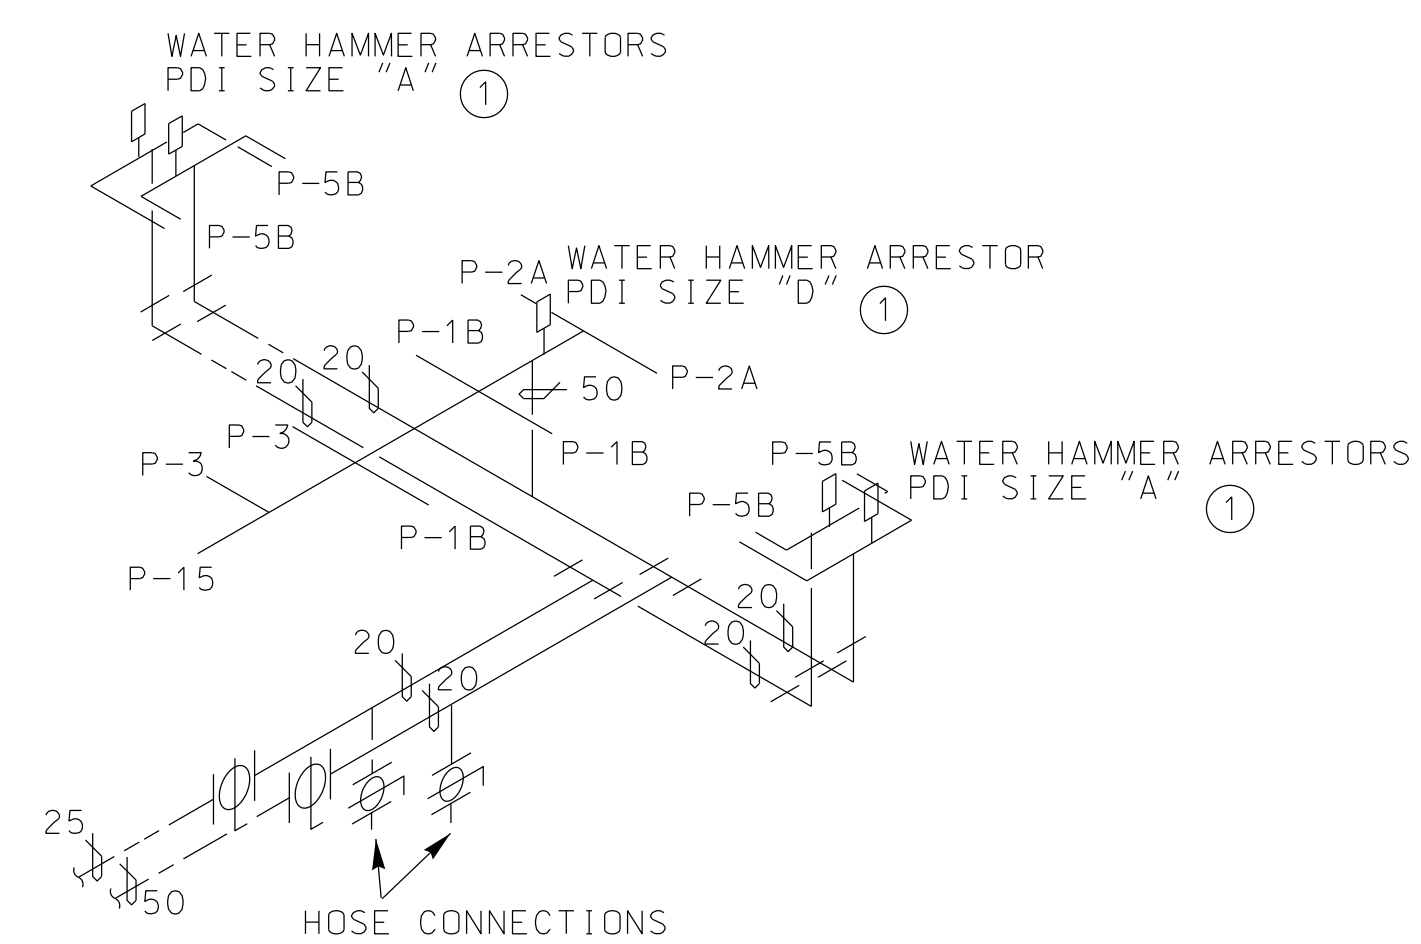


KEYED NOTE:

① INCLUDE ACCESS PANEL.
COLOR TO MATCH ADJACENT MATERIAL.
ACCESS PANELS BEHIND SINKS ARE TO BE
INSTALLED UNDER THE COUNTER.


RM 115 & 116 TOILET
SUPPLY PIPING RISER

NOT TO SCALE

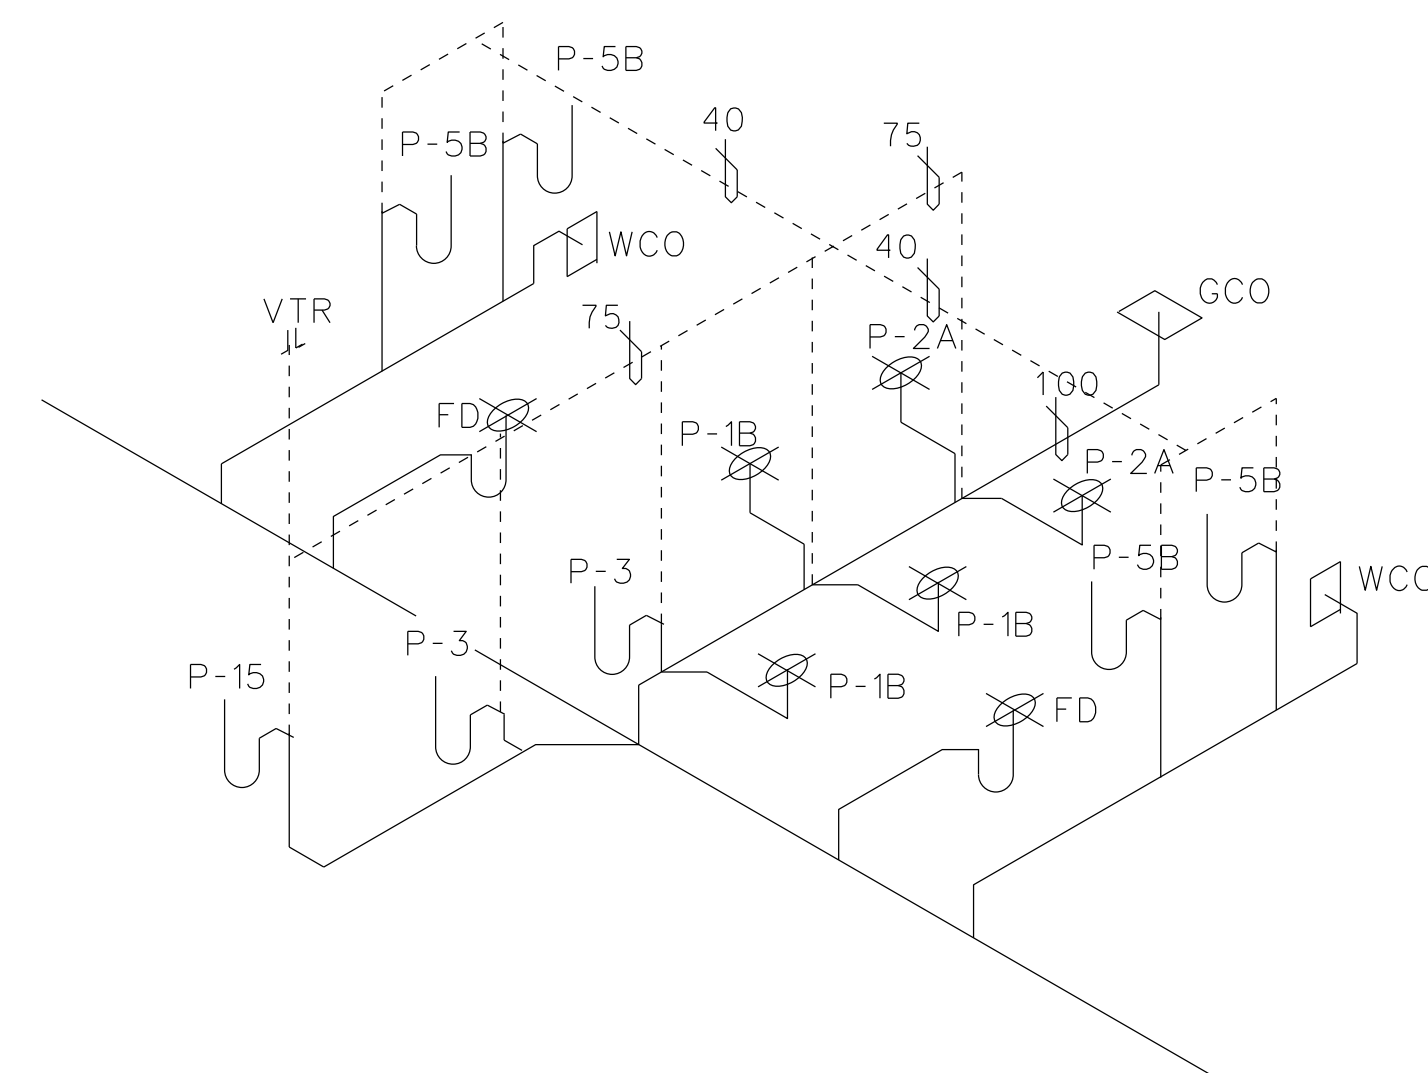

RM 115 & 116 TOILET
WASTE & VENT RISER

NOT TO SCALE

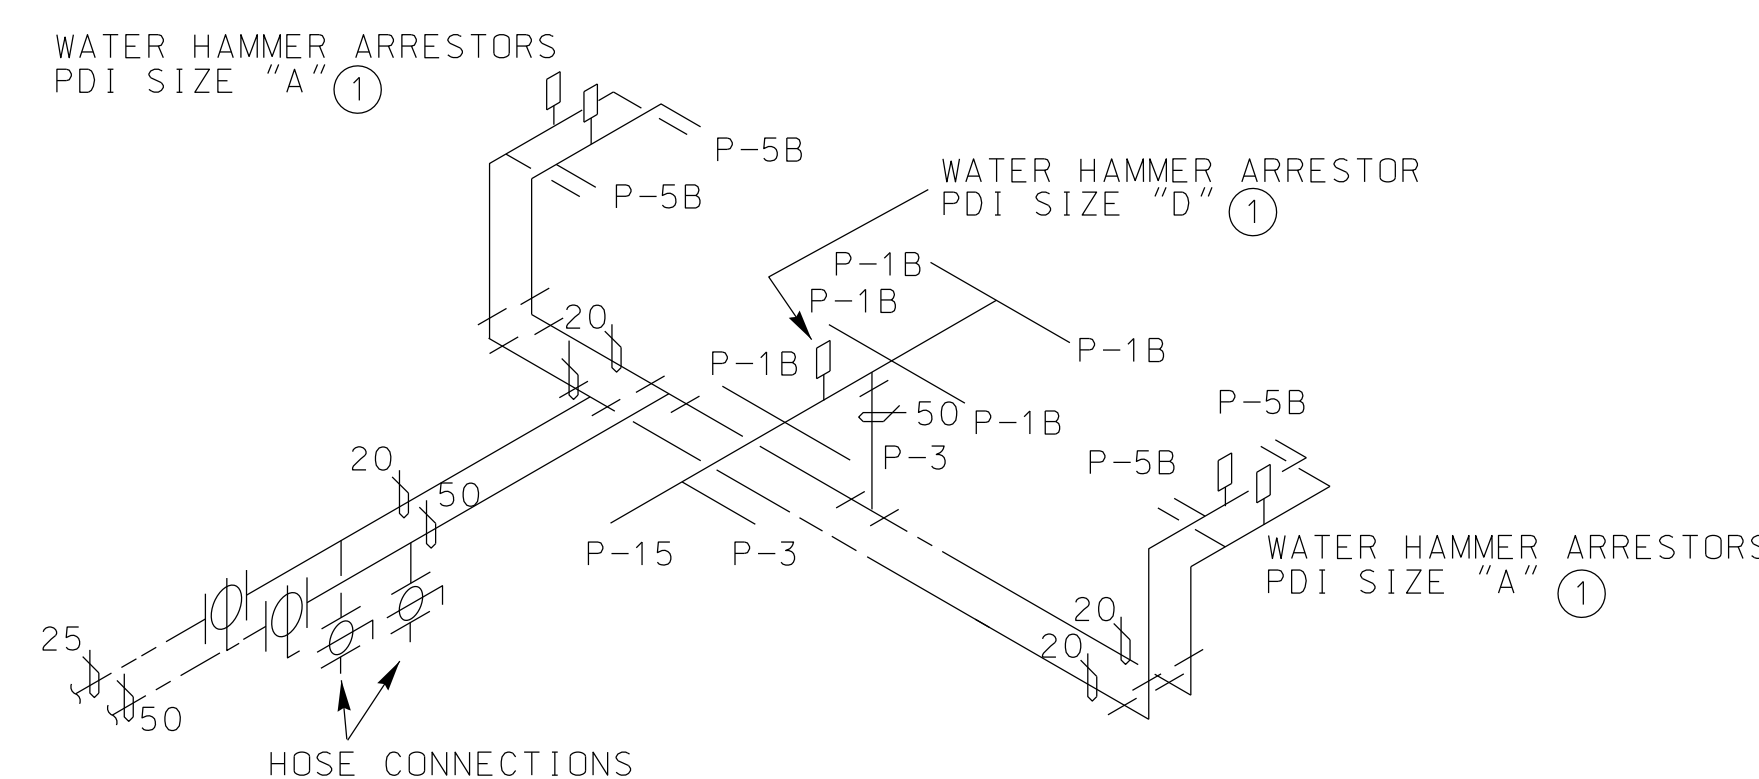


NOTE :

① INCLUDE ACCESS PANEL.
COLOR TO MATCH ADJACENT MATERIAL.
ACCESS PANELS BEHIND SINKS ARE TO BE
INSTALLED UNDER THE COUNTER.


RM 148 & 149 TOILET
SUPPLY PIPING RISER

NOT TO SCALE

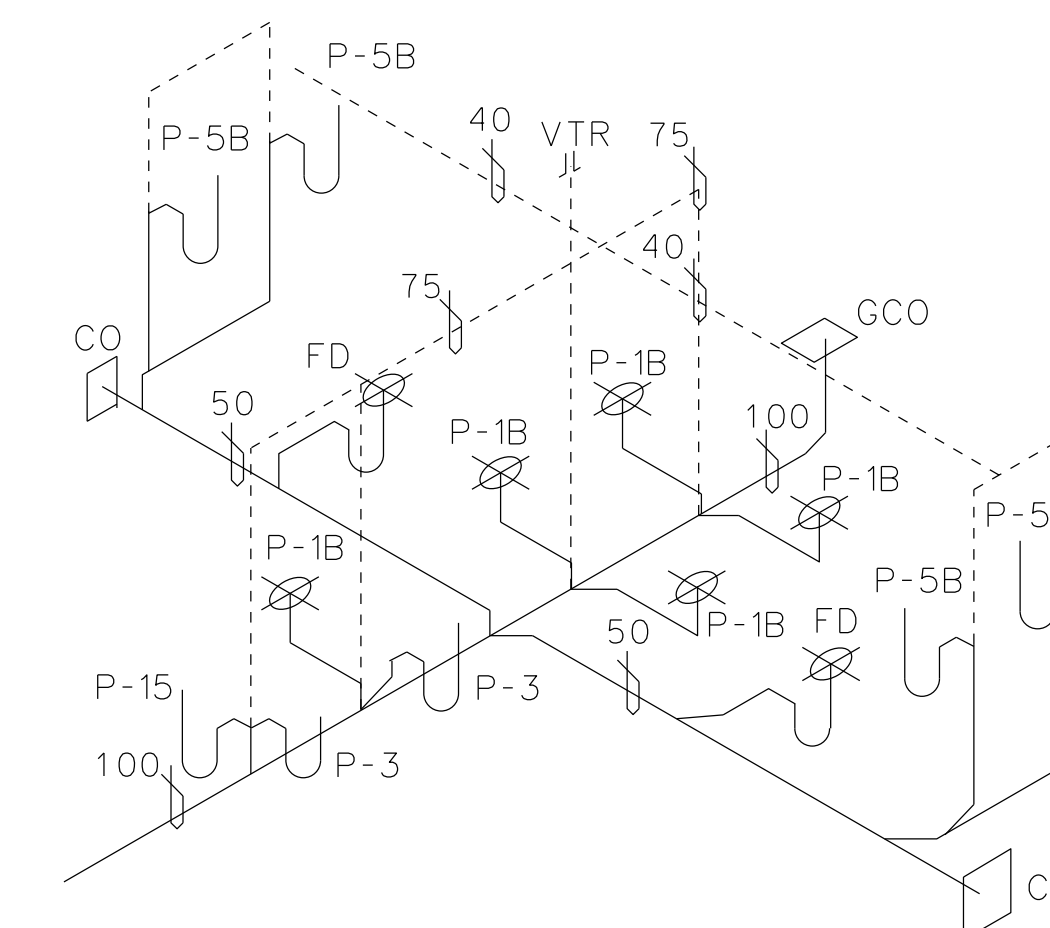

RM 148 & 149 TOILET
WASTE & VENT RISER

NOT TO SCALE

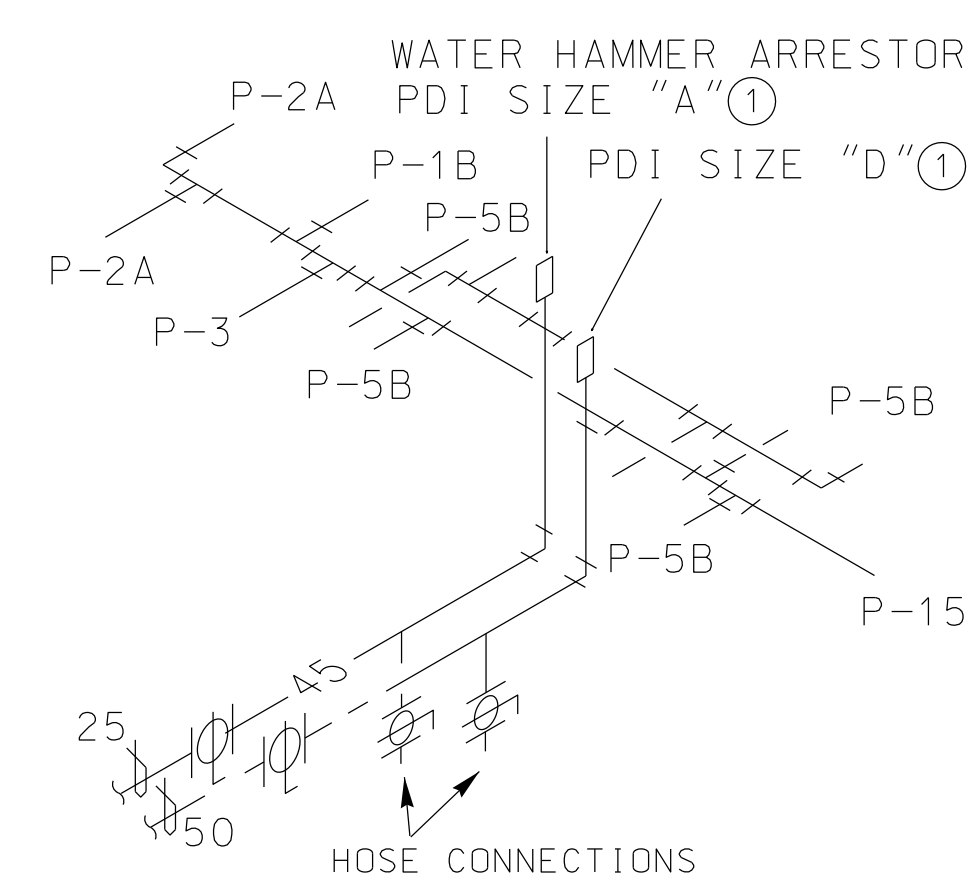


NOTE:

① INCLUDE ACCESS PANEL.
COLOR TO MATCH ADJACENT MATERIAL.
ACCESS PANELS BEHIND SINKS ARE TO BE
INSTALLED UNDER THE COUNTER.


RM 127 & 128 TOILET
SUPPLY PIPING RISER

NOT TO SCALE

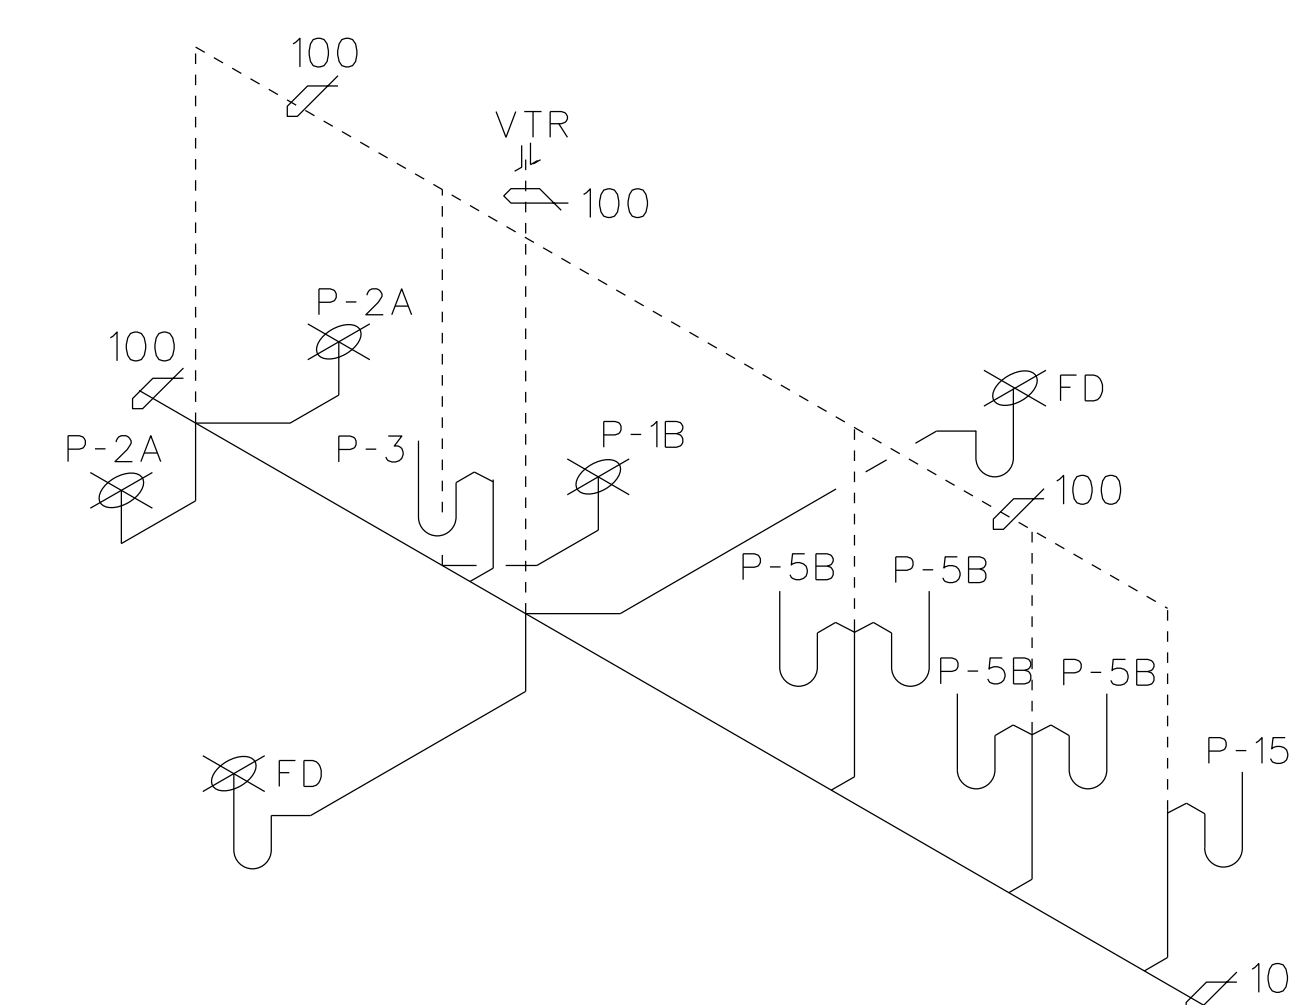

RM 127 & 128 TOILET
WASTE & VENT RISER

NOT TO SCALE

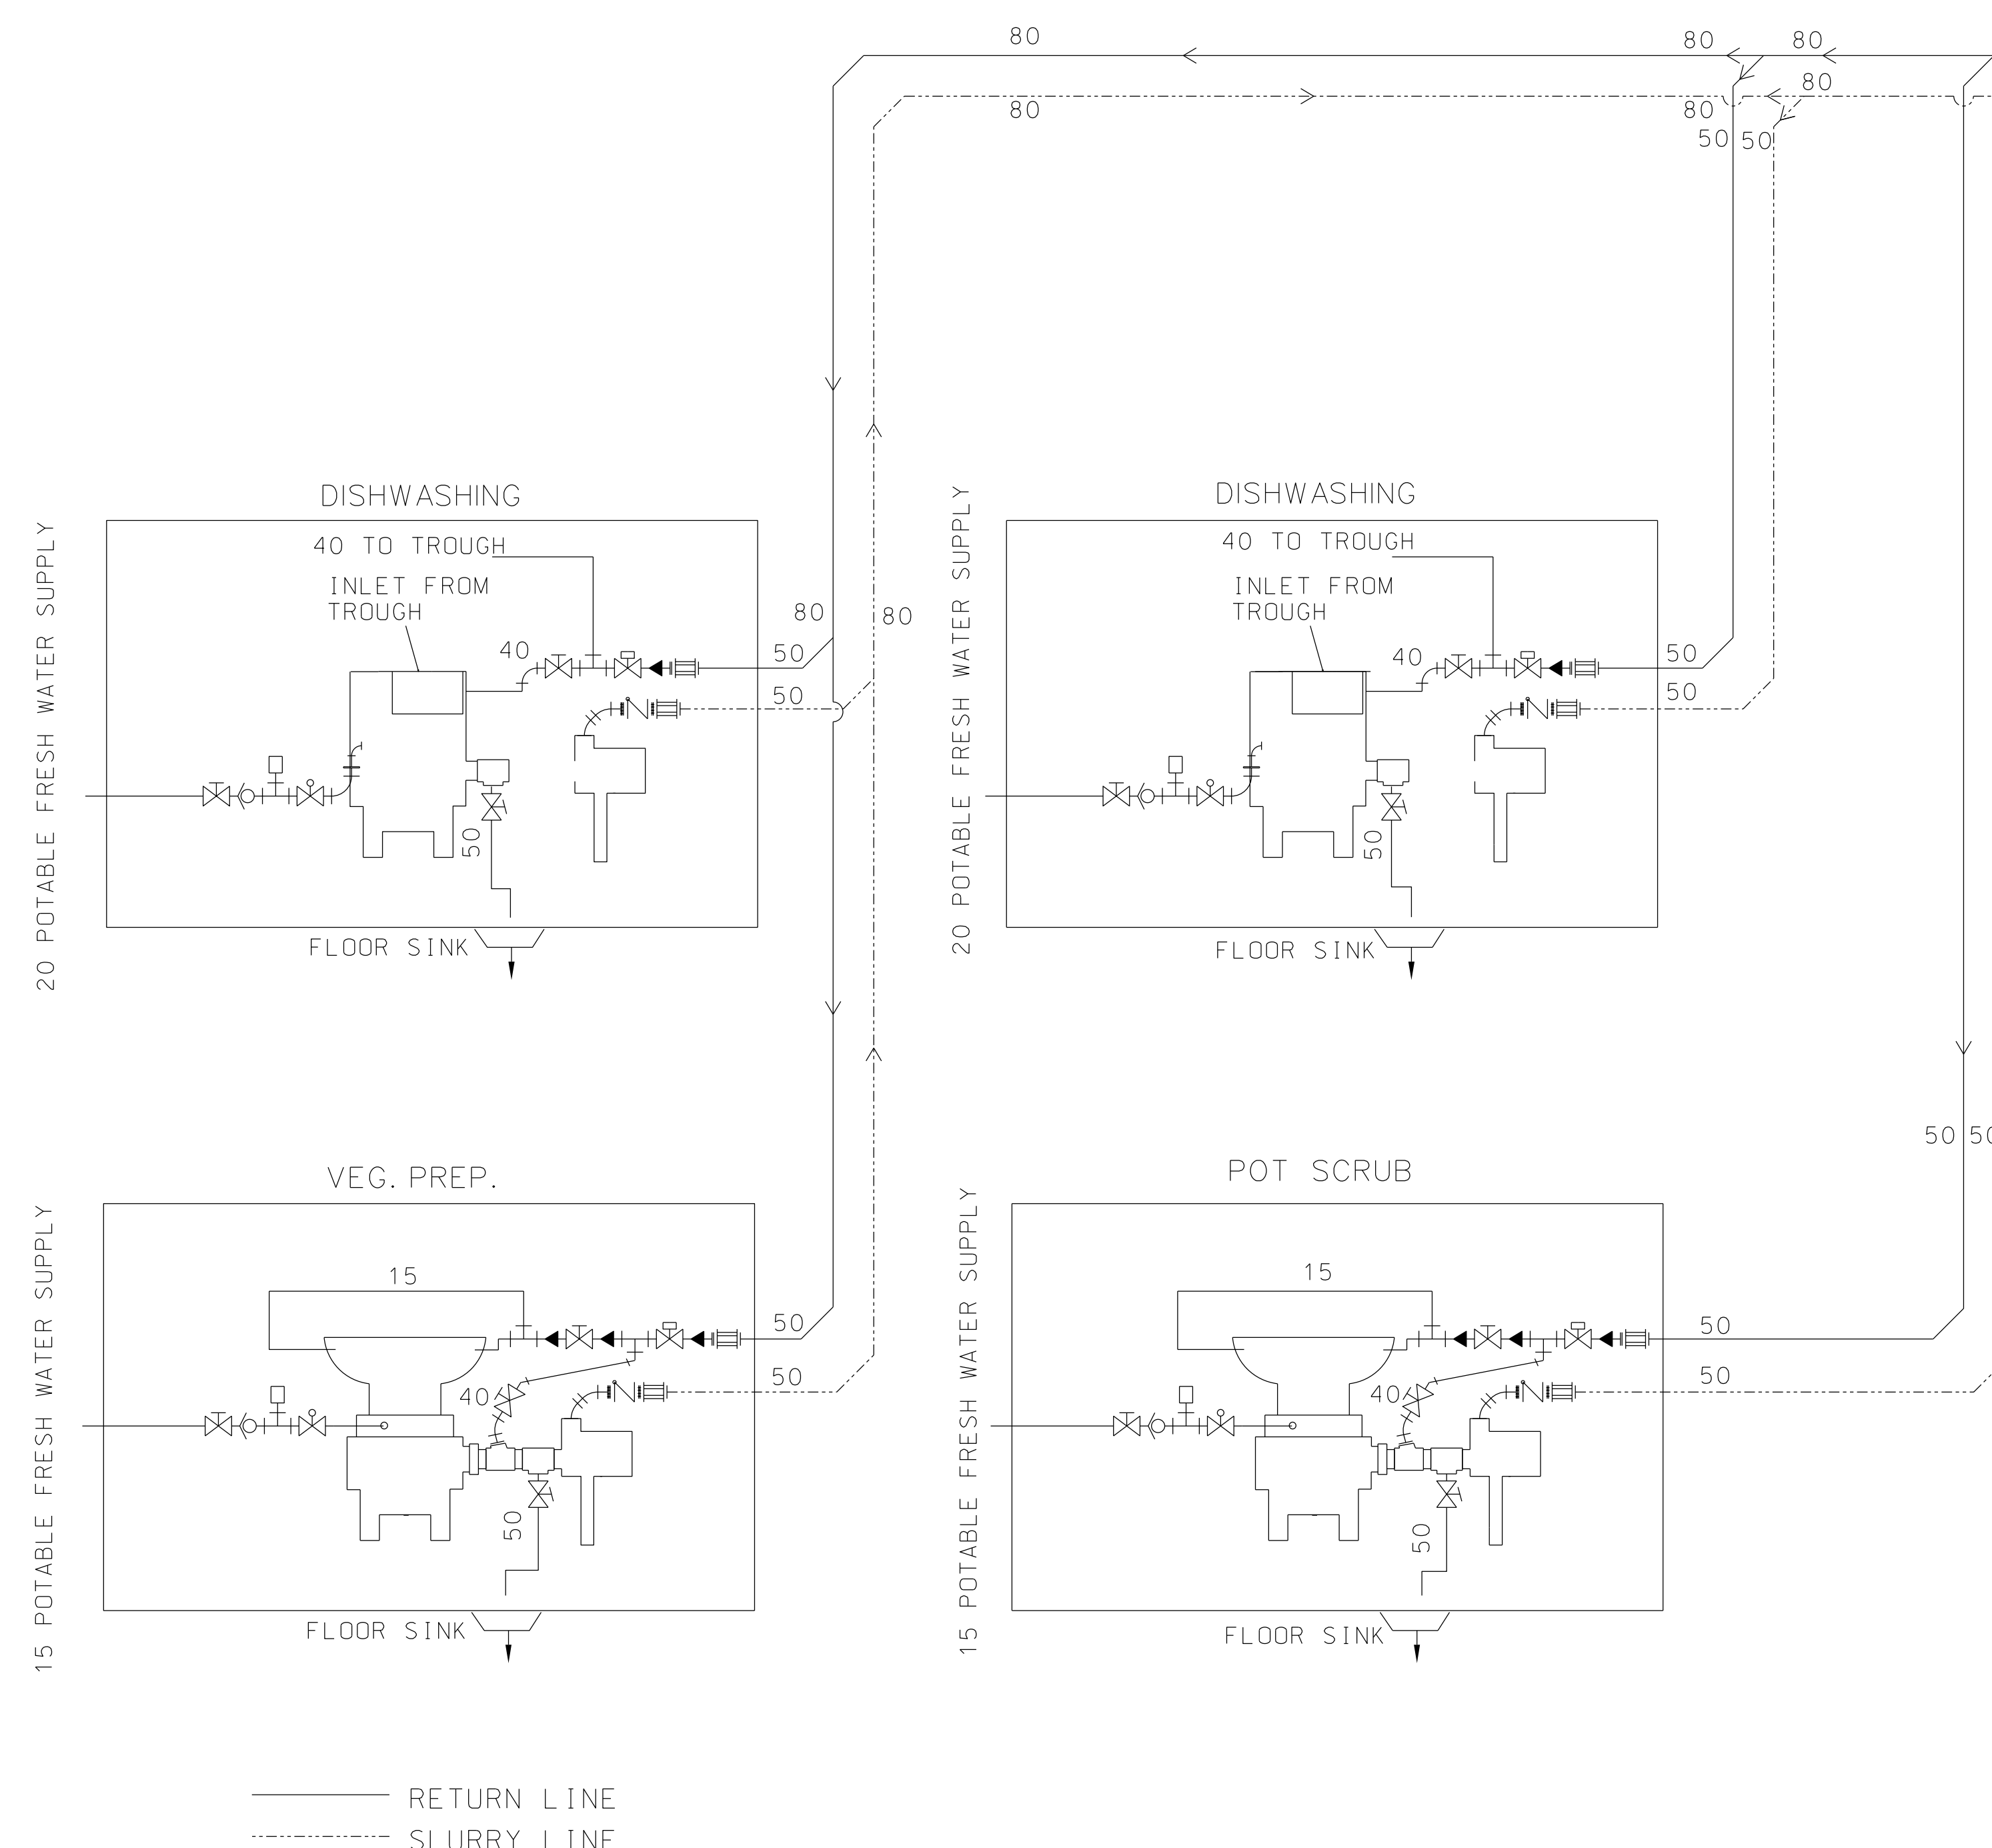

WASTE PULPING SYSTEM PIPING SCHEMATIC

13 NOT TO SCALE

GENERAL NOTE: PIPING, VALVES AND ASSOCIATED DEVICES SHOWN ARE THE MINIMUM REQUIRED TO PERFORM THE SPECIFIED FUNCTION. ALTERNATE PIPING ARRANGEMENTS ARE ACCEPTABLE.

PIPING LEGEND

- | | | | |
|---|-----------------------------------|---|--|
|  | ADDITIVE PUMP |  | UNION COUPLING |
|  | DOUBLE CHECK
BACKFLOW ASSEMBLY |  | PIPE FLANGE |
|  | CHECK VALVE -FLANGED, SWING TYPE |  | SHOCK ARRESTOR (SIZED BY MANUFACTURER) |
|  | DRAIN VALVE |  | MOTORIZED VALVE |
|  | FLEXIBLE CONNECTOR -FLANGED |  | BELT DRIVE RETURN PUMP |
|  | SHUT-OFF VALVE |  | SOLENOID VALVE |
|  | THROTTLING VALVE | | |
|  | REDUCER | | |
|  | COUPLING | | |



US ARMY CORPS
OF ENGINEERS
SAVANNAH DISTRICT

DATE: 14JUL97	REV.
CATEGORY CODE 721-11-11	
SOLICITATION NO: DACA21-97-B-0055	
PLOT DATE: \$\$\$DATE\$\$\$	
PLOT SCAF: :	

U.S. ARMY ENGINEER DISTRICT
CORPS OF ENGINEERS
SAVANNAH, GEORGIA

[illegible]

INGER BARRACKS COMPLEX
FORT BENNING, GEORGIA

DINING FACILITY

PLATE
REFERENCE
NUMBER:

MP-9

SHEET 353