
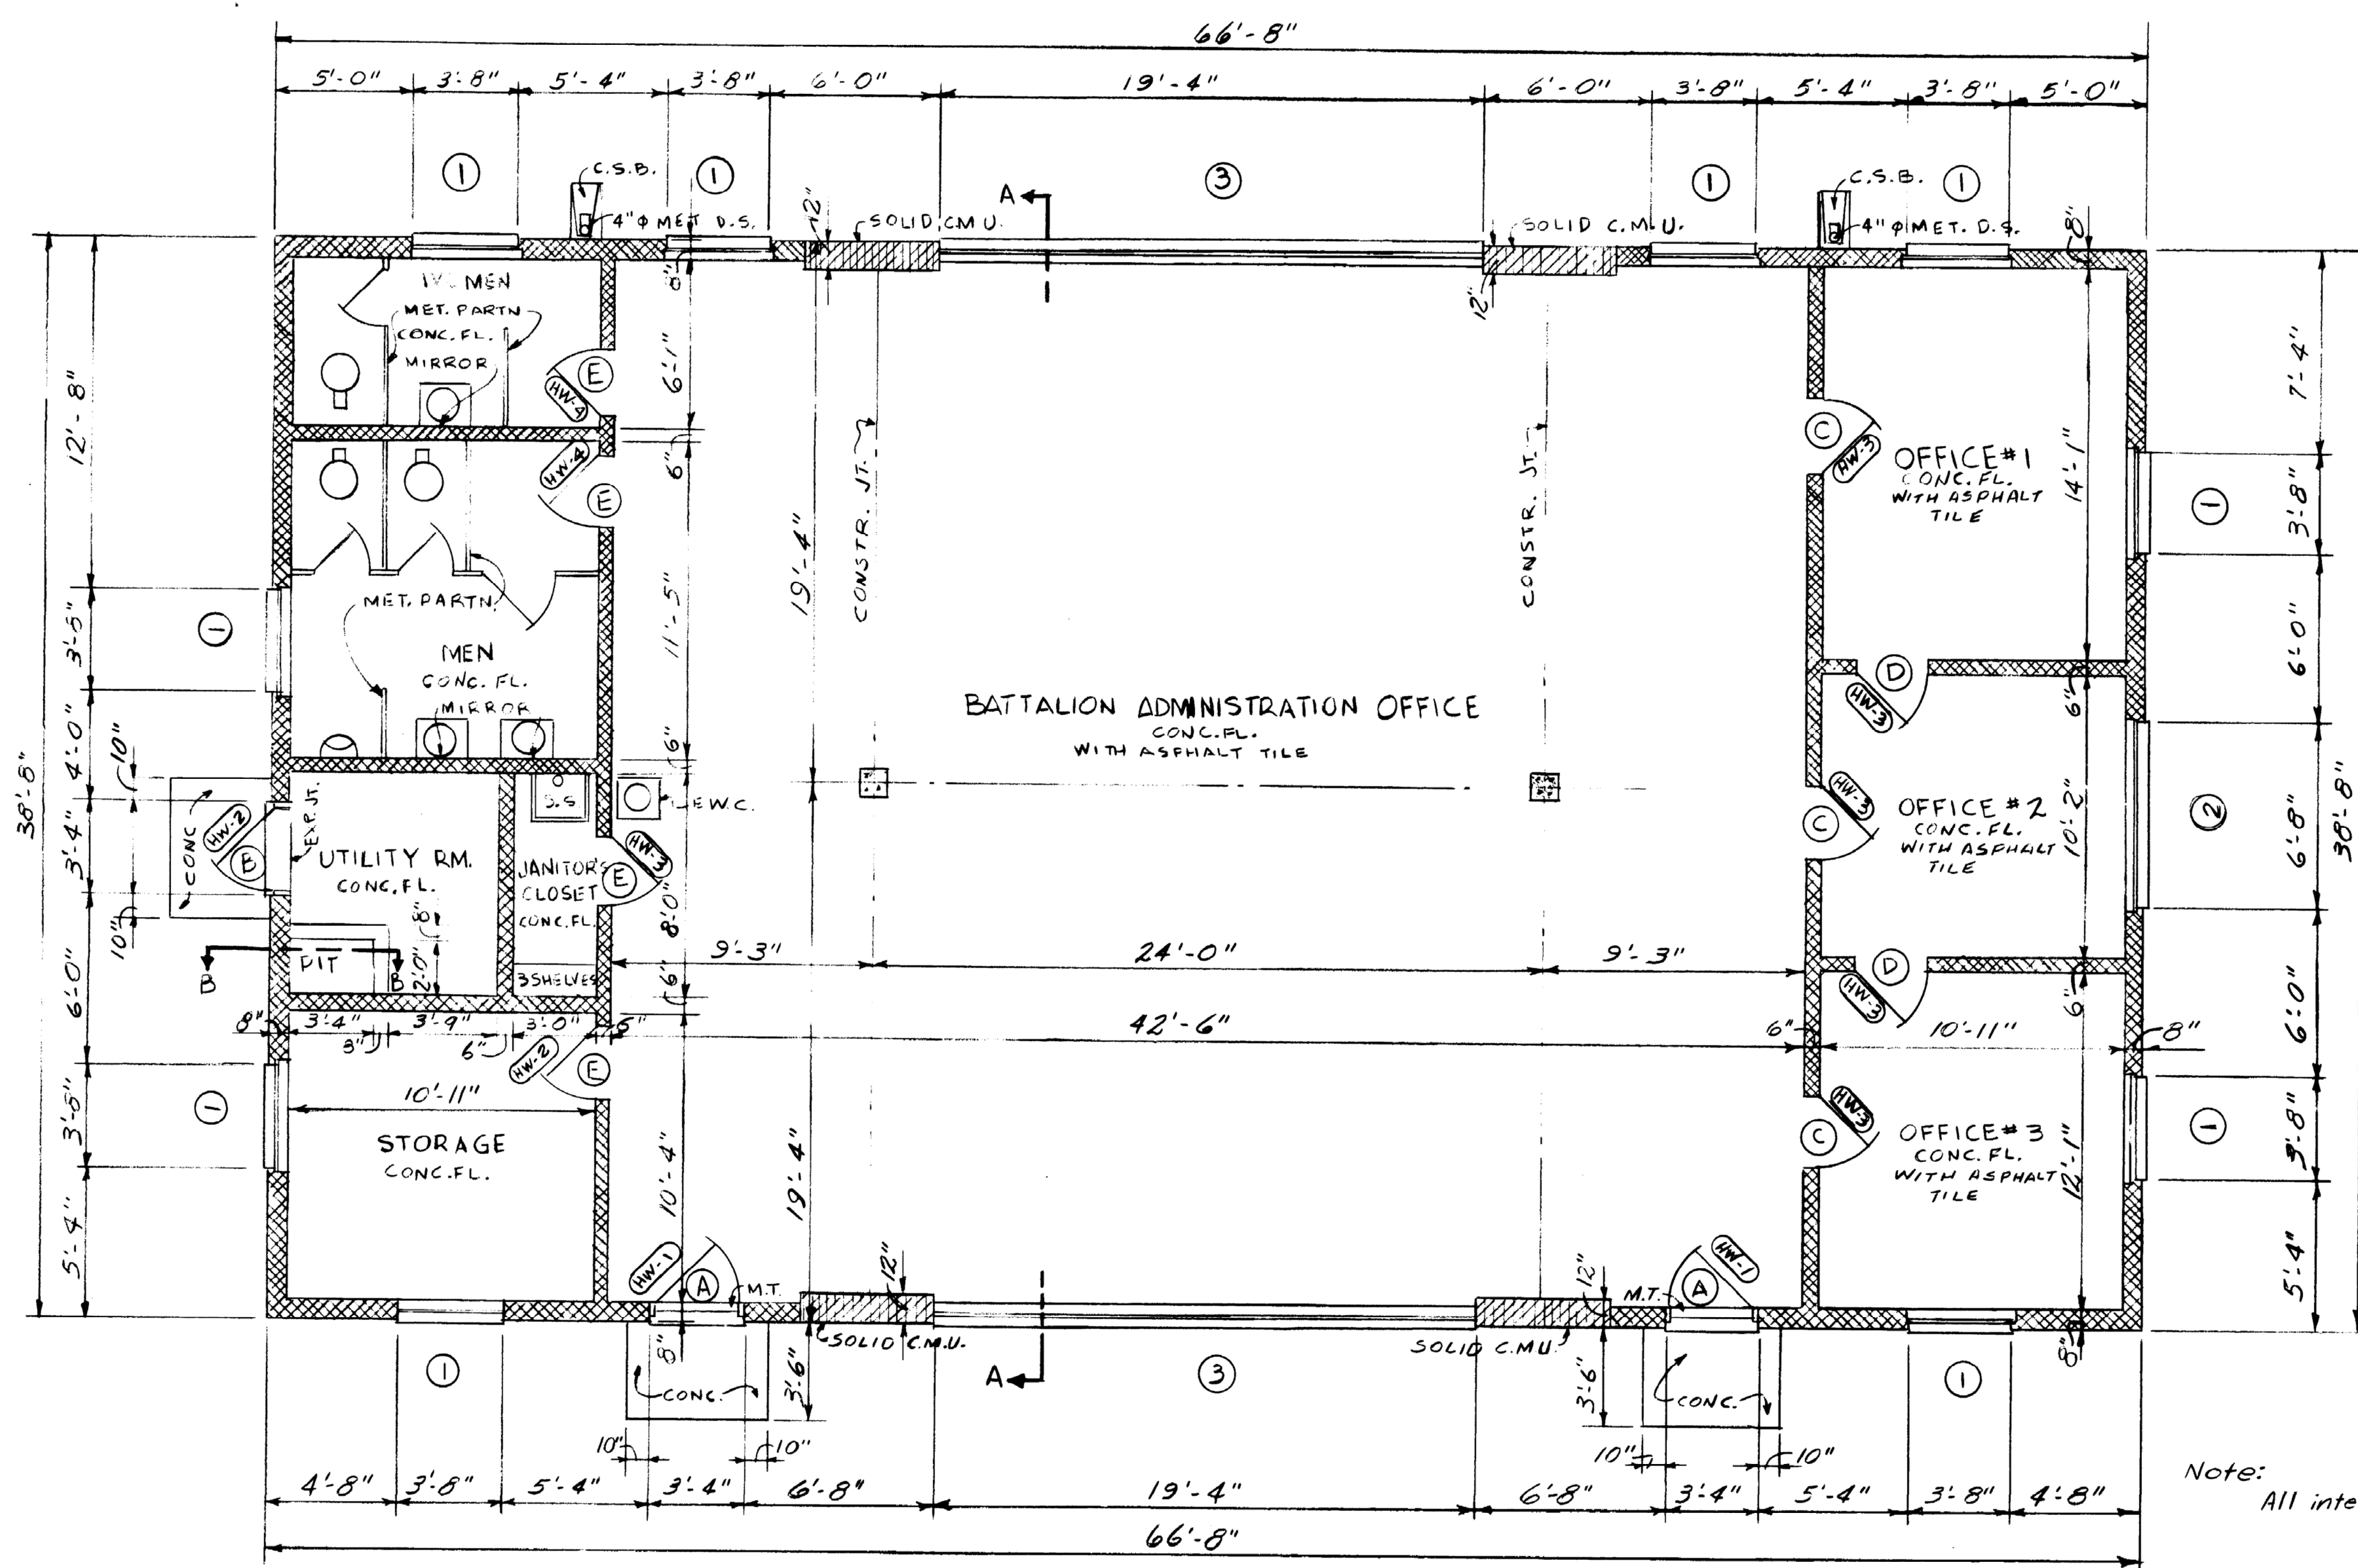


Note:
Added metal grilles over Vent openings.

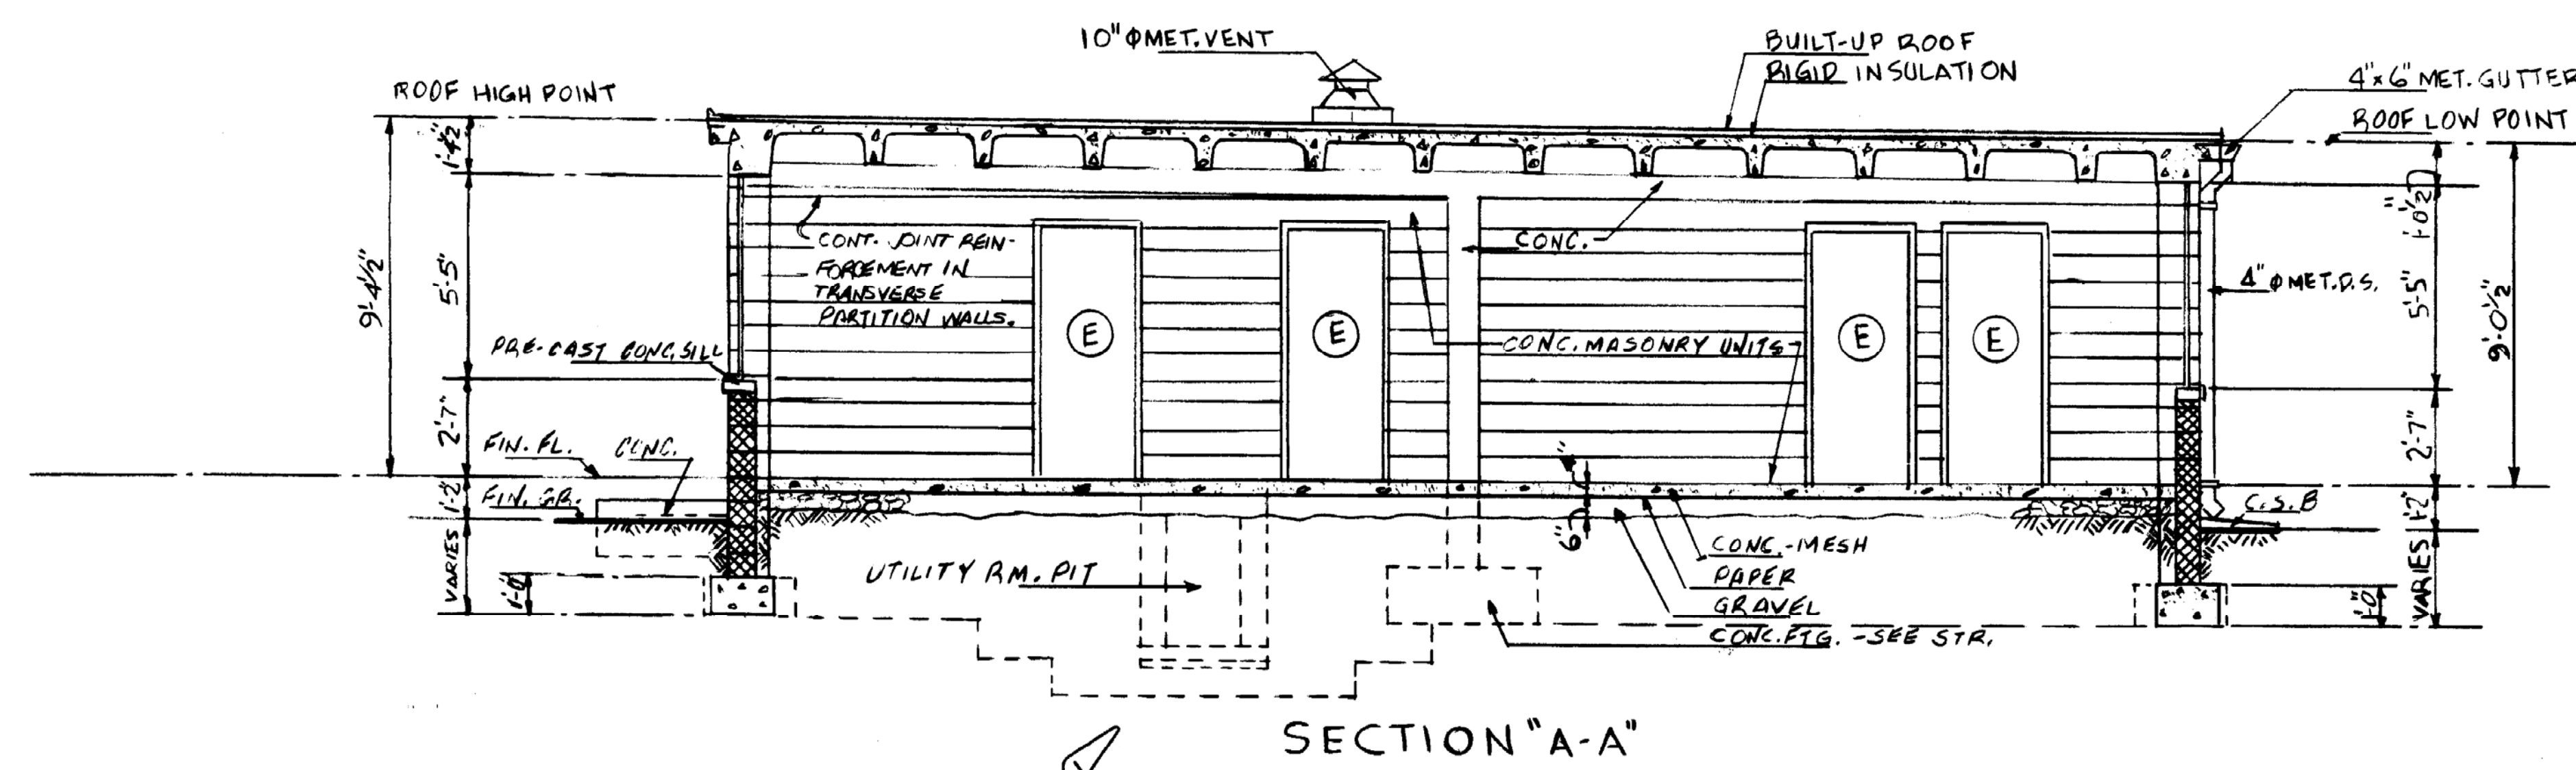

FLOOR PLAN

Note: For Wall Sections see Sheet No. 5


NOTE: WINDOW MASONRY OFNG. DIM. ARE NOMINAL.
ALL EXPOSED VERTICAL CORNERS INCLUDING WINDOW
& DOOR JAMBS SHALL BE OF BULL-NOSE BLOCK.

Note: All interior Partitions shall be 6"


ABBREVIATIONS

ARCH. DWG. = ARCHITECTURAL DRAWING	GR. = GRADE
COL. = COLUMN	INS. = INSULATION
C.M.U. = CONCRETE MASONRY UNITS	MET. = METAL
CONC. = CONCRETE	MIN. = MINIMUM
CONT. = CONTINUOUS	M.O. = MASONRY OPENING
C.S.B. = CONCRETE SPLASH BLOCK	M.T. = METAL THRESHOLD
DET. = DETAIL	NOM. = NOMINAL
DIM. = DIMENSION	OPNG. = OPENING
D.S. = DOWN SPOUT	PTN. = PARTITION
E.W.C. = ELECTRIC WATER COOLER	RAD. = RADIATOR
EXP. JT. = EXPANSION JOINT	REINF. = REINFORCING
EXT. = EXTERIOR	RM. = ROOM
FDN. = FOUNDATION	S.S. = SERVICE SINK
FIN. = FINISH	STR. = STRUCTURAL
FL. = FLOOR	SQ. = SQUARE
FTG. = FOOTING	WD. = WOOD
GA. = GAGE	P.S.I. = POUNDS PER SQUARE INCH

WINDOW SCHEDULE

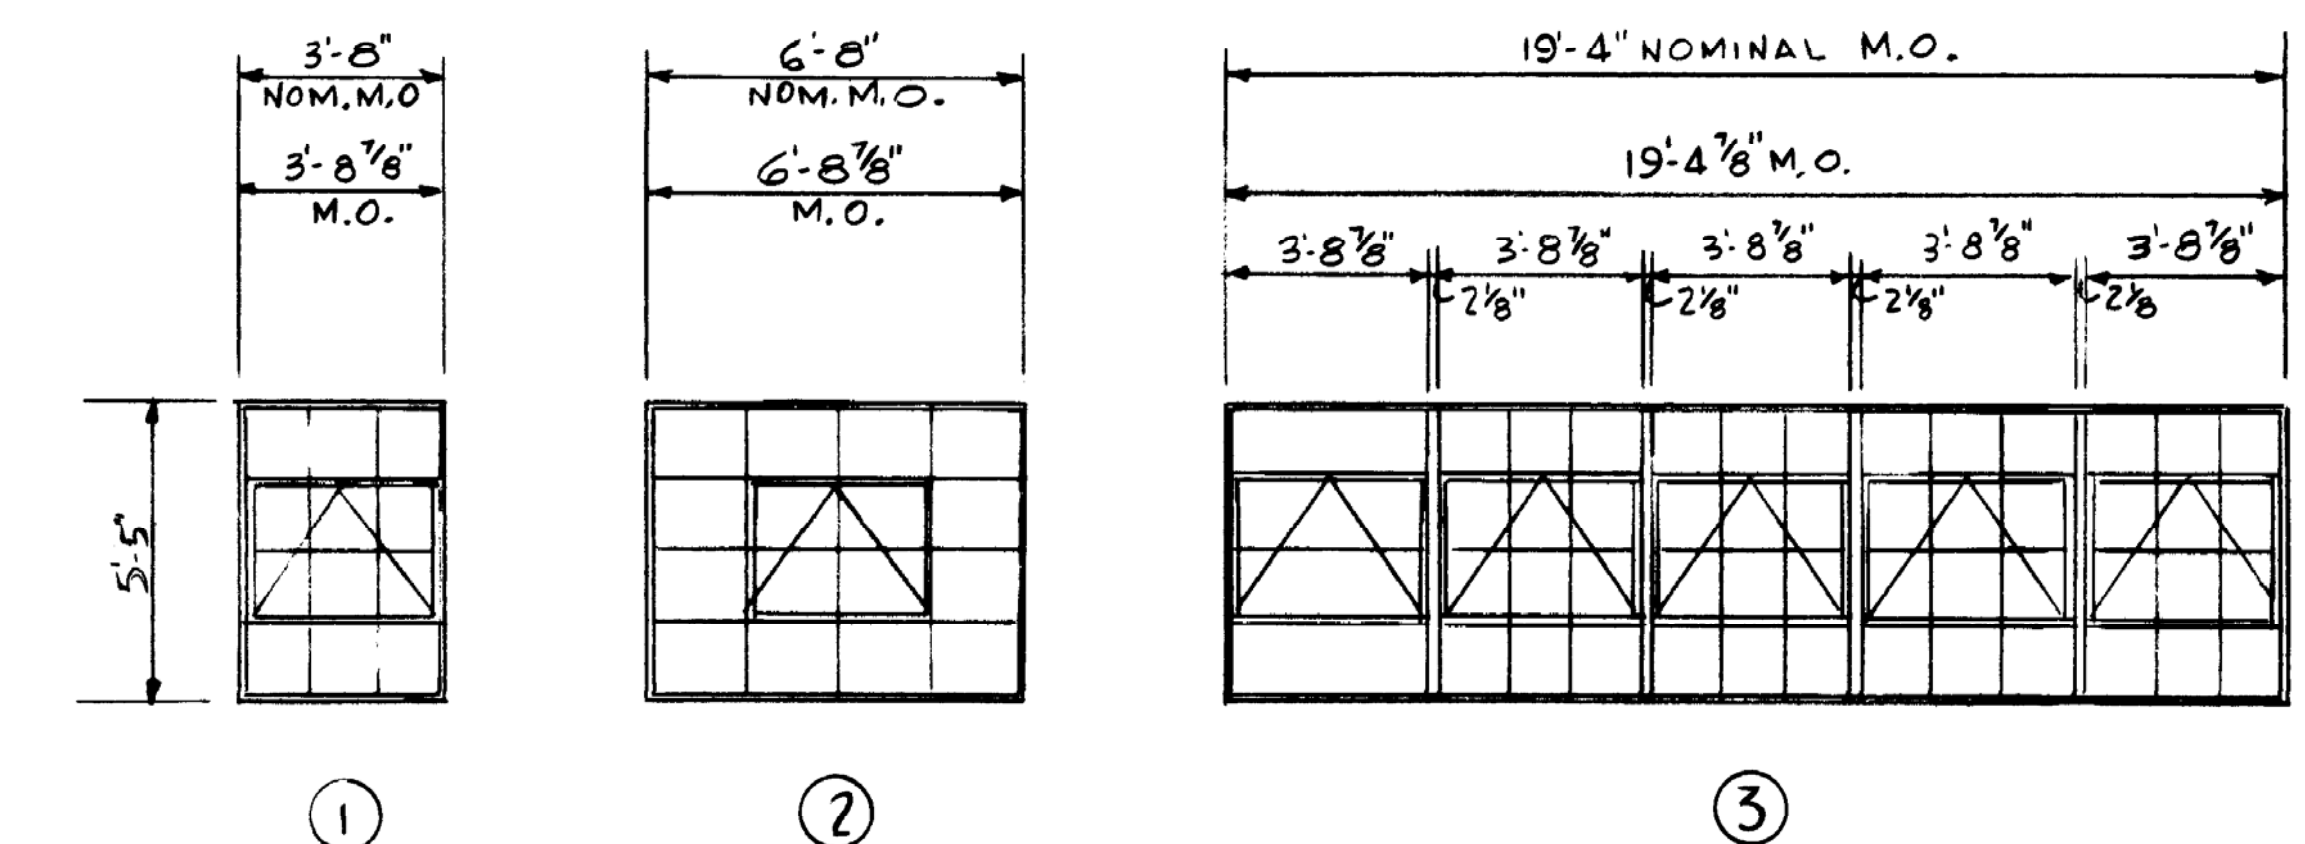

DOOR SCHEDULE

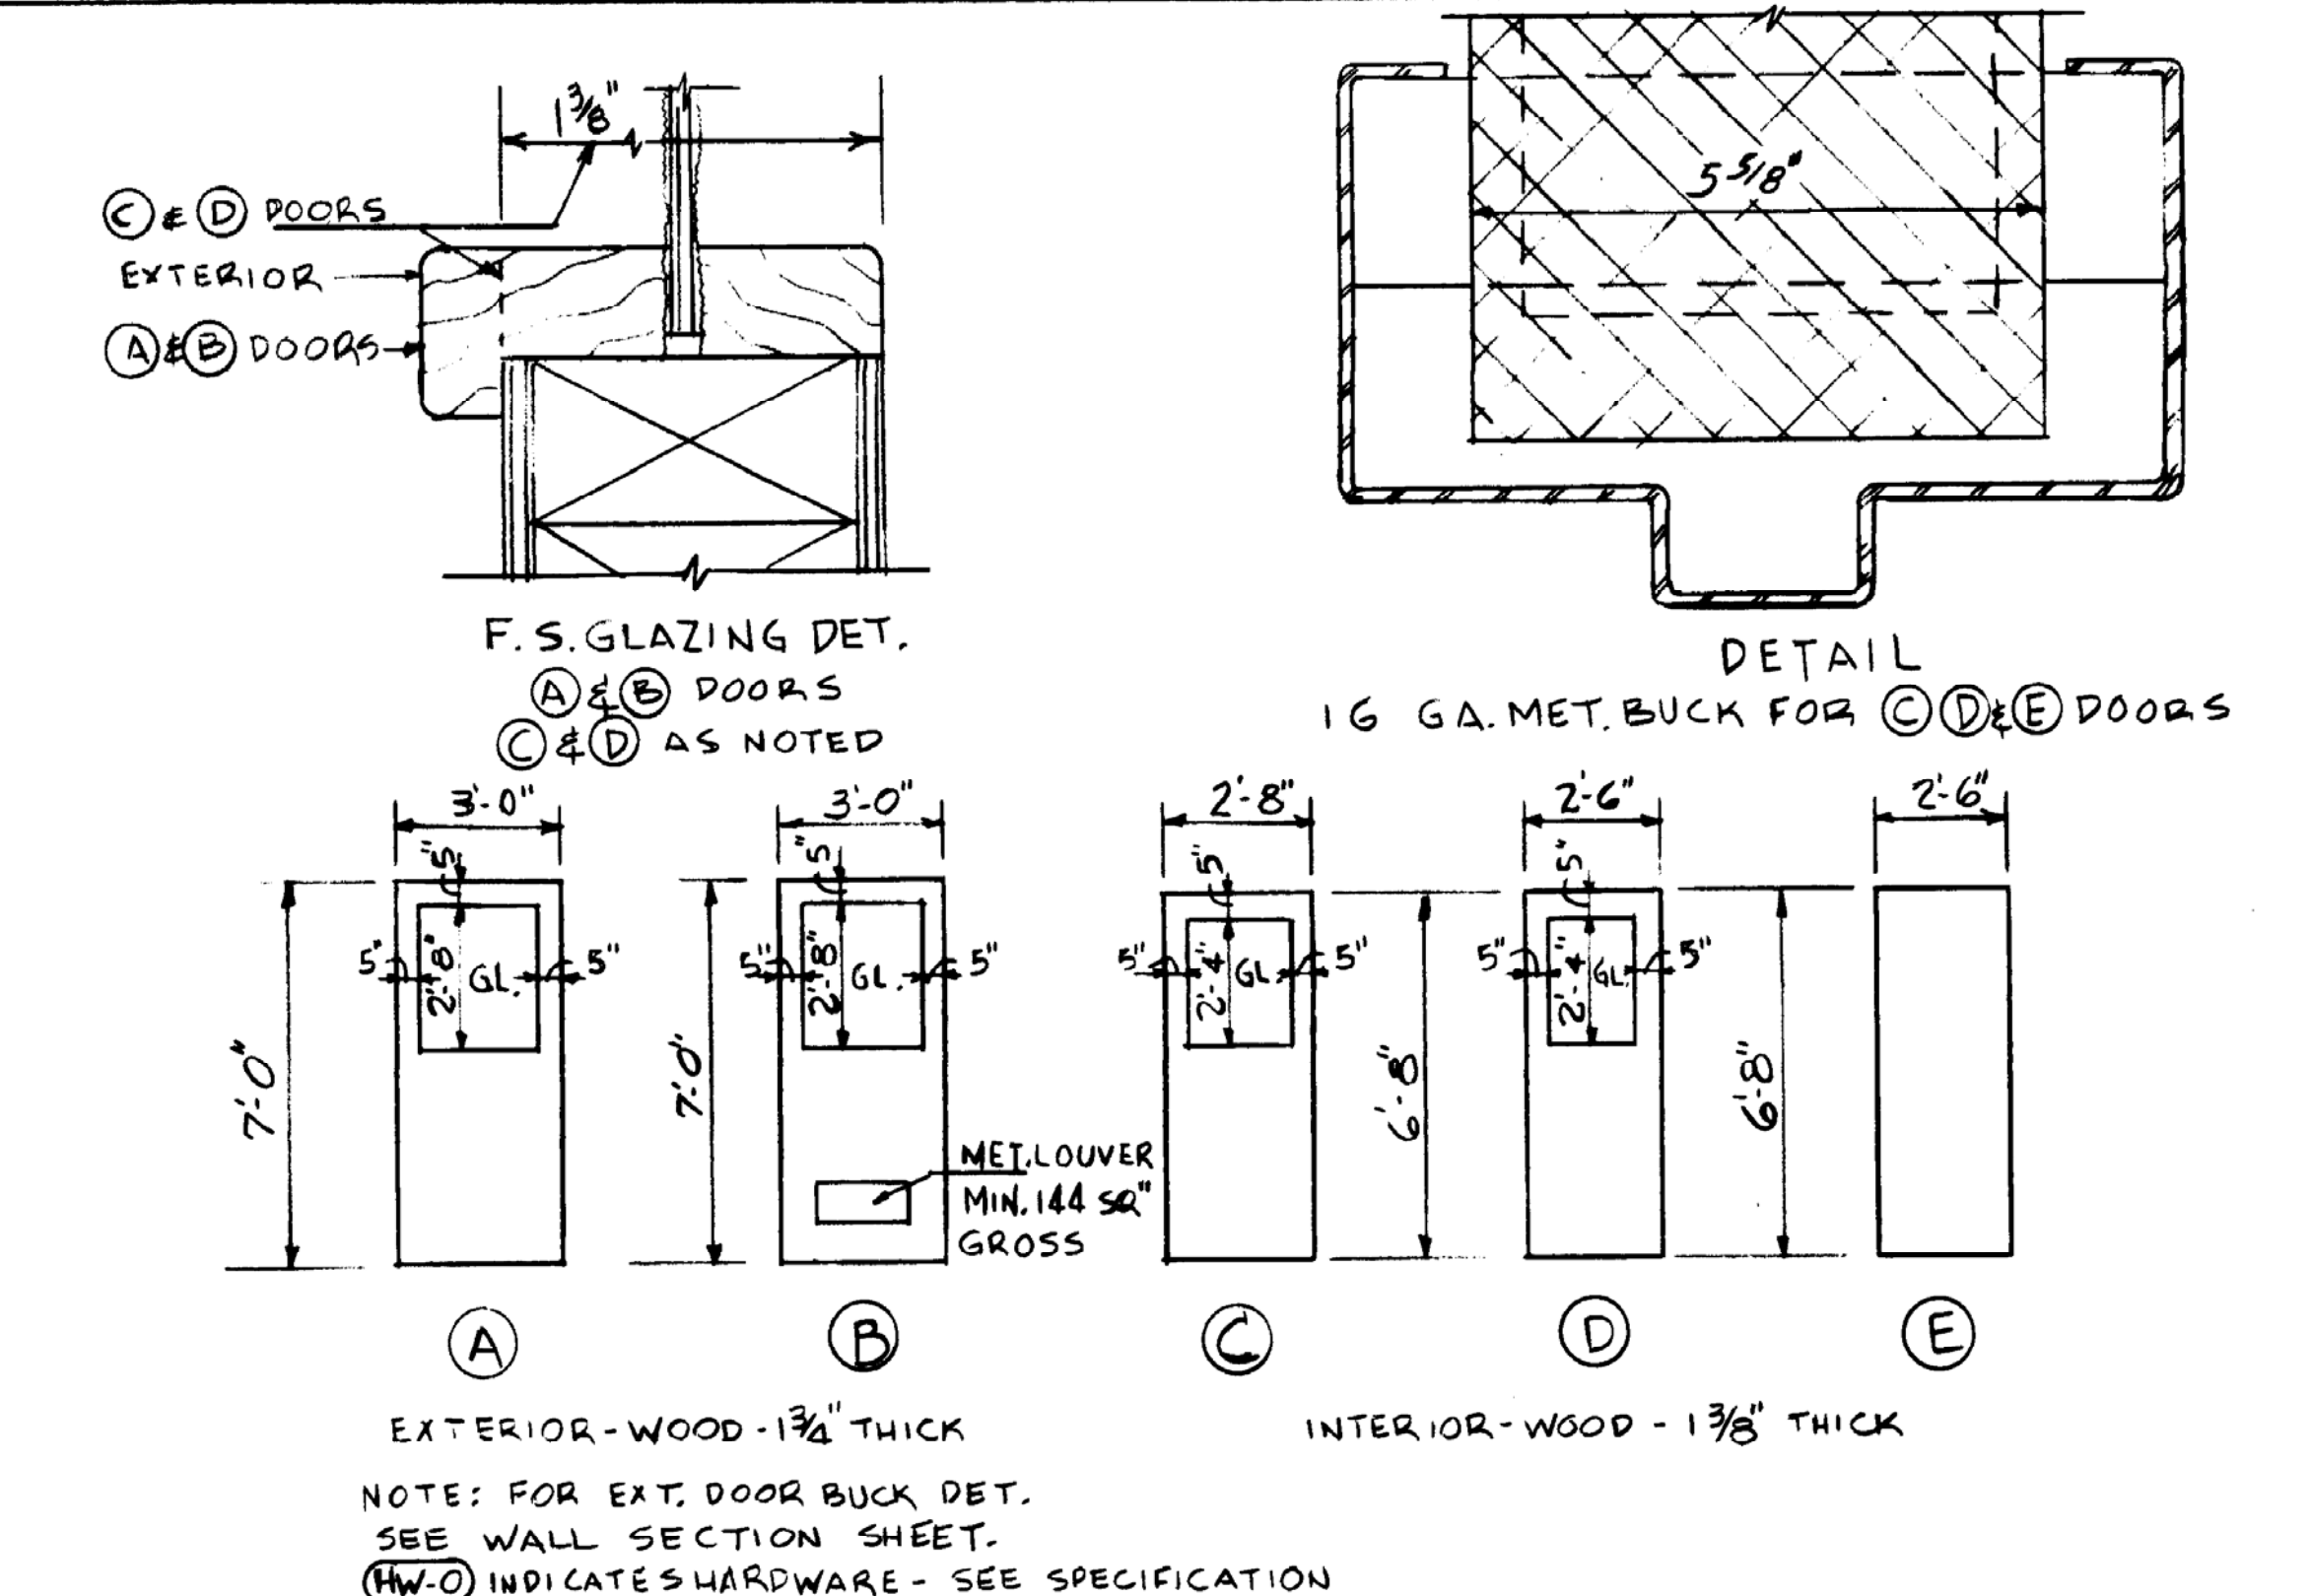

SYMBOLS

BRICK
CONC. MASONRY UNITS - HOLLOW
CONC. MASONRY UNITS - SOLID
CONCRETE
PRE-CAST CONCRETE
STEEL
WOOD
INSULATION

AREA & CUBAGE

GROSS AREA
66.67 x 38.67 = 2578.13 SQ. FT.

CUBIC CONTENTS
2578.13 x 9.542 = 24,600.52 CU. FT.
PIT - 2 x 3 x 4.33 = 25.98 CU. FT.
24,626.50 CU. FT.

Revised as built.	6-25-54	H.L.B.
Utilities Pit Revised Note Added	5-28-53	M.E.
ADAPTED BY SAVANNAH DIST. FOR FT. BENNING	15 APR 53	J.P.
SYMBOL	DESCRIPTION	DATE
REVISIONS		
BERLA & ABEL	ARCHITECTS - ENGINEERS	DEPARTMENT OF THE ARMY
1638 CONNECTICUT AVE.	WASHINGTON, D. C.	OFFICE OF THE CHIEF OF ENGINEERS
		MILITARY CONSTRUCTION - ENGINEERING DIVISION
		WASHINGTON, D. C.

HEADQUARTERS BUILDING - BATTALION

FLOOR PLAN WINDOW & DOOR SCHEDULES

DATE	30 DEC 1952
SCALE	1/4" = 1'-0"
SPEC. NO.	30-02-44-57-53
DRAWING NUMBER	30-02-44
SHEET	2 OF 2